

PLAT AND RECORD


Of a Survey on Section 172 T1N R10 E. of the 4 P. M. in AVON Township

Rock County, Wisconsin, made AUGUST the 24 1957

I hereby certify that the following is a correct record of said survey as made by me.

COUNTY BUILDING
IN CITY OF BELOIT

County Surveyor.

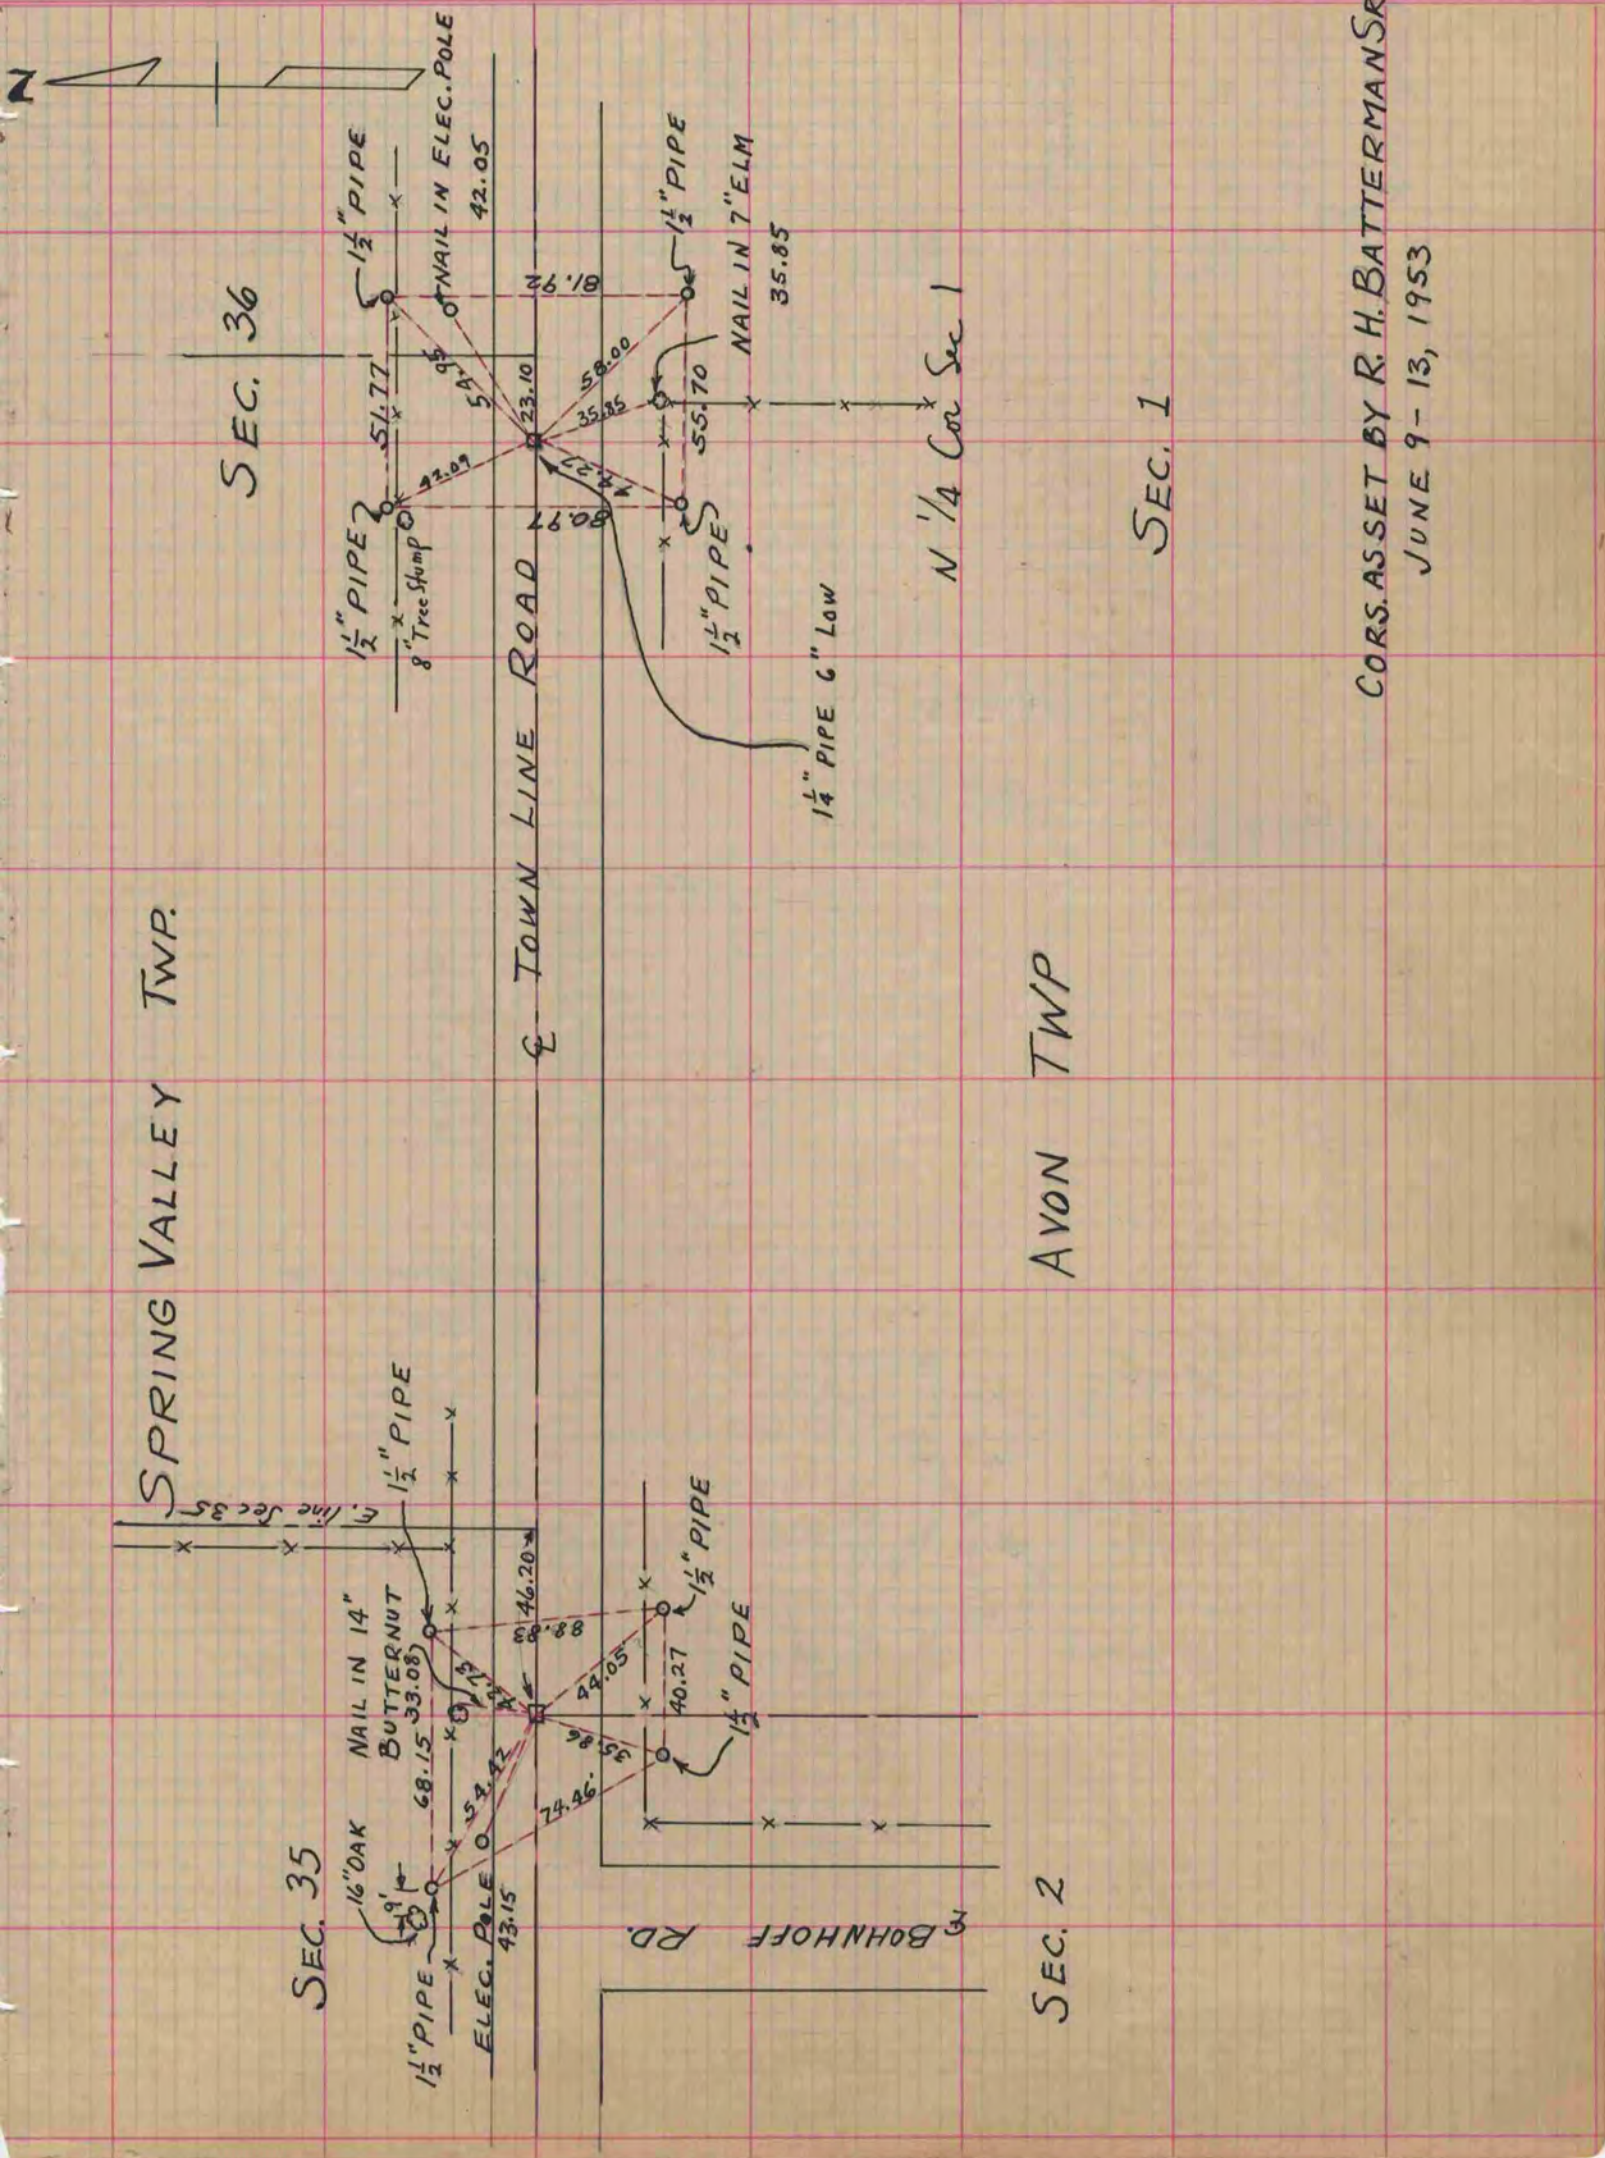

CORS. ASSET BY R. H. BATTERMAN SR.
JUNE 9-13, 1953