

# PLAT AND RECORD


Of a Survey on Section 3 T 2 R 10 E. of the 4 P. M. in Spring Valley Township  
Rock County, Wisconsin, made January the 4<sup>th</sup> 1861

I hereby certify that the following is a correct record of said survey as made by me.

COUNTY BUILDING  
IN CITY OF БЕЛОIT

(Signed) Edward Ruger.  
ERM

EDWARD RUGER  
County Surveyor.

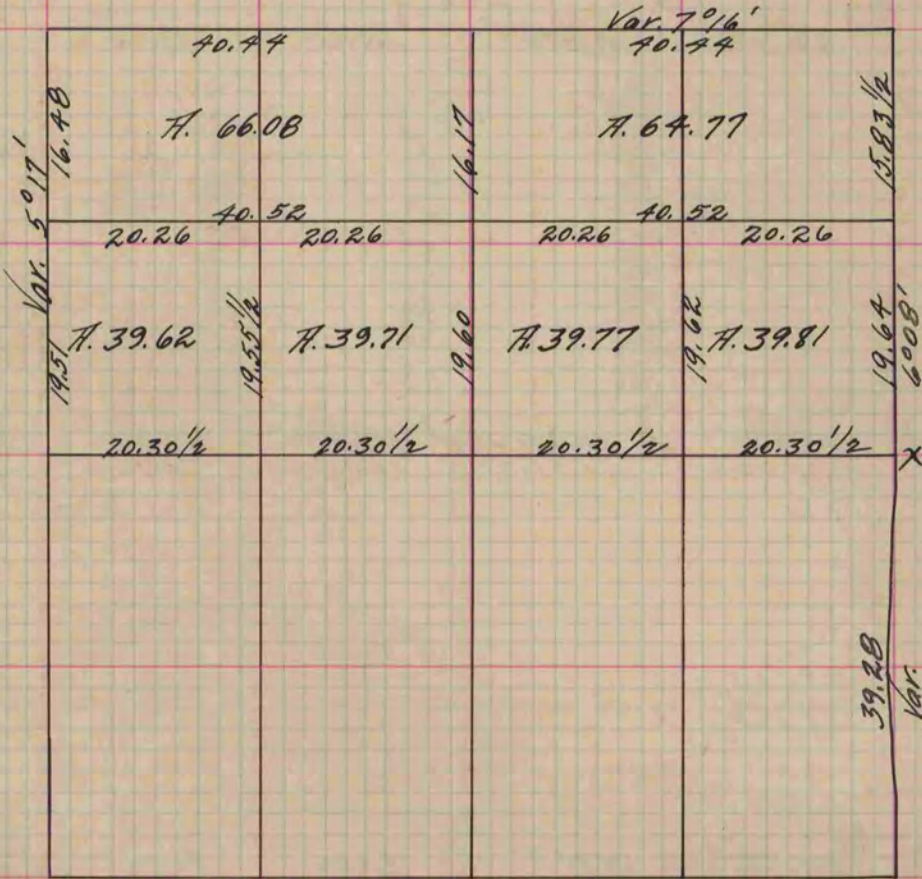

X The East quarter post being gone put it in from Sec. Corners.

Copied from Page 159 Vol. 1. Original County Surveyors Record.