

# PLAT AND RECORD

Of a Survey on Section 19 T 1 R 10 E. of the 4 P. M. in Avon Township

Rock County, Wisconsin, made April the 28th 19 72

I hereby certify that the following is a correct record of said survey as made by me.

COUNTY BUILDING  
IN CITY OF BELOIT


*Hugh J. De...*  
County Surveyor.

At N<sup>1</sup>/<sub>4</sub> Cor. Sec. 19-1-10  
Avon Twp, Set C.I. Mon.  
4/28/72 M.L. & TP

At N.W. Cor. Sec.  
19-1-10 Ref. Set  
C.I. Mon. 6/6/72  
M.L.  
G.B.

SET C.I. Mon.  
6-6-72  
M.L. G.B.  
Bk 163/17

AT S.W. COR. SEC. 19-1-10  
AVON TWP. SET C.I. MON.  
4-28-72 M.L. & T.M.

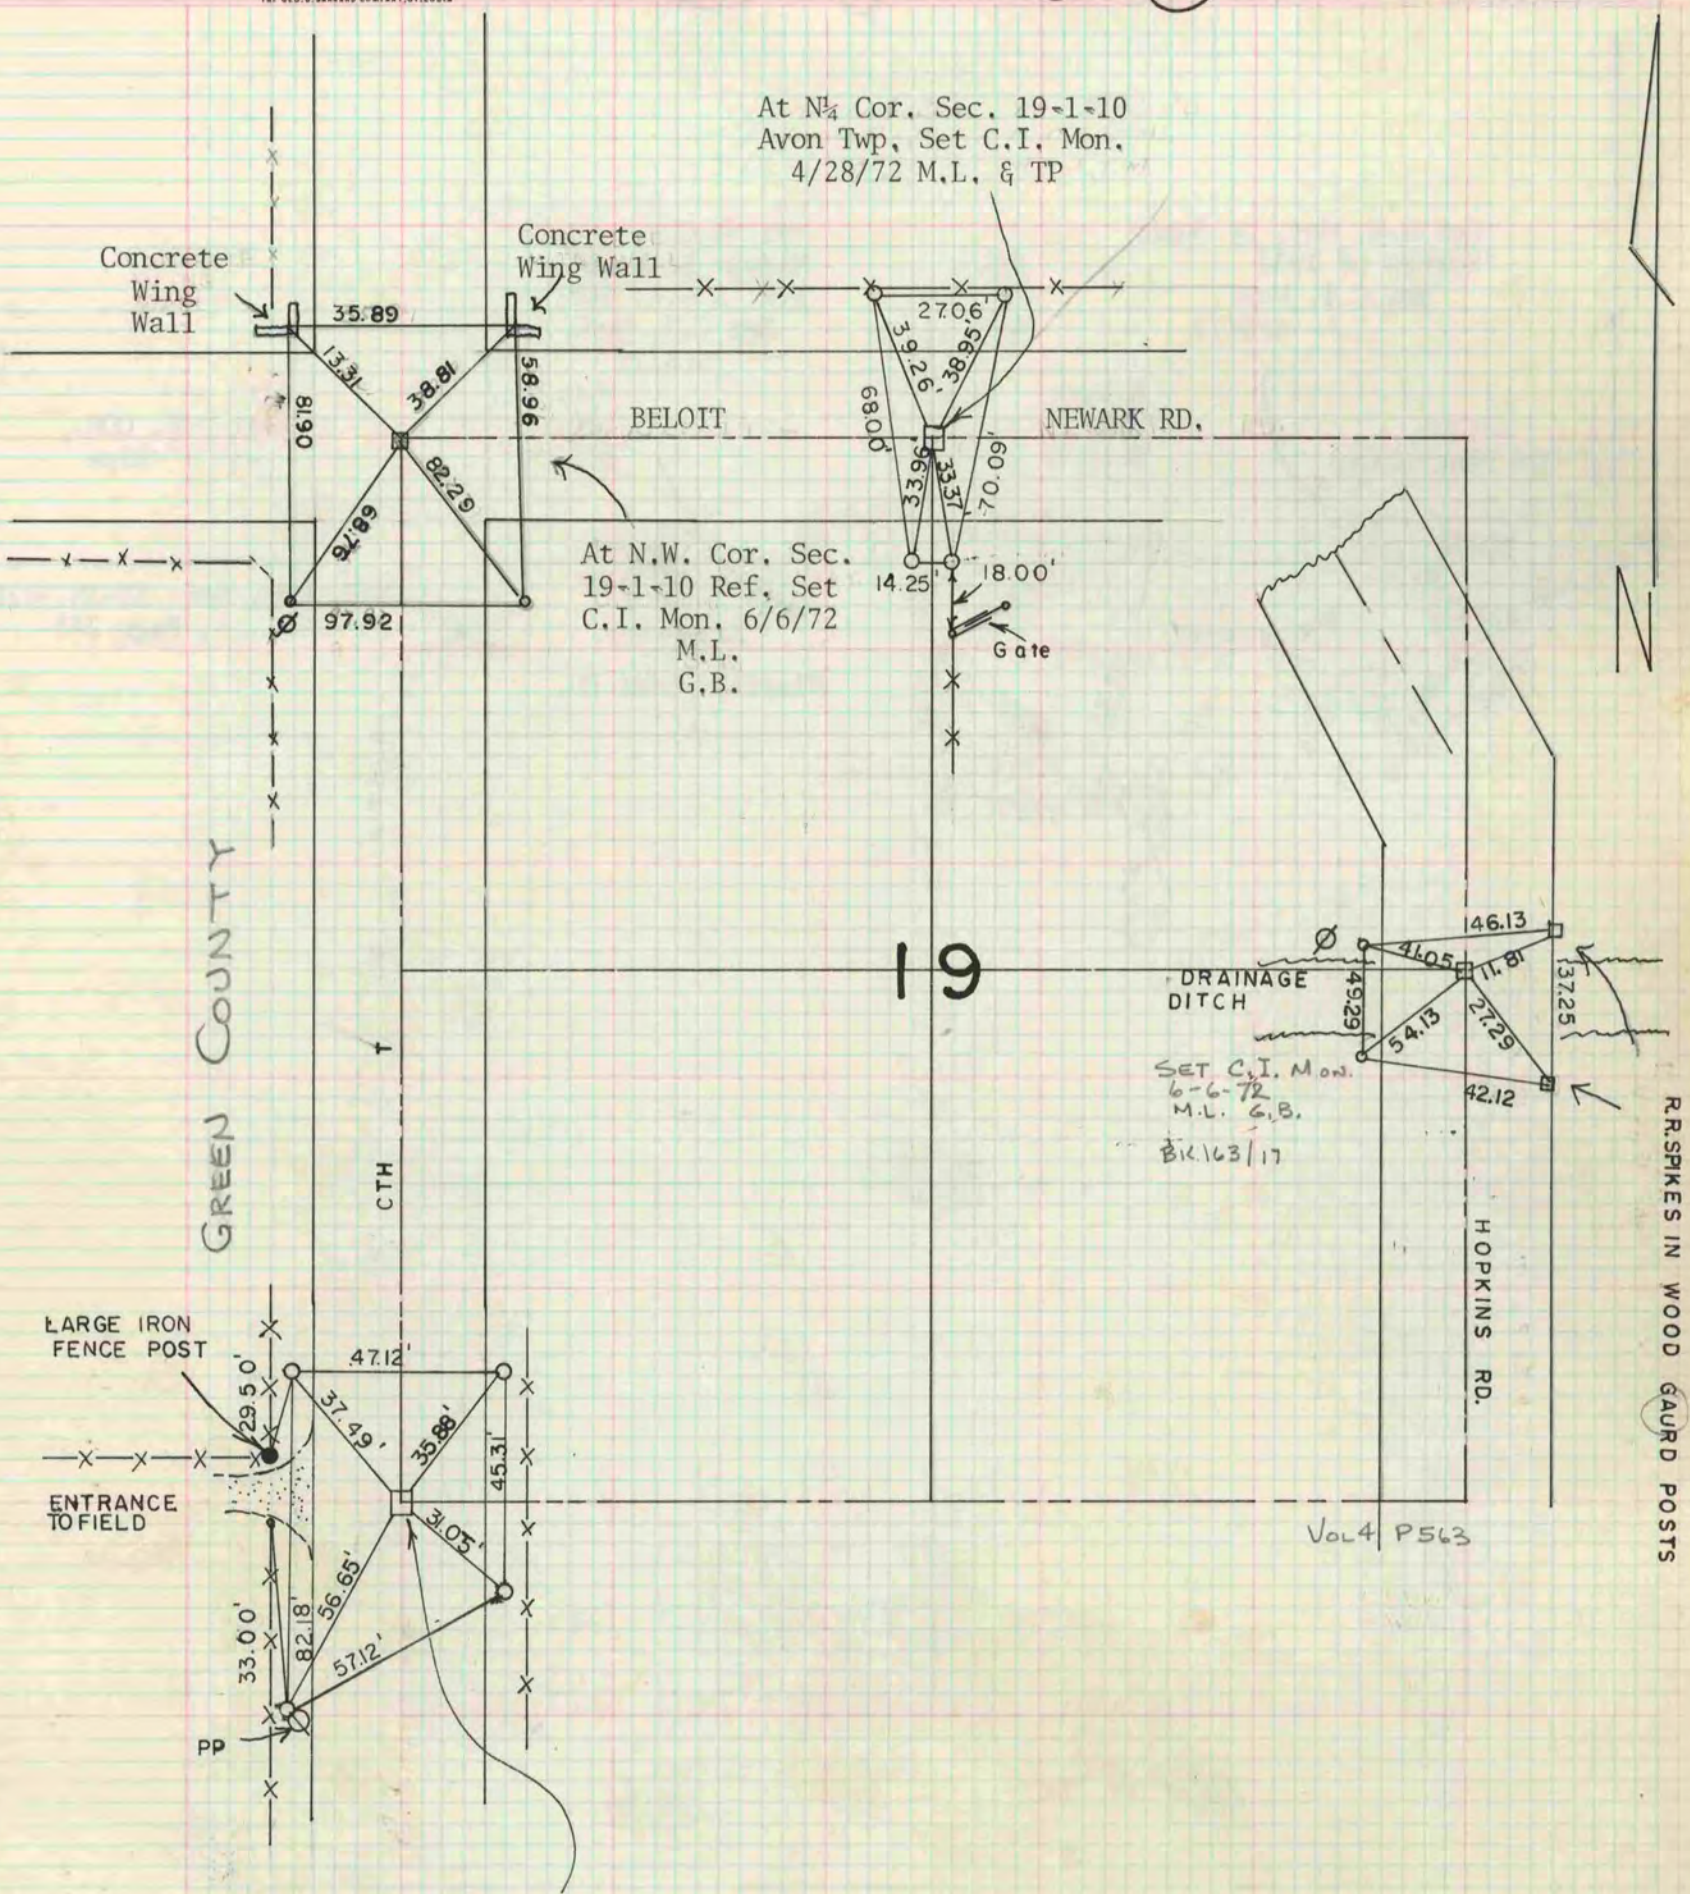

COUNTY BUILDING  
IN CITY OF BELOIT