

# PLAT AND RECORD


Of a Survey on Section 35 T 5 R 11 E. of the 4 P. M. in Dunkirk Township

Dane County, Wisconsin, made June the 20 1888

I hereby certify that the following is a correct record of said survey as made by me.

COUNTY BUILDING  
IN CITY OF БЕЛОIT

(Signed) R. H. Lee  
RHLB Dep. County Surveyor.

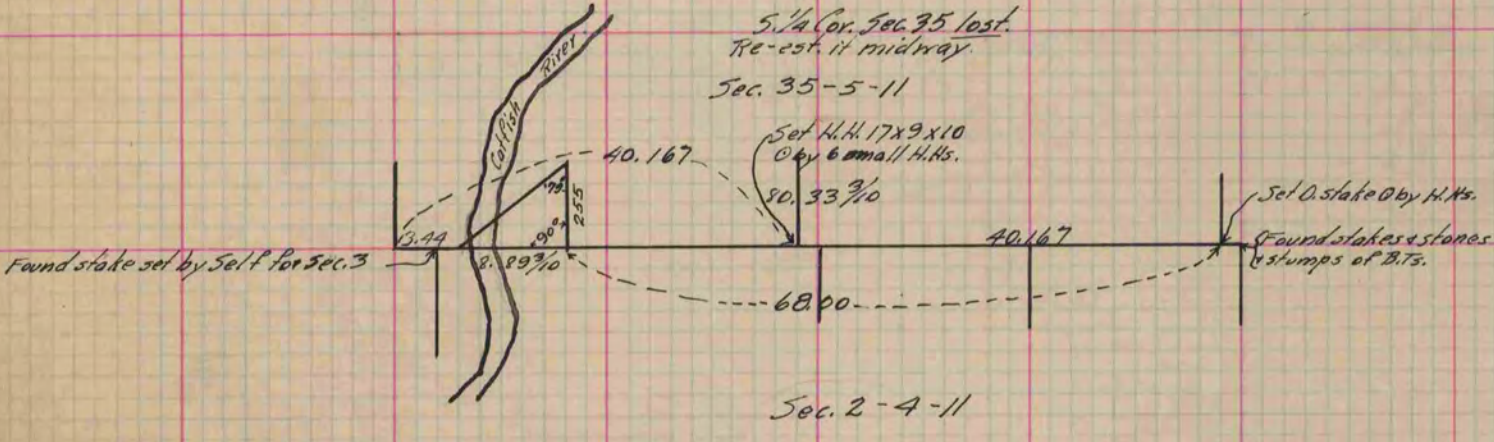

Copied from P. 341 Vol. 2 County Surveyor's Record.