

PLAT AND RECORD

Of a Survey on Section 15 T 2 R 13 E. of the 4 P. M. in LaPrairie Township

Rock County, Wisconsin, made Oct. the 6th 1860


I hereby certify that the following is a correct record of said survey as made by me.

COUNTY BUILDING
IN CITY OF БЕЛОIT

(Signed) *Edward Ruger*

County Surveyor.

The corners on the West side of Sec. 15 are the same as those given on the East side of Sec. 16. opposite page.

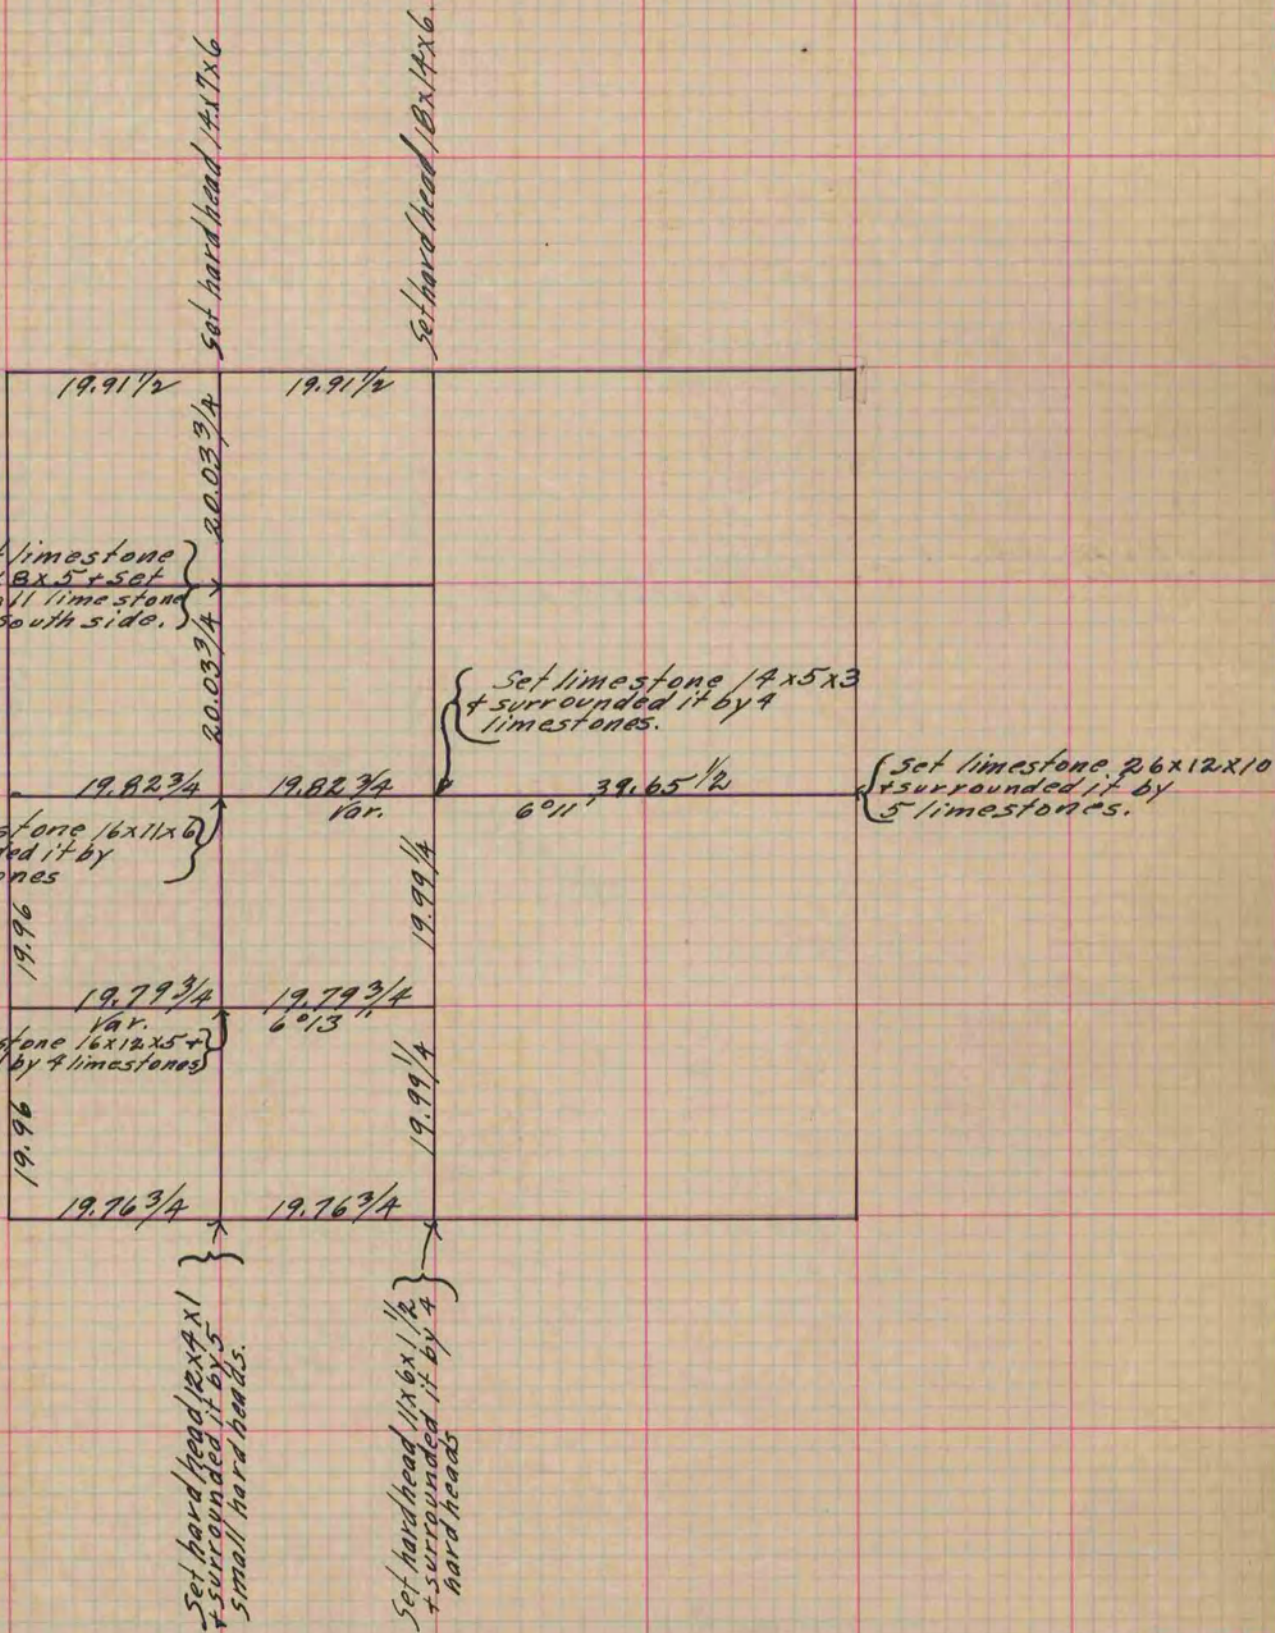

Copied from 150 Vol. 1. Original County Surveyor's Record.