

PLAT AND RECORD

Of a Survey on Section 2 T 1 R 13 E. of the 4 P. M. in Turtle Township


Rock County, Wisconsin, made March the 7th 1861

I hereby certify that the following is a correct record of said survey as made by me.

COUNTY BUILDING
IN CITY OF БЕЛОIT

(Signed) Edward Reger

County Surveyor.

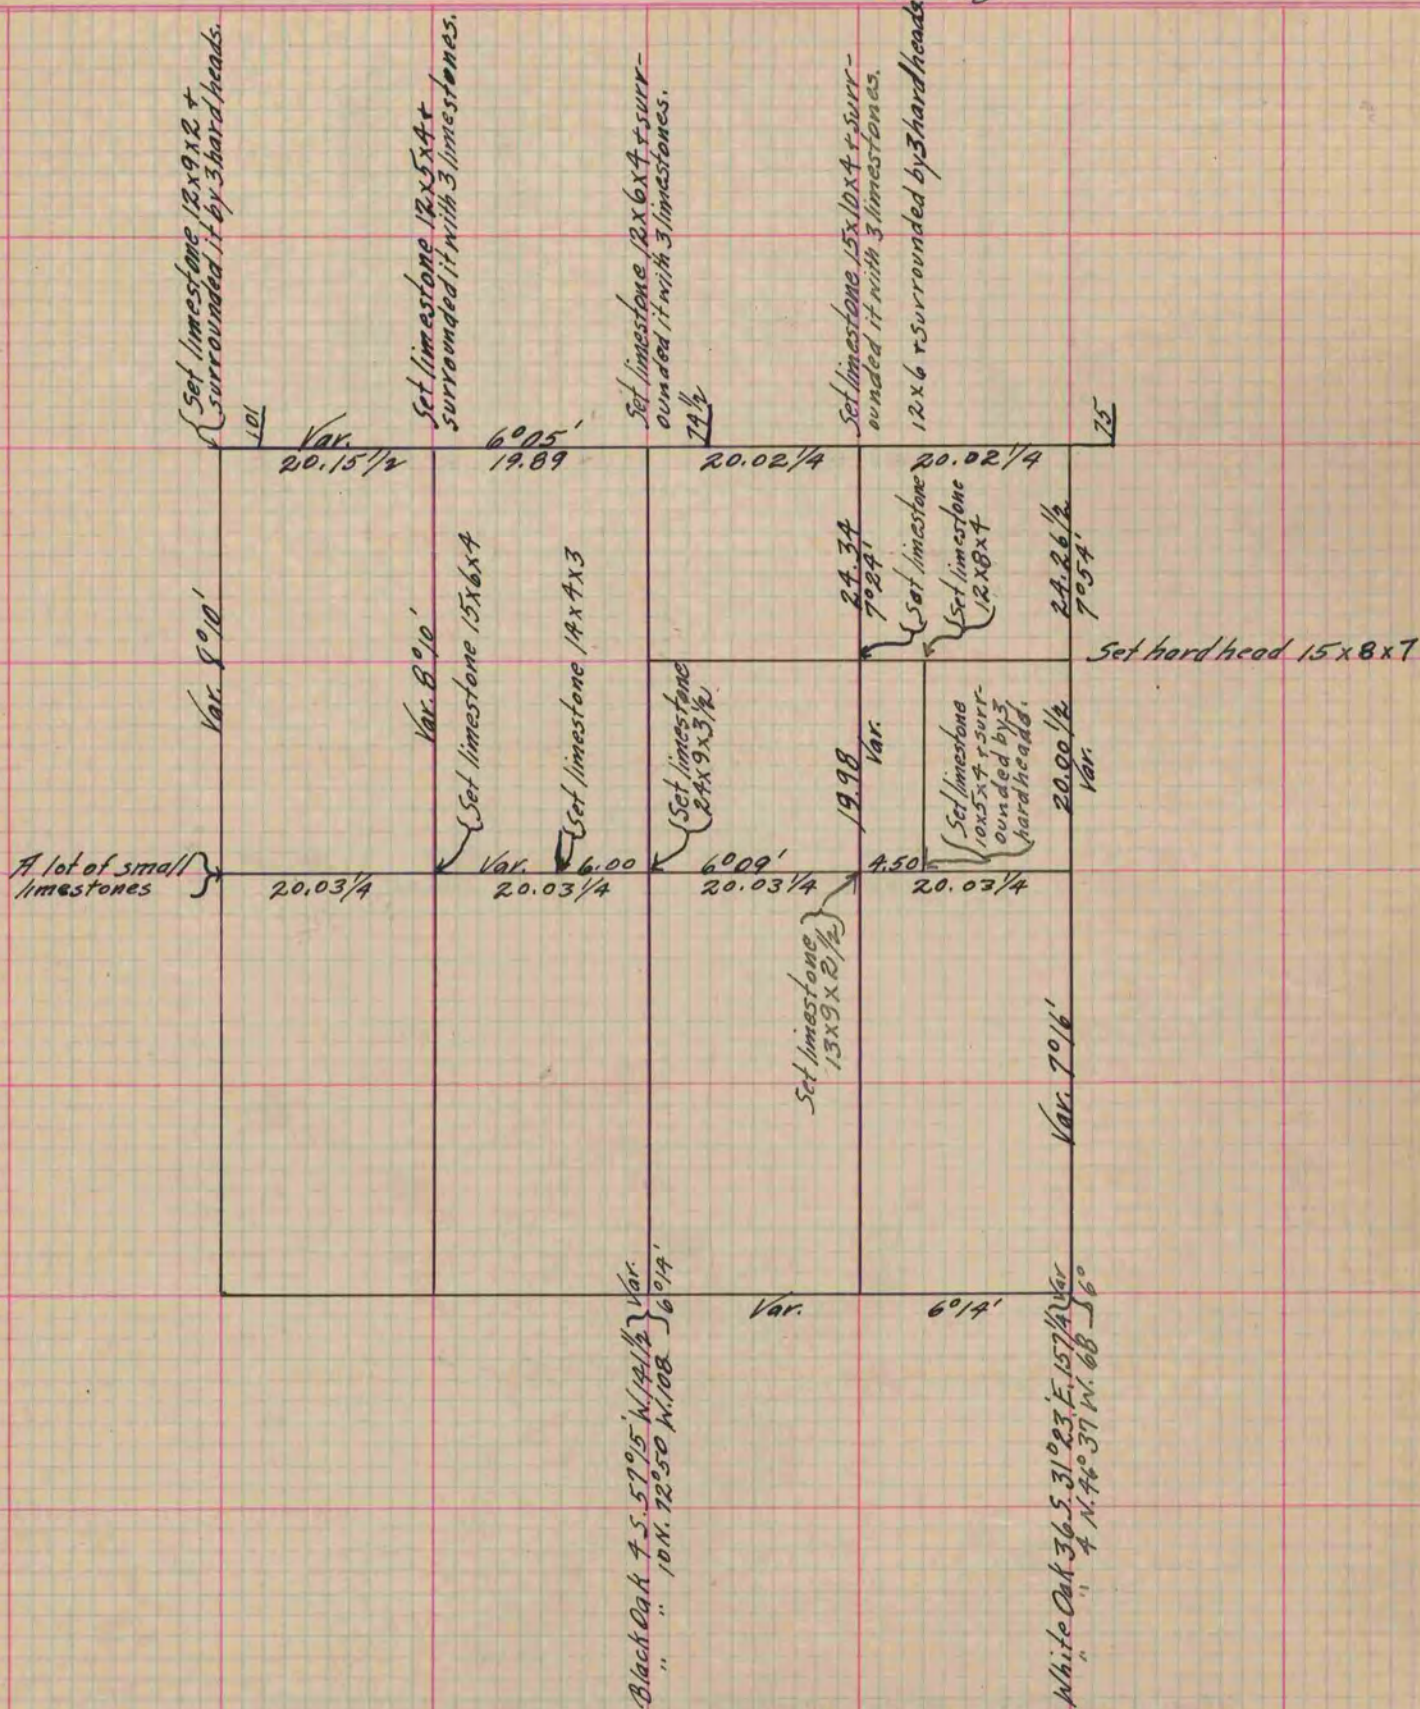

Copied from Page 160 Vol. 1. Original County Surveyor's Record.