

PLAT AND RECORD

111


Of a Survey on Section 16 T 2 R 11 E. of the 4 P. M. in Plymouth Township
Rock County, Wisconsin, made October the 20th 1873

I hereby certify that the following is a correct record of said survey as made by me.

COUNTY BUILDING
IN CITY OF BELOIT

(Signed) Edward Ruger
E.R.B.

County Surveyor.

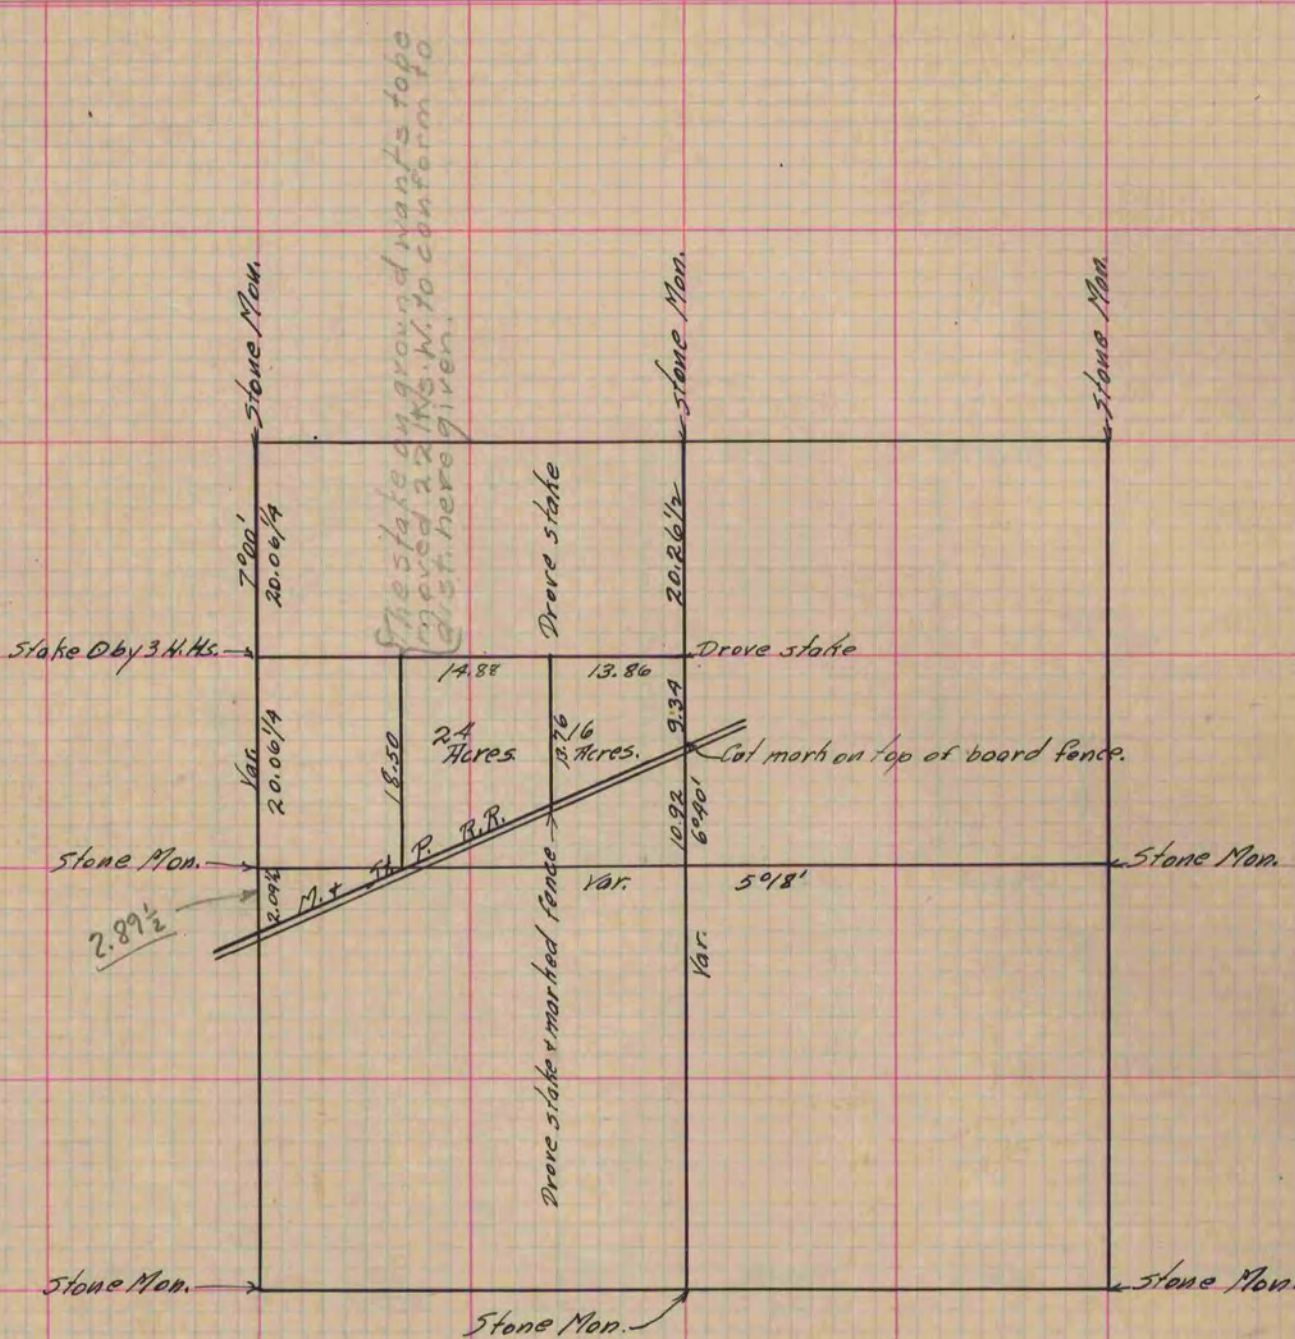

Copied from Page 69 Vol. 2 Original County Surveyors Record.