

U.S. PUBLIC LAND SURVEY MONUMENT RECORD

For Public Land Survey Corners In: WI ADMINISTRATIVE CODE A-E 7.08 REQUIREMENT

T. 1 N. - R. 12 E. of the 4th P.M.

CORNER CODE INDEX

BELOIT TWP

ROCK COUNTY WI

(PLACE "◆" SYMBOL AT PROPER PLSS CORNER LOCATION)

A	2	3	4	5	6	7	8	9	10	◆	12	13	14	15	16	17	18	19	20	21	22	23	24	25	A
B																									B
C	6									4															C
D																									D
E																									E
F																									F
G	7									9															G
H																									H
J																									J
K	18									16															K
L																									L
M																									M
N																									N
O																									O
P	19									21															P
Q																									Q
R																									R
S																									S
T	30									28															T
U																									U
V																									V
W																									W
X	31									33															X
Y																									Y
Z																									Z
	1	2	3	4	5	6	7	8	9	10	11	12	13	14	15	16	17	18	19	20	21	22	23	24	25

ROCK COUNTY COORDINATES
(GNSS DERIVED VIA WISCORS)

North 233269.46 Elev.

East 477816.82

Hor. Datum NAD83 (NA2011)




Vert. Datum

BASIS OF BEARINGS

Wisconsin County Coordinate System
Rock County Datum

(a) **LEGEND**

- - 5/8" x 24" REBAR SET, (RED CAP W/"PLSS WITNESS")
- - ALUMINUM MONUMENT SET
- ⊙ - IRON REBAR FOUND
- ⊙ - IRON PIPE FOUND
- ⊙ - IRON PIPE IN MONUMENT BOX FOUND
- - STONE FOUND
- - LIMESTONE FOUND
- △ - RAILROAD SPIKE FOUND
- ◇ - ALUMINUM MONUMENT FOUND

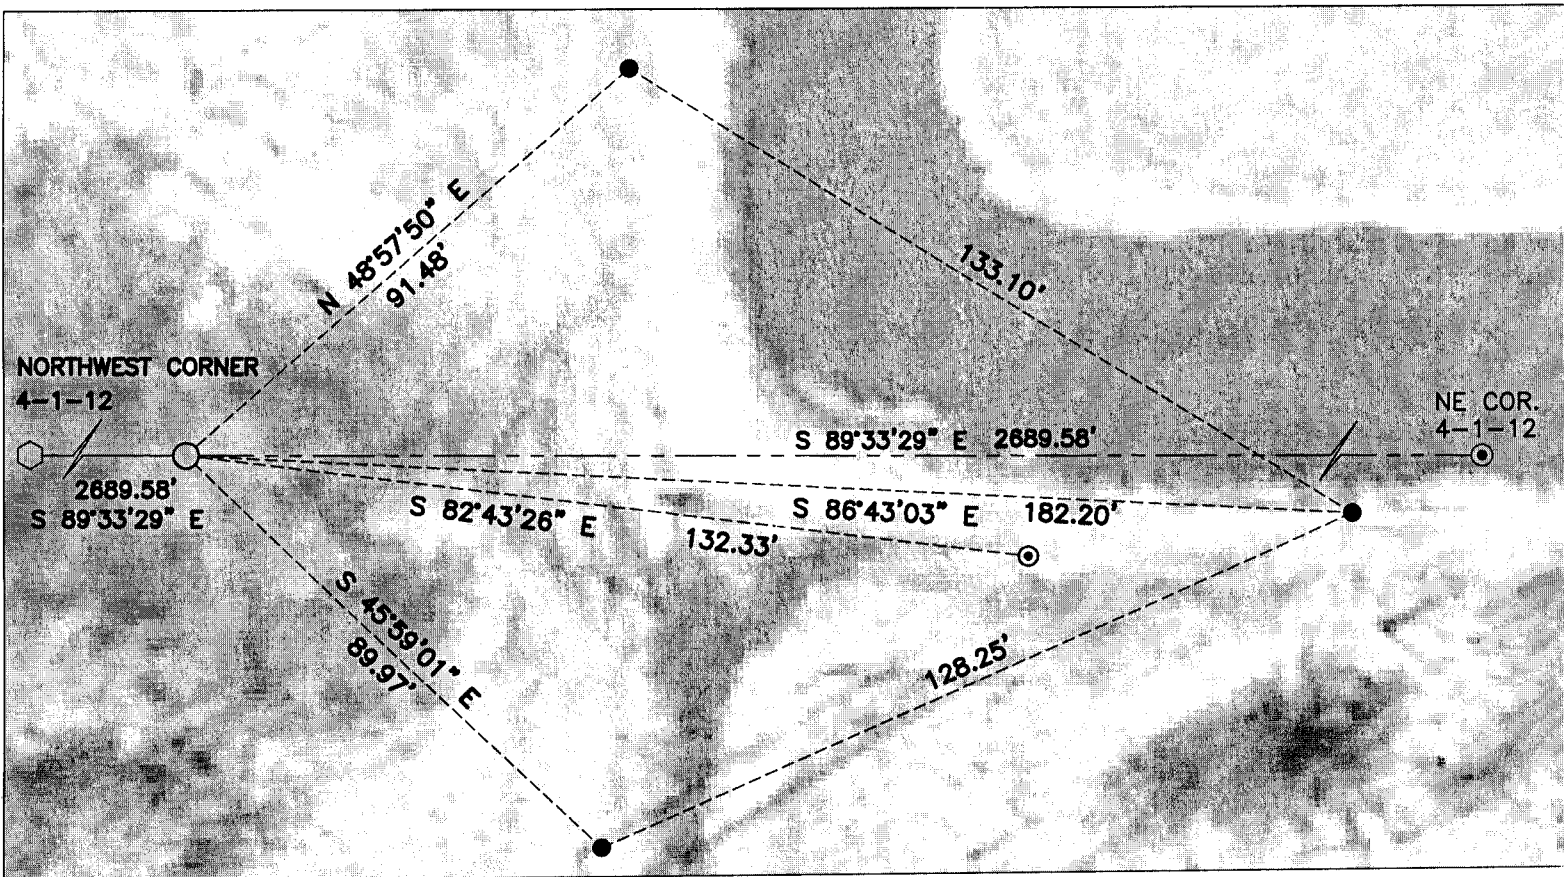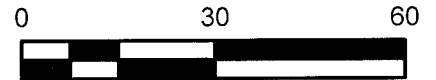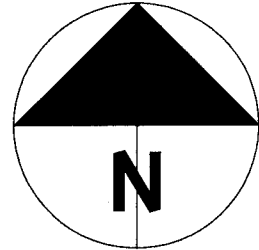

SHEET 1 OF 2

FIELD BOOK 2013 PAGE # 13

CORNER CODE A-11(1)

