

# PLAT AND RECORD

COUNTY BUILDING  
IN CITY OF BELOIT

Of a Survey on Section 28 T 4 R 13 E. of the 4 P. M. in Milton Township

Rock County, Wisconsin, made December the 19 1905


I hereby certify that the following is a correct record of said survey as made by me.

(Signed) C. V. Kerch  
R.H.B. County Surveyor.

K<sup>3</sup> 118

Found gas pipe at Cen. Sec. 28

Found Mon. E. Side Sec. 28

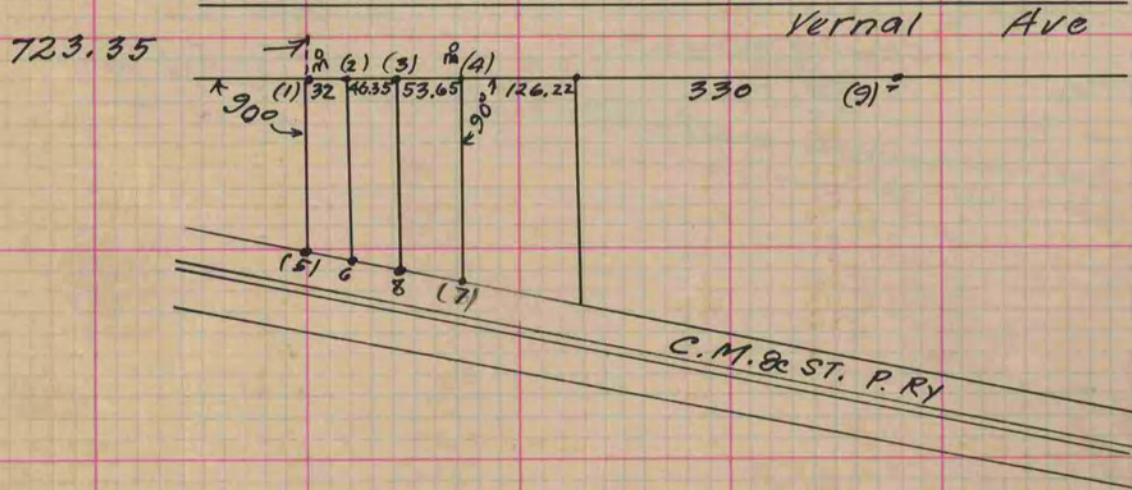

- At (1) Found old stake refered to in Burdick deed set gas pipe
- " (2) Set gas pipe
- (3) " " "
- (4) Set gas pipe. It is in line with present Walk where iron rod was set
- (5) (6) & (7) Set gas pipe
- 8 Set flat iron rod
- 9 Found iron rod