


# PLAT AND RECORD

Of a Survey on Section 13 T 2 R 11 E. of the 4 P. M. in Plymouth Township  
Rock County, Wisconsin, made June the 11 1970

I hereby certify that the following is a correct record of said survey as made by me.

COUNTY BUILDING  
IN CITY OF BELOIT

(Signed) Edward Ruger  
R. H. B. } Deputy  
County Surveyor.

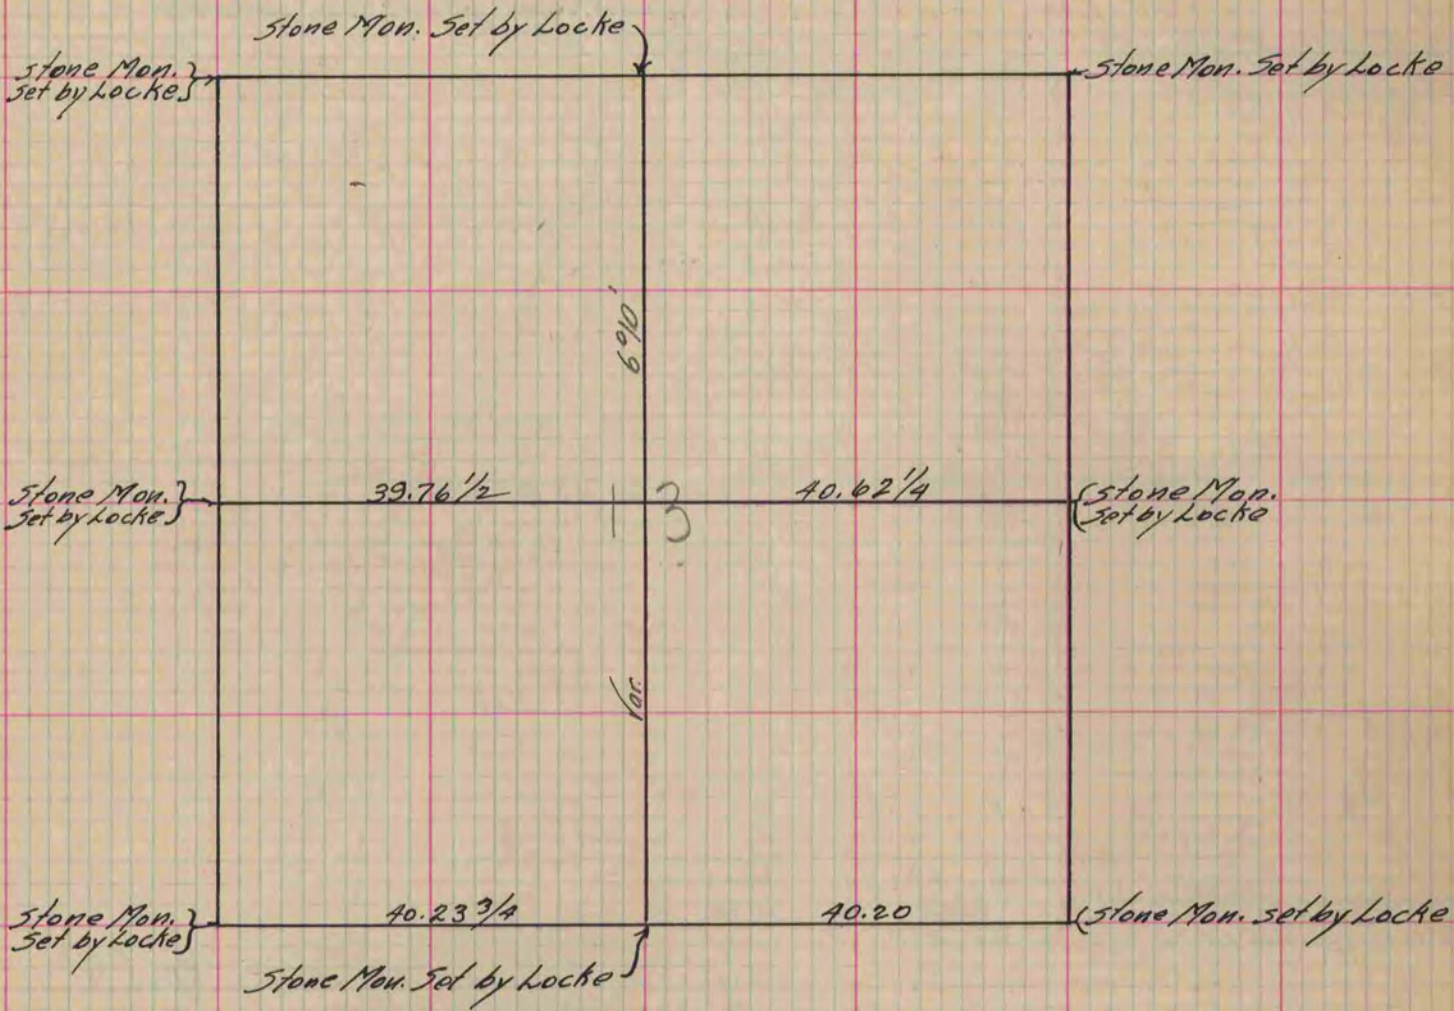

Copied from lower 1/2 P. 23 Vol. Original County Surveyor's Record.