

Paper weight-110# (minimum)

Black nonfading ink required

# U.S. PUBLIC LAND SURVEY MONUMENT RECORD

For Public Land Survey Corners In:  
T. 2 N. R. 14 E. 4th P.M.

WI ADMINISTRATIVE CODE A-E 7.08 REQUIREMENT  
REV 10/23/2004 USMONREC.DWG

### CORNER CODE INDEX

	1	2	3	4	5	6	7	8	9	10	11	12	13	14	15	16	17	18	19	20	21	22	23	24	25		
A																											A
B																											B
C																											C
D																											D
E																											E
F																											F
G																											G
H																											H
I																											I
J																											J
K																											K
L																											L
M																											M
N																											N
O																											O
P																											P
Q																											Q
R																											R
S																											S
T																											T
U																											U
V																											V
W																											W
X																											X
Y																											Y
Z																											Z

BRADFORD TWP  
ROCK COUNTY WI

IF AVAILABLE  
ROCK COUNTY COORDINATES PREFERRED

North \_\_\_\_\_ Elev. \_\_\_\_\_

East \_\_\_\_\_

Hor. Datum \_\_\_\_\_ Vert. Datum \_\_\_\_\_

LATITUDE \_\_\_\_\_ ELLIPS. HT. \_\_\_\_\_

LONGITUDE \_\_\_\_\_

NAD83(91) \_\_\_\_\_ NETWORK ADJ. YR \_\_\_\_\_

GPS (X) \_\_\_\_\_ TRAVERSE (X) \_\_\_\_\_

BASED ON THE FOLLOWING CONTROL:  
\_\_\_\_\_

PLACE MONUMENT SYMBOL  AT PROPER  
LOCATION ON ABOVE INDEX

CORNER MONUMENT

WITNESS MONUMENT

(a)

BEARINGS ARE BASED ON: \_\_\_\_\_

FIELD BOOK \_\_\_\_\_ PAGE # \_\_\_\_\_

SHEET 1 OF 3

SHOW A PLAN VIEW DRAWING DEPICTING THE CORNER MONUMENT AND SURROUNDING  
PHYSICAL FEATURES, INCLUDING THE EXCAVATION AREA AND DEPTH.

PLANNING & ZONING COMMITTEE ADOPTED THIS FORM ON 12/2/1982

CORNER CODE E-9(3)

**BR525 SECORSEC5**

*(B) Describe any record evidence, monument evidence, occupational evidence, testimonial evidence or any other material evidence you considered, and whether the monument was found or placed.*

- 1878 RUGER VOL 2 PG 246 FD REMAINS OF OLD STAKE SET LIMESTONE 16X8X6 SURROUNDED BY 2 LIME & 2 HH. 2644.62 TO W 1/4 COR SEC 4 & FD REMAINS OF OLD STAKE & SET HH STONE 20X12X9
- 1920 BATTERMAN VOL 3 PG 99 & #520 SET IRON ROD ABOVE LIMESTONE, 1325.57 TO IRON ROD @ S 1/16TH COR OF SE 1/4 SEC 5, 2651.14 TO IRON ROD @ S 1/4 COR SEC 5, 5302.29 TO SET IRON ROD IN PLACE OF LIMESTONE @ SW COR SEC 5.
- 1922 UNKNOWN VOL 3 PG 120 REFERENCED CORNER BUT STATES NOTHING ABOUT IT. CALLS FOR 46.8X TO SW REFERENCE FD PIPE. (1971 LEE CALLS FOR A PIPE & DISTANCE OF 46.86)
- 1971 LEE VOL 4 PG 514 DUG & FD LIMESTONE SURROUNDED BY 2 LIMESTONES & 2 HH. REFERENCED SAME.
- 1980 BARNES VOL 6 PG 32 SET PK FROM TIES S88-17-06E 2650.13 TO STAKE @ S 1/4 COR SEC 4 FB#1 PG 36 & 37
- 1980 WIDOT E-09 & #523 CALLS FOR TIES TO CORNER BUT STATES NOTHING ABOUT MON.
- 1982 BARNES E-09(1) FD DOT REFERENCE MONUMENTS & TWP PROJECT-PK/BRASS FLASHER STATION #73. SET POLY FROM TIES.
- 1982 BARNES TWP PROJ. S89-19E 2650.2X TO S 1/4 COR SEC 4, N88-36W 2650.5X TO S 1/4 COR SEC 5, S0-45-38E 2651.79 TO W 1/4 COR SEC 9.
- 1994 WIDOT E-9(2) BARNES NOTE: WIDOT PROVIDED THE NAD83(91) STATE PLANE COORDINATES AND DESCRIBED THE MONUMENT THEY FOUND (ALUM). THEY ESTABLISHED THE COORDINATES BY TRAVERSING FROM GPS STATIONS THAT THEY ESTABLISHED PRIOR TO THE ROCK COUNTY GPS NETWORK. I TRANSCRIBED THEIR INFORMATION TO THIS SHEET. I ALSO CONVERTED THEIR STATE PLANE COORDINATES TO THE LATITUDE/LONGITUDE AND ROCK COUNTY COORDINATES THAT ARE SHOWN. STATE PLANE 240,585.09; 2,276,426.82 COUNTY 258,773.55; 538,45.04

LEE'S 1971 REFERENCE PIPES WERE PROBABLY DESTROYED BY PREVIOUS STH 11 & 14 CONSTRUCTION PROJECTS.

INSTALLED STEEL SURVEY MONUMENT SPIKE ON FINAL MATT. STEEL SURVEY SPIKE IS 3" LONG, 3/8" DIAMETER, & TOP IS 1" IN DIAMETER AND STAMPED "SURVEY MARKER".

*C) Was the corner restored through acceptance of (1) an obliterated evidence location, or, (2) a found perpetuated location?*

ACCEPTED FD PERPETUATED LOCATION

*Ronald Kaeser*  
*09/22/08*

SHEET 1 OF 3  
CORNER CODE **E-9(3)**

**BR525 SECORSECS**

D) Describe any material discrepancy between the location of the corner as restored or reestablished and the location of that corner as previously restored or reestablished by distance and direction. Show the discrepancy on the plan view drawing under (a), above. Show the distances between the corner as previously restored or reestablished and (1) the corner as restored or reestablished, and (2) to at least 4 of the witness monuments shown on the drawing in (a), above.

**NONE**

E) Was the corner reestablished through lost corner proportionate methods? If so, show the method, including the directions and distances to other public land survey corners used as evidence or used for proportioning the corner location.

**NO**

I, **Donald Barnes**, hereby certify that the corner location as identified by the corner code index was determined by me under my direction and control and that this U.S. Public Land Survey Monument Record is correct and complete to the best of my knowledge and belief.

*Donald*


*B Barnes*  
Seal  
*9/22/08*  
Emboss

SHEET 2 OF 3

CORNER CODE **E-9(3)**  
A.E. 7.08 REQUIREMENT

▲ DURA NAIL  
 ○ WIDDOT DISK  
 ● SURVEY SPIKE

N88-45-18W 5301.07  
 1920 BATTERMAN 5302.29  
 1920 BATTERMAN 2651.14  
 N88-45-58W 2650.84  
 1920 BATTERMAN 1325.57 1920 BATTERMAN 1325.57  
 N88-37-29W 1323.72 S88-54-24E 1327.13  
 SW CDR SEC 5 1/16TH CDR

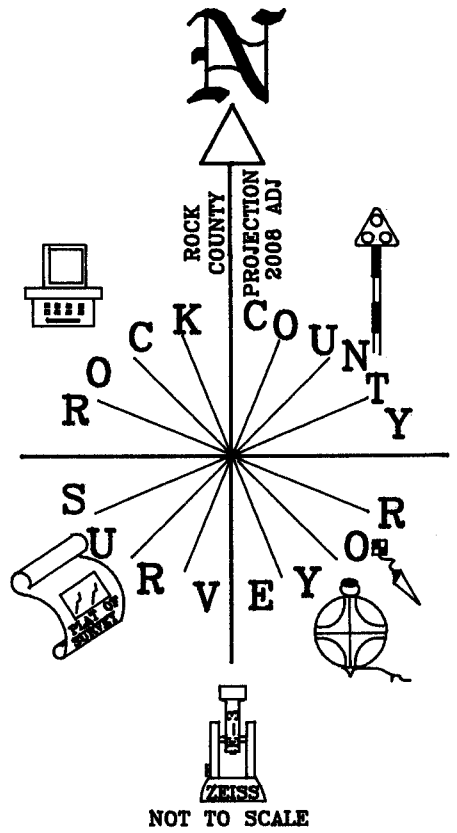

STH 11

SURVEY SPIKE  
ELEV 981.7

DURA NAIL IN CONC. CURB JOINT  
ELEV 981.2X

AVALON RD

SE CDR  
SEC 5  
BRADFORD TWP  
T2N R14E

FD DISK IN CONC.  
 1968 PARK AERIAL SURVEY (I-90 CONTROL)  
 T-13 AZIMUTH DISK IN CONCRETE  
 .1 MILE SOUTH OF STH 11  
 ON WEST SIDE OF AVALON RD  
 15' WEST OF CENTER OF PVMT  
 RECORD ELEV 1929 MSL 968.40  
 NAD 27 240,013.869) 2,307,966.40  
 THIRD ORDER ACCURACY

WIDDOT NAD83(91) POLY 240,585.09) 2,276,426.82  
 CONVERT- 258,773.55) 538,345.04\*

FB #2 PG 19  
 OBSERVATION SHEET #162  
 SHEET 3 OF 3

E-9(3)

*David Barnes*  
*9/22/08*

