

U.S. PUBLIC LAND SURVEY MONUMENT RECORD


For Public Land Survey Corners in the
T. 1 N., R. 14 E.

CORNER CODE INDEX

	1	2	3	4	5	6	7	8	9	10	11	12	13	14	15	16	17	18	19	20	21	22	23	24	25
A																									
B																									
C																									
D																									
E																									
F																									
G																									
H																									
I																									
J																									
K																									
L																									
M																									
N																									
O																									
P																									
Q																									
R																									
S																									
T																									
U																									
V																									
W																									
X																									
Y																									
Z																									

PLACE MONUMENT SYMBOL (◆) AT PROPER LOCATION ON ABOVE INDEX

EXAMPLE

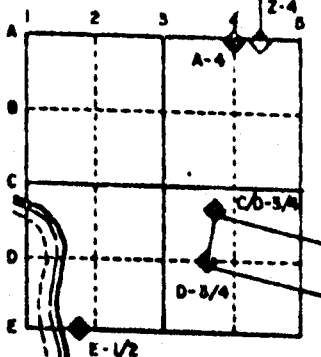

CLINTON TWP
ROCK COUNTY WI


IF AVAILABLE
STATE PLANE COORDINATES

North (Y) _____ Eleve. (Z) _____
 East (X) _____ Zone _____
 Hor. Datum _____ Vert. Datum _____

◆ CORNER MONUMENT

○ WITNESS MONUMENT

BEARINGS ARE BASED ON:

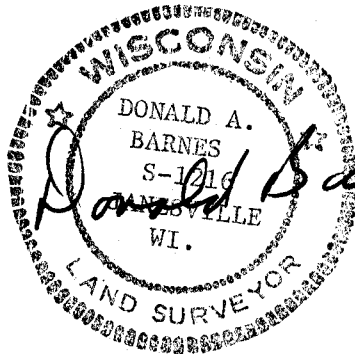

MICROFILMED


SHEET 1 OF 3

CORNER CODE: E 1 (1)

(B) Describe any record evidence, monument evidence, occupational evidence, testimonial evidence or any other material evidence you considered, and whether the monument was found or placed.

- 1835 MULLETT SET POST CORNER SECTIONS 1 & 12 BUR OAK 13 S18W .38, BUR OAK 12 N68W 79
- 1909 KERCH FIELD BOOK #4 PG 86. SHOWS CORNER BUT STATES NOTHING ABOUT IT. CALLS FOR A DISTANCE OF 14.5 TO THE CENTER OF THE R/R TRACKS AND 2650.1 FROM THE W 1/4 CORNER OF SECTION 6. CALLS FOR AN ANGLE OF 57-23 FROM A POINT ON THE R/R FROM THE R/R TO THE E 1/4 CORNER OF SECTION 1 AND A DISTANCE OF 3142.4 FROM THE SECTION LINE ALONG THE R/R TO THE N/S QUARTER LINE OF SECTION 1.
- 1953 SHIMEALL CALLS FOR A PIN AT THE CORNER FOR A SURVEY IN SECTION 7. PAGE 14 OF FIELD NOTES SHOWS PIN BUT NO STATEMENT AS TO RATHER HE FOUND IT OR PLACED IT.
- 1965 SHIMEALL CALLS FOR A PIN AT THE CORNER FOR A SURVEY IN SECTION 6.
- 1969 SHIMEALL USED PIN AT THE SW CORNER OF SECTION 6 FOR A SURVEY IN SECTION 6. PAGE 25 OF FIELD NOTES STATES "BATTERMAN MON. 3.31 SOUTH OF R/R SPIKE.
- 1970 BATTERMAN JR. VOL 4 PG 476 FOUND A R/R SPIKE OVER C.M.P. NEAR THE CORNER. SHOWS "RECORD 14.5" TO CENTER OF R/R TRACKS.
- 1970 SHIMEALL CSM VOL 1 PG 288 CALLS FOR A PIN AT THE SW CORNER OF SECTION 6.
- 1971 SHIMEALL CSM 2 VOL 161 IN SECTION 6 CALLS FOR A PIN.
- 1971 LEE VOL 4 PG 529 "FOUND CORNER OBLITERATED BY CULVERT, ESTABLISHED CORNER BY RECORD OF SURVEY BY C.V. KERCH AS FILED IN BOOK K-4, PG 86 AT THE JANESVILLE CITY ENGINEERS OFFICE. SET 12" C.I. HARRISON MONUMENT IN PLACE." SKETCH SHOWS THAT THE C.M.P. PROBABLY DESTROYED THE ORIGINAL MONUMENT. CALLS FOR KERCH DISTANCE OF 2650 TO THE W 1/4 CORNER OF SECTION 6.
- 1972 LEE VOL 4 PG 551 SHOWS 2525.36 TO THE SW CORNER OF SECTION 6. APPEARS TO HAVE USED THE SW CORNER OF SECTION 6 TO ESTABLISH THE N 1/4 CORNER OF SECTION 7.
- 1973 DOT VOL 6 PG 120 PROJECT #1093-1-21 CALLS FOR A CAST IRON MONUMENT AND COORDINATES OF 208538.21;2297961.93.
- 1981 BARNES CLINTON TOWNSHIP PROJECT. FROM THE C.I. MONUMENT I SHOW 2650.24 TO THE W 1/4 CORNER OF SECTION 7, 2523.77 TO THE N 1/4 CORNER OF SECTION 7 AND 2649.51 TO THE W 1/4 CORNER OF SECTION 6. THE N 1/4 CORNER OF SECTION 7 IS .05' OFF THE LINE BETWEEN THE NW AND NE CORNERS OF SECTION 7.
- 1983 HAROLD COMBS. USED THE CAST IRON MONUMENT FOR CSM 11 PG 193.
- 1987 HAROLD COMBS USED PIN AT THE SW CORNER OF SECTION 6 FOR A SURVEY IN SECTION 6.
- 1987 HAROLD COMBS USED PIN AND NOTES C.I. FOR A SURVEY IN SECTION 6.
- 1987 BARNES E-1 SHOWS RECORD DISTANCES AND TIES TO CAST IRON AND PIN. STATES THAT THE DISTANCE FROM THE CENTER OF THE TRACKS AT A 90 ANGLE TO THE PIN IS 10.0 THE DISTANCE TO THE C.I. FROM THE CENTER OF THE TRACKS AT A 90 ANGLE IS 12.6'. THE DISTANCE TO THE PIN FROM THE CENTER OF THE TRACKS THAT IS ON THE LINE WITH THE N/S FENCE TO THE NORTH IS 11.0 AND THE DISTANCE TO THE CI. IS 14.2'
- 1987 BATTERMAN CO. CSM 13 PG 139 TIED INTO C.I.
- 1987 SCHROEDER CSM 13 PG 31 USED CAST IRON MONUMENT.
- 1988 HAROLD COMBS SURVEY IN SECTION 6. USED IRON PIN AT THE SW CORNER OF SECTION 6.
- 1990 HAROLD COMBS CSM 14 PG 335 CALLS FOR A CAST IRON MONUMENT AT THE SW CORNER OF SECTION 6.
- 1990 HAROLD COMBS SURVEY IN SECTION 6 USED C.I.

I DID NOT FIND ANY RECORDS THAT STATED WHO PLACED THE PIN. IT APPEARS THAT SOMETIME BETWEEN 1965 AND 1969 THE CULVERT WAS INSTALLED. IN 1969 SHIMEALL'S FIELD NOTES HE STATES THAT HE FOUND A R/R SPIKE AND MONUMENT PLACED BY BATTERMAN. HE DID NOT

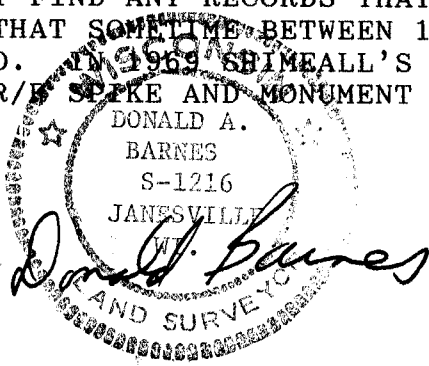

SHEET 1 OF 3

E-1(1)

STATE THE TYPE OF MONUMENT. BASED ON VIEWING COMBS FIELD NOTES IT APPEARS THAT THE R/R SPIKE HAS PERPETUATED THE LOCATION OF THE PIN. IT HAS APPEARS THAT THE SURVEYS SINCE 1970 THAT HAVE CALLED FOR A PIN WERE IN ERROR. THERE WAS NO PIN BUT JUST THE R/R SPIKE. THE R/R SPIKE IS STILL THERE AS CALLED FOR BY SHIMEALL IN 1969. IT IS MY OPINION THAT THE CAST IRON MONUMENT SHOULD BE THE SW CORNER OF SECTION 6 FOR THE FOLLOWING REASONS:

- 1) THERE IS NO DOCUMENTATION FOR HOW THE PIN WAS PLACED.
- 2) SELECTION OF EITHER CORNER WILL EFFECT MANY SURVEYS SO THAT SHOULD NOT BE A CONSIDERATION.
- 3) THE LOCATION BEST FITS A PRORATED DISTANCE WITH THE ORIGINAL GOVERNMENT SURVEY.
- 4) THE LOCATION BEST FITS KERCH'S 1909 CALL DISTANCES.
- 5) THE NORTH QUARTER CORNER OF SECTION 7 WAS ESTABLISHED BY USING THE CAST IRON MONUMENT.

C) Was the corner restored through acceptance of (1) an obliterated evidence location, or, (2) a found perpetuated location?


ACCEPTED CAST IRON MONUMENT WHICH PERPETUATES KERCH'S LOCATION.

D) Describe any material discrepancy between the location of the corner as restored or reestablished and the location of that corner as previously restored or reestablished by distance and direction. Show the discrepancy on the plan view drawing under (a), above. Show the distances between the corner as previously restored or reestablished and (1) the corner as restored or reestablished, and (2) to at least 4 of the witness monuments shown on the drawing in (a), above.

SEE 1987 E-1 TIES.

(E) Was the corner reestablished through lost corner proportionate methods? If so, show the method, including the directions and distances to other public land survey corners used as evidence or used for proportioning the corner location.

I, Donald Barnes, hereby certify that the corner points as identified by the corner code index were, in a field survey on, March 7, 1991, established, re-established, monumented, re-monumented, recovered or restored as expressed below and in conformance with the regulations and rules as required in the current manual of survey instructions of the United States Department of Interior, Bureau of Land Management.

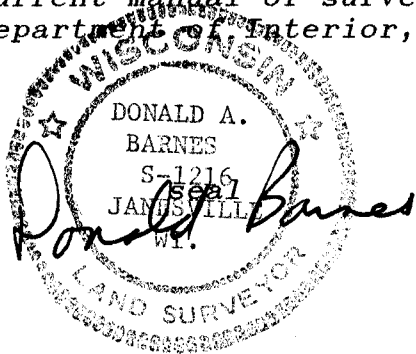

COUNTY SURVEYOR FILING DATA

Date of computer entry _____

Date microfilmed _____

Number of included sheets 3
CORNER CODE

AFFIX YOUR LAND SURVEYOR SEAL

E1(1)

