U.S.


PUBLIC LAND SURVEY MONUMENT RECORD

For Public Land Survey Corners in:

WI ADMINISTRATIVE CODE A-E 7.08 REQUIREMENT

T. L.N., R. _/AE

CORNER CODE INDEX

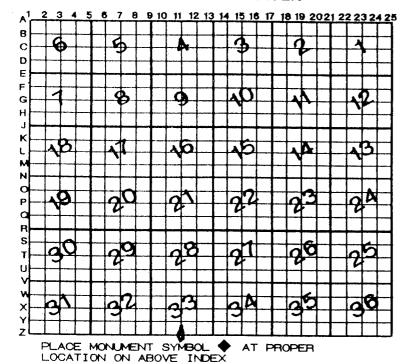

CLINTON TWP ROCK COUNTY WI

IF AVAILABLE ROCK COUNTY COORDINATES PERFERRED

North /81, 8/6, 22 Elev.

East 2, 279,918,07

Hor. Datum

LATITUDE __ ELLIPS. HT. LONGITUTE

GPS (X) ___ TRAVERSE (X)

BASED ON THE FOLLOWING CONTROL:

CORNER MONUMENT

S/A" IRON ROD

WITNESS MONUMENT

WIDOT 3320-00.22

DATE 2-26-93

(a)

Ż

BEAFINGS

5/432 5 88-48-32E SW 2651.81 33

588-48-11E 2651.81 51/433

NOTE ON PLAT: COORDINATES & BEARINGS ON THIS PLAT ARE ORIENTED TO THE WI COORDINATE SYSTEM UTILIZING A CONVERSION FACTOR THAT WAS COMPUTED TO MOST CLOSELY REPRESENT THAT USED BY THE STATE OF WISCONSIN AND THE STATE OF ILLINOIS. THE COMPUTATION INVOLVED DIVIDING GRID COORDINATES, AS **DETERMINED BY DISTRICT 1 SURVEY AT 3 SECTION** CORNERS (THE S 1/4 COR OF SEC 32, THE S.E. COR OF SEC 32 AND THE S 1/4 COR OF SEC 33, ALL IN T1N R14E) & BY THE ILLINOIS GROUND COORDINATES SHOWN AT THE SAME CORNERS ON ILLINOIS HIGHWAY PLAN R-92-022-90, AND THEN AVERAGING THE RESULTS. ALL PLAT DISTANCES AND GROUND LENGTH, FROM COMPUTATIONS UTILIZING WDOT COORDINATES AND MAY BE CONVERTED TO GRID LENGTH BY MULTIPLYING THE GRID FACTOR PROVIDED ON THE DETAIL SHEET (5) | SHEET (5) WAS NOT SENT TO THE

-04_ PAGE #_

SHOW A PLAN VIEW DRAWING DEPICTING THE CORNER MONUMENT AND SURROUNDING PHYSICAL FEATURES, INCLUDING THE EXCAVATION AREA AND DEPTH.

PLANNING & ZONING COMMITTEE ADOPTED THE ABOVE FORM ON 12/2/1982

INFORMATION COPIED FROM WIDOT R/W PLATS. PROJECT NUMBER AND DATE IS SHOWN ON OPPOSITE SIDE. WHEN COORDINATES WERE SHOWN IN METERS I REDUCED TO U.S. SURVEY FEET. I REDUCED NAD 83 COORDINATES TO COUNTY COORDINATES.