

RECORD OF U. S. PUBLIC LAND SURVEY CONTROL STATION

U. S. PUBLIC LAND SURVEY CORNER $\frac{1}{6}$ T 1 N, R 15 E, Walworth COUNTY, WIS.

GEODETIC SURVEY BY: Dept. of Transportation YEAR: _____

STATE PLANE COORDINATES OF: Section Corner
 NORTH 213,857.367
 EAST 2,329,677.636


ELEVATION OF STATION: _____

HORIZONTAL DATUM: WISCONSIN STATE PLANE COORDINATE SYSTEM, SOUTH ZONE

VERTICAL DATUM: NATIONAL GEODETIC VERTICAL DATUM OF 1929

CONTROL ACCURACY: HORIZONTAL: _____ VERTICAL: _____ THETA ANGLE: +0°-50'-28"

LOCATION SKETCH:

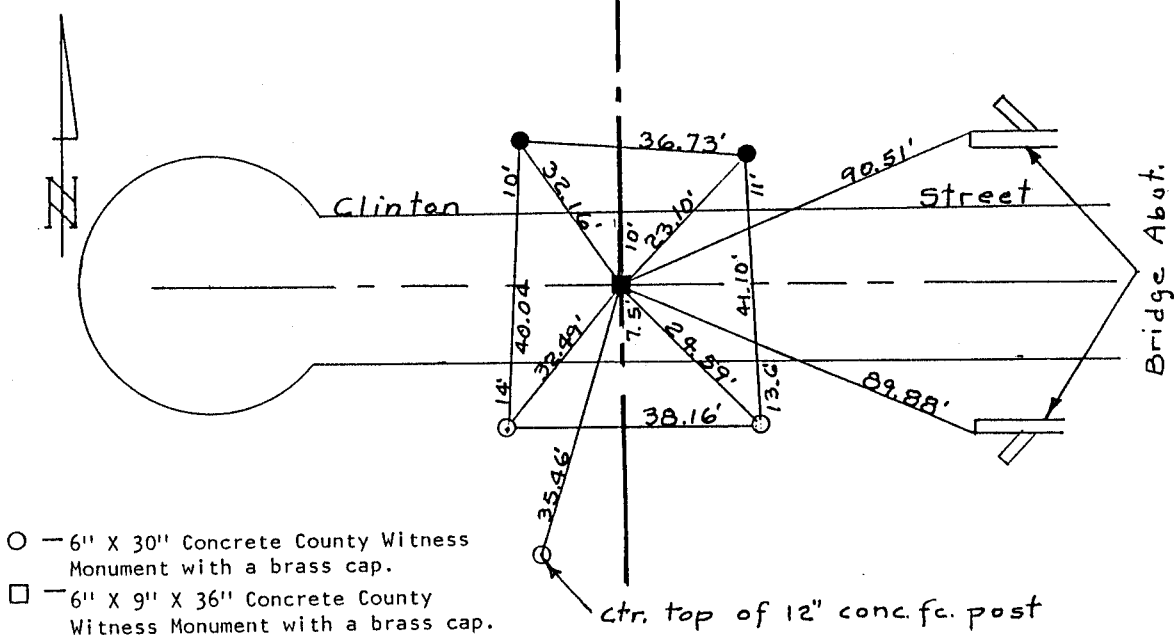

- — 6" X 30" Concrete County Witness Monument with a brass cap.
- — 6" X 9" X 36" Concrete County Witness Monument with a brass cap.

SURVEYOR'S AFFIDAVIT:

STATE OF WISCONSIN) SS
 Walworth COUNTY)

I hereby certify that I excavated the road and 24 inches below the road surface found mark of an old wood stake which I accepted as the location for the Section corner, date of survey 1958. Small concrete monument was relocated in 1970 by Harold Kolb and replaced with a 6" X 9" X 36" Concrete County Monument, October 1, 1970.

DATE OF SURVEY: 1-26-84 3-31-93 Floyd P. Jensen S- 211

REGISTERED LAND SURVEYOR

FORM PREPARED BY SOUTHEASTERN WISCONSIN REGIONAL PLANNING COMMISSION

A-0