U.S.


PUBLIC LAND SURVEY MONUMENT RECORD

For Public Land Survey Corners in:

WI ADMINISTRATIVE CODE A-E 7.08 REQUIREMENT

T. _/N., R. _/A_E

CORNER CODE INDEX

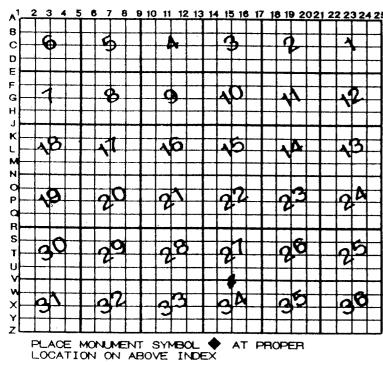

CLINTON ROCK COUNTY WI

IF AVAILABLE ROCK COUNTY COORDINATES PERFERRED

North Elev. East Hor. Datum _____ Vert. Datum LATITUDE __ELLIPS. HT. LONGITUTE GPS (X) ___ TRAVERSE (X) BASED ON THE FOLLOWING CONTROL:

CORNER MONUMENT

WITNESS MONUMENT

Ž O BEARINGS ARE BASED

(a)

FIELD BOOKPAGE #	SHEET OF
SHOW A PLAN VIEW DRAWING DEPICTING THE CO PHYSICAL FEATURES, INCLUDING THE EXCAVATION	ORNER MONUMENT AND SURROUNDING
PLANNING & ZONING COMMITTEE ADOPTED THE ABOVE FO	
	CORNER CODE $\sqrt{-15(2)}$

CL608

- (B) Describe any record evidence, monument evidence, occupational evidence, testimonial evidence or any other material evidence you considered, and whether the monument was found or placed.
- 1967 BATTERMAN VOL 4 PG 342 DUG LARGE HOLE & FD NOTHING
- 1976 BARNES VOL 5 PG 151 SET CI BY SINGLE PROPORTIONATE MEASUREMENT BETWEEN ADJOINING SEC CORNERS. REFERENCED SAME.
- 1976 LEUENBERGER CSM VOL 15 PG 99 STATES NOTHING ABOUT TYPE OF MON.
- 1983 LEUENBERGER MAP #6319 CI MON. 2649.64 TO CENTER OF SEC 27 & ANGLE @ S $\frac{1}{4}$ COR SEC 27 FROM N/S $\frac{1}{4}$ LINE TO SE COR SEC 27 92-31-53
- 1991 SCHROEDER CSM VOL 15 PG 99 DOES NOT STATE TYPE OF MON.
- 1993 KUPSCH V-15 FD CAST IRON MONUMENT WITH CAP MISSING & REFERENCED SAME. FD 1 1/4" PIPE IN NE COR OF INTERSECTION & PLACED 1 1/4" PIPES IN NW, SW, & SE CORNER OF INTERSECTION.
- 1993 KUPSCH MAP#10108 C.I. 2169.63 TO NE COR SEC 34.
- 1994 BARNES V-15(2) FD CI TOP BROKE OFF. FD REFERENCE MONUMENTS. ROAD CONSTRUCTION WILL DISTURB THE MONUMENT. TIED INTO GPS CLINTON & GPS CLINTON AZIMUTH.
- 2002 LATHROP MAP#14382 FD ALUM. 5300.03 TO 5 $\frac{1}{4}$ COR SEC 34, 2651.50 TO INT. OF $\frac{1}{4}$ LINES OF SEC 34, & 88-31-45 ANGLE AT INT. OF $\frac{1}{4}$ LINES FROM W $\frac{1}{4}$ COR TO N $\frac{1}{4}$ COR SEC 34, 180-00-00 FROM S $\frac{1}{4}$ COR SEC 34 TO N $\frac{1}{4}$ COR SEC 34, 88-31-45 FROM E $\frac{1}{4}$ COR SEC 34 TO S $\frac{1}{4}$ COR SEC 34, & 91-28-15 FROM N $\frac{1}{4}$ COR SEC 34 TO E $\frac{1}{4}$ COR SEC 34.

FD CI IN PVC PIPE.

C) Was the corner restored through acceptance of (1) an obliterated evidence location, or, (2) a found perpetuated location?

. ACCEPTED FD C.I. MON.

- D) Describe any material discrepancy between the location of the corner as restored or reestablished and the location of that corner as previously restored or reestablished by distance and direction. Show the discrepancy on the plan view drawing under (a), above. Show the distances between the corner as previously restored or reestablished and (1) the corner as restored or reestablished, and (2) to at least 4 of the witness monuments shown on the drawing in (a), above.
- (E) Was the corner reestablished through lost corner proportionate methods? If so, show the method, including the directions and distances to other public land survey corners used as evidence or used for proportioning the corner location.
- I, **Donald Barnes**, hereby certify that the corner location as identified by the corner code index was determined by me under my direction and control and that this U.S. Public Land Survey Monument Record is correct and complete to the best of my knowledge and belief.

SHEET 1 OF 2

CORNER CODE V-15(2)

A.E. 7.08 REQUIREMENT

Daves Bares OCT 29, 2003 CORNER

