

PUBLIC LAND SURVEY MONUMENT RECORD


For Public Land Survey Corners in the
T. ___ N., R. ___ E.

CORNER CODE INDEX

	1	2	3	4	5	6	7	8	9	10	11	12	13	14	15	16	17	18	19	20	21	22	23	24	25
A																									
B																									
C	6																								
D																									
E																									
F																									
G	7																								
H																									
I																									
J																									
K																									
L	18																								
M																									
N																									
O																									
P	19																								
Q																									
R																									
S																									
T	30																								
U																									
V																									
W																									
X	31																								
Y																									
Z																									

PLACE MONUMENT SYMBOL (◆) AT PROPER LOCATION ON ABOVE INDEX

EXAMPLE

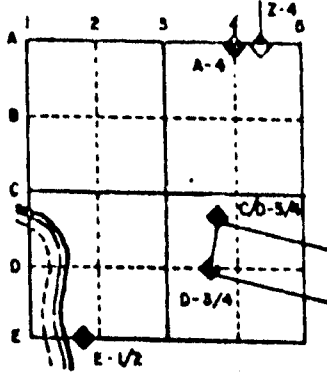

CLINTON TWP
ROCK COUNTY WI

IF AVAILABLE STATE PLANE COORDINATES

North (Y) _____ Eleve. (Z) _____
 East (X) _____ Zone _____
 Hor. Datum _____ Vert. Datum _____

◆ CORNER MONUMENT

○ WITNESS MONUMENT

BEARINGS ARE BASED ON:

SHEET ___ OF ___

CORNER CODE: Z-25 (1)

RECORD OF U. S. PUBLIC LAND SURVEY CONTROL STATION

U. S. PUBLIC LAND SURVEY CORNER 3631 T 1 N, R 15 E, WALWORTH COUNTY, WIS.

GEODETIC SURVEY BY: AYRES ASSOCIATES YEAR: 1992


STATE PLANE COORDINATES OF: TOWNSHIP CORNER
 NORTH 181,704.56
 EAST 2,330,017.74
 ELEVATION OF STATION: 966.011

HORIZONTAL DATUM: WISCONSIN STATE PLANE COORDINATE SYSTEM, SOUTH ZONE

VERTICAL DATUM: NATIONAL GEODETIC VERTICAL DATUM OF 1929

CONTROL ACCURACY:
 HORIZONTAL: THIRD ORDER, CLASS I VERTICAL: THETA ANGLE: + 0-50-26
SECOND ORDER, CLASS II

LOCATION SKETCH:

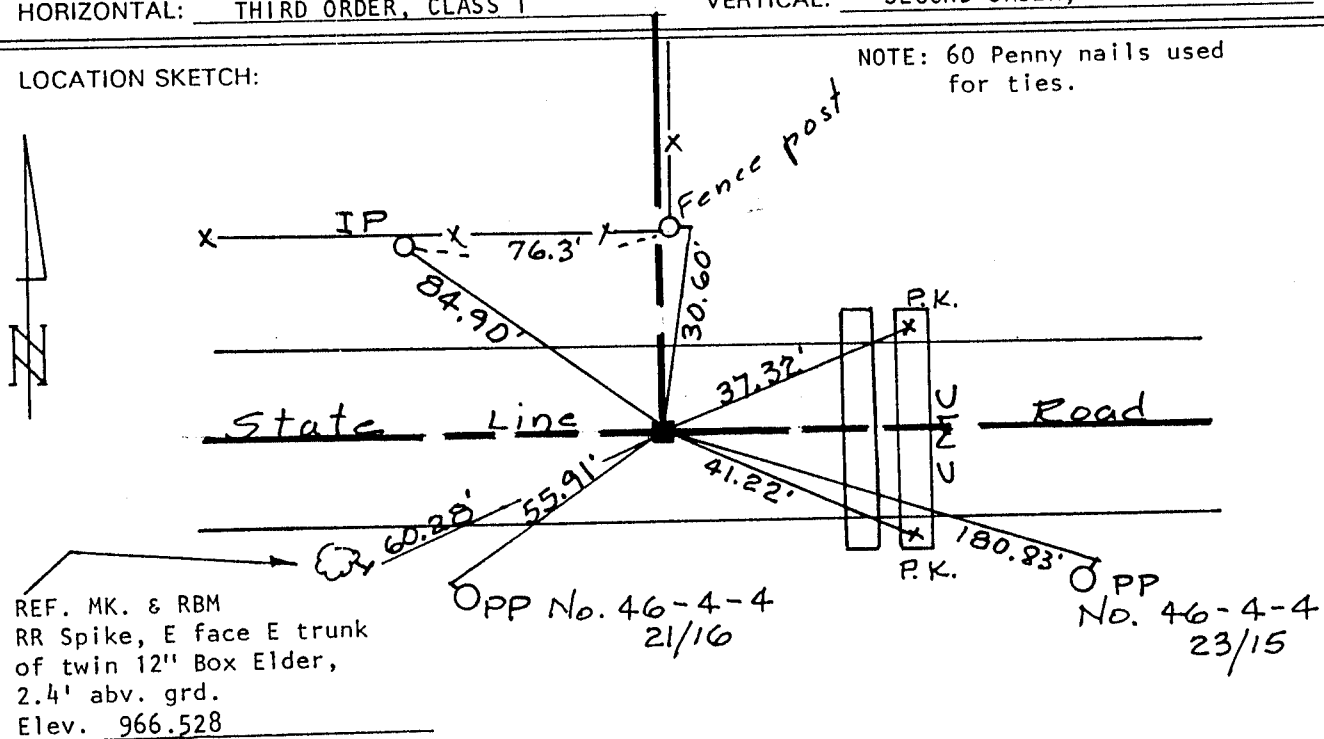

REF. MK. & RBM
 RR Spike, E face E trunk
 of twin 12" Box Elder,
 2.4' abv. grd.
 Elev. 966.528

■ — Concrete County Monument

Bearing: N 88-19-25 E
 To Traverse Sta. 9783

SURVEYOR'S AFFIDAVIT:

STATE OF WISCONSIN)
WALWORTH COUNTY) SS

I hereby certify that I have the following record of the Section corner location: "I hereby certify that I found a well decayed wood stake at 8.0 feet below road. Mark ended at 9.7 feet in light gray brown clay. Hit natural ground at 6.5 feet, H. Kolb, May 1974."

DATE OF SURVEY: 1974
4-21-92

Lloyd L. Jensen
 REGISTERED LAND SURVEYOR

S - 211

A-6

FORM PREPARED BY SOUTHEASTERN WISCONSIN REGIONAL PLANNING COMMISSION