
U.S.

PUBLIC LAND SURVEY MONUMENT RECORD

For Public Land Survey Corners in: T. & N., R. ____E WI ADMINISTRATIVE CODE A-E 7.08 REQUIREMENT

CORNER CODE INDEX

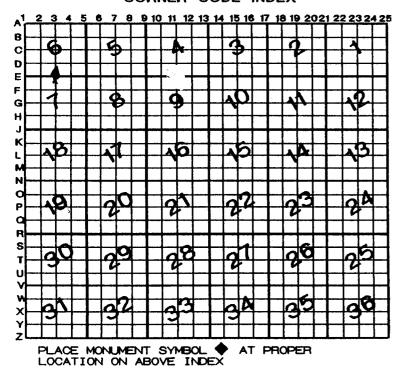

FULT	ON	TWI
ROCK	COUNTY	wı

IF AVAILABLE ROCK COUNTY COORDINATES PERFERRED

North ______ Elev. _____

East _____

Hor. Datum _____ Vert. Datum _____

LATITUDE _____ ELLIPS. HT.

LONGITUTE _____ ERLIPS. HT.

GPS (X) ____ TRAVERSE (X) ___

BASED ON THE FOLLOWING CONTROL:

•	CO	RN	IER	M	O	ΝL	JME	NT

O WITNESS MONUMENT

BEARINGS ARE BASED ON:

(a)

OBSERVATION SHEET	, 2
FIELD BOOKPAGE #	SHEET \bot OF $\overset{2}{=}$
SHOW A PLAN VIEW DRAWING DEPICTING THE CORNER MONUMENT ANI	SURROUNDING
PHYSICAL FEATURES, INCLUDING THE EXCAVATION AREA AND DEPTH.	-2(2)
PLANNING & ZONING COMMITTEE ADOPTED THE ABOVE FORM ON 12/2/1982	E-3 (2)

FU526

- (B)Describe any record evidence, monument evidence, occupational evidence, testimonial evidence or any other material evidence you considered, and whether the monument was found or placed.
- 1882 RUGER VOL 2 PG 390 CALLS FOR STAKE. VAR 6-30 TO SE COR SEC 4.
- 1883 RUGER VOL 2 PG 412 STATES NOTHING ABOUT MONUMENT. CALLS FOR 2696.76 TO SW COR SEC 4 WITH 1/16th COR ON LINE.
- 18?? RUGER VOL 5 PG 431 FIELD BOOK R-K PG 144. FOUND OLD STAKE & STUMP OF SE, SW, & NW BEARING TREES. SET IRREGULAR POINTED HH 17X9X7 SURROUNDED BY 5 HH.
- 1974 WPL VOL 6 PG 303 N88-34-38E 2701.45 FROM SW TO S 1/4 COR SEC 4.
- 1978 SANDNESS VOL 5 PG 447 N/S 304,907.417; E/W 2,246,298.976.
- 1985 WEIR E-11 FOUND 2" DIA. IRON PIPE. PREVIOUS SURVEYS REFERENCED TO THE CORNER STATE THAT A 2" DIA. IRON PIPE WAS FOUND AND USED ACCEPTED AS THE NORTH 1/4 CORNER OF SECTION. THERE WAS NO PREVIOUS TIE SHEET FOR THIS CORNER AT THE COUNTY SURVEYORS OFFICE. A SURVEY BY B.J. SUNNY, DATED JULY 14 & 16, 1942 STATES THAT HE SET A 2"X30" IRON PIPE AT THE NORTH 1/4 WHEN DOING A SURVEY OF OUTLOT 185 OF THE ASSESSOR'S PLAT OF THE CITY OF EDGERTON. I ACCEPTED THE IRON PIPE AS REPRESENTING THE NORTH 1/4 CORNER OF SECTION 9 AND TIED AS SHOWN BELOW.
- 1998 REIGEL E-11(1) I FOUND A 2" IRON PIPE AS OPPOSED TO AN ALUMINUM MONUMENT CALLED FOR ON CSM NO 650, VOL 18 PAGES 262-264. I VERIFIED ITS POSITION USING CSM NO 650 AND SET 4 TIES AS SHOWN.

FOUND ALUMINUM MONUMENT WITH TOP BROKE OFF. MONUMENT IS ABOUT 0.7' DEEP.

C) Was the corner restored through acceptance of (1) an obliterated evidence location, or, (2) a found perpetuated location?

ACCEPTED FOUND PERPETUATED LOCATION.

- D) Describe any material discrepancy between the location of the corner as restored or reestablished and the location of that corner as previously restored or reestablished by distance and direction. Show the discrepancy on the plan view drawing under (a), above. Show the distances between the corner as previously restored or reestablished and (1) the corner as restored or reestablished, and (2) to at least 4 of the witness monuments shown on the drawing in (a), above.
- (E) Was the corner reestablished through lost corner proportionate methods? If so, show the method, including the directions and distances to other public land survey corners used as evidence or used for proportioning the corner location.
- I, Donald Barnes, hereby certify that the corner location as identified by the corner code index was determined by me under my direction and control and that this U.S. Public Land Survey Monument Record is correct and complete to the best of my knowledge and belief.


Donald Bours May 6, 1999

emhoss

Number of included sheets 1

CORNER CODE

F-3 (2)

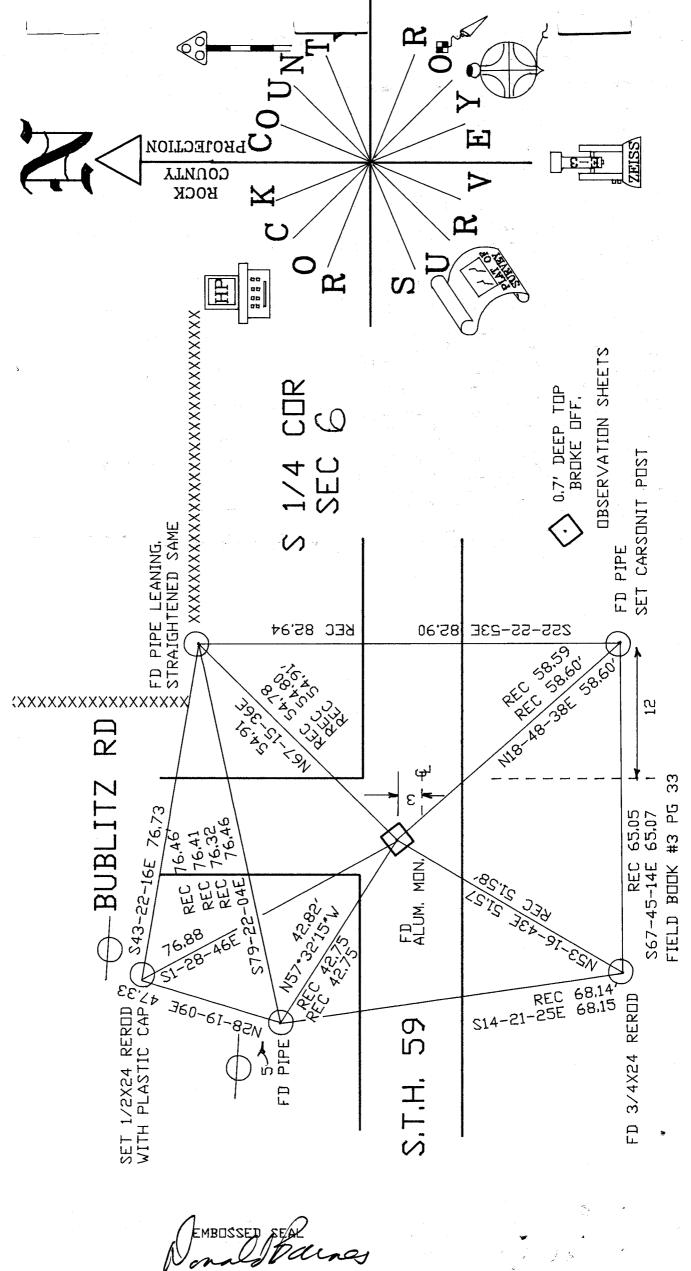

MBOSSED SER na Stain 'az 6,1999