
## ு. ு. ச்UBLIC LAND SURVET MONUMENT RECORD

For Public Land Survey Corners in the T. 4 N., R. 13 E

CORNER CODE INDEX

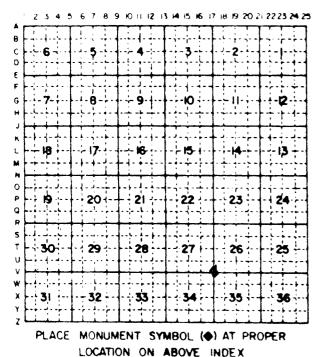

A 2 3 A-4 ROCK COUNTY WA

IF AVAILABLE
STATE PLANE COORDINATES

North (Y) 283,462,4 Eleve. (2)

East (X) 2,254,205,77 Zone

Hor. Datum NAP83 (1991) Vert. Datum

(a.)

CORNER MONUMENT

O WITNESS MONUMENT

LAT AZ-46-21, 83537

LON 88-56-09, Z6288

NIS 301, 897, 43

EIW 516, 602.89

Scale 0.9999975305

0 +0-05-33.3

E - 1/2



NAD83(1991) COORDINATES WERE PROVIDED BY STRAND ASSOCIATES FOR STH 26 PROJECT. CONVENTIONAL TRAVERSE WAS USED TO CONNECT SECTION CORNERS TO DOT GPS STATIONS. GPS STATIONS WERE ESTABLISHED PRIOR TO ROCK COUNTY'S GPS NETWORK. STRAND ASSOCIATES USED A SCALE FACTOR OF 0.99999500000 FOR REDUCING GROUND TO GRID DISTANCE. I USED STRANDS' STATE PLANE COORDINATES TO COMPUTE THE ABOVE LATITUDE, LONGITUDE, COUNTY COORDINATES, SCALE FACTOR, AND ANGLE BETWEEN THE TRUE NORTH AND COUNTY MAPPING PROJECTION NORTH.

FIELD BOOK \_\_\_ PAGE #

SHIW A PLAN VIEW DRAWING DEPICTING THE CORNER MONUMENT AND SURROUNDING PHYSICAL FEATURES, INCLUDING THE EXCAVATION AREA AND DEPTH. THE CORNER MONUMENT SHALL HAVE THE FOLLOWING CHARACTERISTICS. 1) HAVE AT LEAST TWO PREDETERMINED BREAK-OFF POINTS. 2) IF BROKEN, LEAVE A PERMANENTLY MAGNETIZED REMNANT AT THE ORIGINAL POINT. 3) MUST BE EXTENDABLE. 4) THE CAP SINSCRIBED ROCK COUNTY SURVEY MONUMENT - PENALTY FOR DISTURBING MARKER. 5) OR AN EXISTING CUT LIMESTONE. AN IRON PIPE 1 A SIMPLEMENT OF THE CORNER IS OCCUPIED BY AN IMPROVEMENT (MANHOLE, BURIED CABLE, ETC.) ANY DURABLE, DISTINCT MONUMENT MAY BE USED. CORNERS SHALL BE REFERENCED WITH AT LEAST 4 DURABLE WITHESS MONUMENTS. SHALL BE MADE OF CONCRETE, NATURAL STONE, IRON OR OTHER EQUALLY DURABLE MATERIAL, EXCEPT WOOD. DESCRIBE THE CORNER AND THE WITNESS MONUMENTS.

V17(2)

		_
. }	Describe any record evidence, monument evidence any other material evidence you considered, as	e. occupational evidence, testimonial evidence or and whether the monument was found or placed.
	MA	
)	Was the corner restored through acceptance of found perpetuated location?	(1) an obliterated evidence location, or, (2) a
	NA	
	, , ,	
)	Describe any material discrepancy between the reestablished and the location of that corner by distance and direction. Show the discrepal above. Show the distances between the corner and (1) the corner as restored or reestablishmonuments shown on the drawing in (a), above.	ncy on the plan view drawing under (a),
	A. A.	
	<b>~</b> 1,	
)	Was the corner reestablished through lost co- method, including the directions and distance evidence or used for proportioning in determ	rner proportionate methods? If so, show the est to other public land survey corners used as
		, and control total trong
	recovered or restored as expres	by certify—that the corner points endex were, in a field survey on restablished, monumented, re-monumented sed below and in conformance with the ed in the current manual of survey es Department of Interior, Bureau
	COU	NTY SURVEYOR FILING DATA
		c of Computer Entry
	Dat	e Received
	Monald Dat	e Microfilmed
	Barnes Tre	asurer's Receipt No.