U.S.


## PUBLIC LAND SURVEY MONUMENT RECORD

For Public Land Survey Corners in:

WI ADMINISTRATIVE CODE A-E 7.08 REQUIREMENT

T. 4 N., R. 13 E

CORNER CODE INDEX

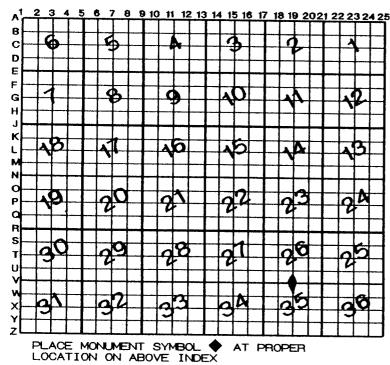

Mil	TW		
ROCK	COUNTY	WI	

IF AVAILABLE ROCK COUNTY COORDINATES PERFERRED


North	Elev
East	
Hor. Datum	Vert. Datum
LATITUDE _	ELLIPS. H
LONGITUTE _	
GPS (X)	TRAVERSE (X)
BASED ON THE	FOLLOWING CONTROL:

WITNESS MONUMEN
-----------------

BEARINGS ARE BASED ON:

(a)

FIELD BOOKPAGE #	SHEET/	_ OF	2
SHOW A PLAN VIEW DRAWING DEPICTING THE CORNER MONUMENT AND	D SURROUNDIN	IG	
PHYSICAL FEATURES, INCLUDING THE EXCAVATION AREA AND DEPTH.		•	
PLANNING & ZONING COMMITTEE ADOPTED THE ABOVE FORM ON 12/2/1982			

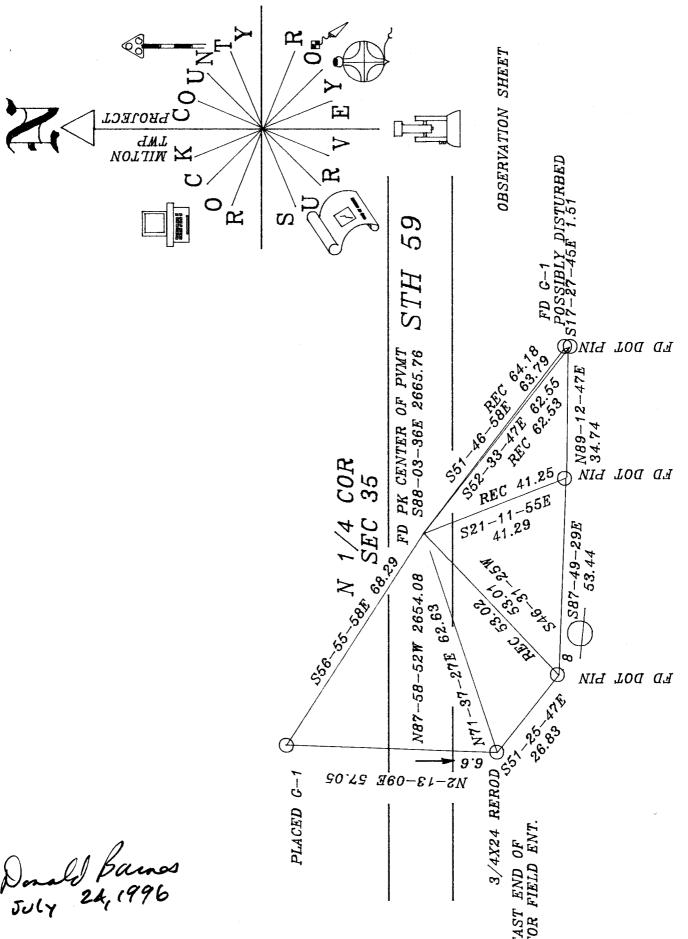

V19(2)

(B) Describe any record evidence, monument evidence, occupational evidence, testimonial evidence or any other material evidence you considered, and whether the monument was found or placed. 1982 BARNES V-19 FOUND CAST IRON MONUMENT & REFERENCED. 1985 WIDOT V-19(1) FOUND CAST IRON MONUMENT & REFERENCED SAME.

FD G-1 MONUMENT ON SOUTH SIDE OF STR 09 PARTIALLY IN GROUND. EASET OF NORTH SIDE OF ROAD. ONLY 1 TIE THAT WAS FLACED IN 1942 REMAINS. IT APPEARS TO HAVE BEEN DISTURBED. FOUND PK & CENTER OF PAVENTED THAT AGREED WITH DOT TIES. THE TIE AGREES WITH THE DISTANCE TO THE HW CORNER OF SEC 35. ELEVATION OF PAVEMENT IS 882.3 AND THE RECORD ELEVATION OF THE CAST IRON IS 881.7.

C) Was the corner restored through acceptance of (1) an obliterated evidence location, or, (2) a found perpetuated location? ACCEPTED FOUND PK.

- D) Describe any material discrepancy between the location of the corner as restored or reestablished and the location of that corner as previously restored or reestablished by distance and direction. Show the discrepancy on the plan view drawing under (a), above. Show the distances between the corner as previously restored or reestablished and (1) the corner as restored or reestablished, and (2) to at least 4 of the witness monuments shown on the drawing in (a), above.
- (E) Was the corner reestablished through lost corner proportionate methods? If so, show the method, including the directions and distances to other public land survey corners used as evidence or used for proportioning the corner location.
- I, Donald Barnes, hereby certify that the corner location as identified by the corner code index was determined by me under by direction and control and that this U.S. Public Land Survey Monument Record is correct and complete to the best of my knowledge and belief.

Number of included sheets

CORNER CODE

Inall Baines emboss 7/24/96

V19(2)