Paper weight- 32# 25% Rag Ledger (minimum)

Black nonfading inh रह्माण्डित

TUBLIC MONUMENT

SUPVEY RECORD

For Public Land Survey Corners in the T. 4 N., R. 12 E

CORNER CODE INDEX

7 8 910111213141516171819202122232425 7 6 DEFGH 10 12 9 8 17 10 20 22 26 zb

FULTON	
1.77	TWP

ROCK COUNTY WI

	COORDINATES PERFERED
North	Elev.
East	
Hor. Datum	Vert. Datum
GPS (X)	TRAVERSE (X)
BASED ON THE FOLLO	WING CONTROL:

PLACE MONUMENT SYMBOL & LOCATION ON ABOVE INDEX

CORNER MONUMENT

O WITHESS MONUMENT


(a)

BEARINGS ARE BASED ON:

FIELD BOOK PAGE
SHOW A PLAN VIEW DRAWING DEPICTING THE CORNER MONDMENT
THE FOLLOWING CHARACTERISTICS: 1) HAVE A LEAST TWO PRED
30 MUST BE EXTENDABLE. 40 THE CAP IS INSCRIBED TROCK CO.
47 ININIMUM MAY BE USED IN ARRES M-RER GROUND WATER IS W
DURABLE, DISTINCT MONDMENT MAY BE USED. COTHERS SHALL B
STONE, IRON OR OTHER EQUÂLLY DURABLE MATERIAL E-CEPT MOD

PLAINING & ZONING CONMITTEE ADOPTED THE ABOVE FORM ON 12/2/1982 WI ADMINISTRATIVE CODE A-E 7.08 REQUIREMENT

SHEET ______OF _____

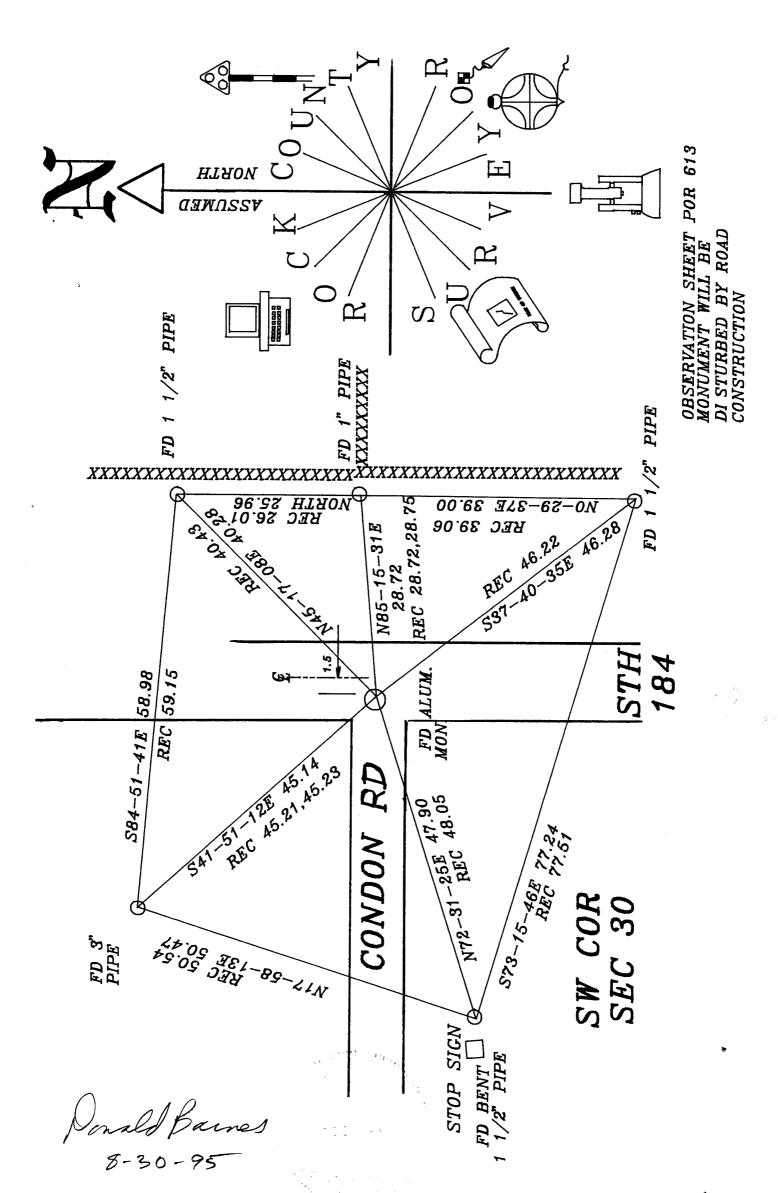

V/(Z)

- (B) Describe any record evidence, monument evidence, occupational evidence, testimonial evidence or any other material evidence you considered, and whether the monument was found or placed. FOUND MONUMENT AS SHOWN IN DRAWING.
- C) Was the corner restored through acceptance of (1) an obliterated evidence location, or, (2) a found perpetuated location?
 THE MONUMENT WILL BE DISTURBED BY ROAD CONSTRUCTION. CORNER PERPETUATED AS FOUND.
- D) Describe any material discrepancy between the location of the corner as restored or reestablished and the location of that corner as previously restored or reestablished by distance and direction. Show the discrepancy on the plan view drawing under (a), above. Show the distances between the corner as previously restored or reestablished and (1) the corner as restored or reestablished, and (2) to at least 4 of the witness monuments shown on the drawing in (a), above.
- (E) Was the corner reestablished through lost corner proportionate methods? If so, show the method, including the directions and distances to other public land survey corners used as evidence or used for proportioning the corner location.

I, Donald Barnes, hereby certify that the corner points as identified by the corner code index were, in a field survey on, JULY 31,1995, established, re-established, monumented, re-monumented, recovered or restored as expressed below and in conformance with the regulations and rules as required in the current manual of survey instructions of the United States Department of Interior, Bureau of Land Management.

			COUNTY SURVEYOR FILING DATA
seal Harry A.		Date of computer entry	
	7 .		Date microfilmed
Donald Bornes		in the second se	Number of included sheets CORNER CODE
EMBOSS LAND SURVEYOR SEAL 8-30-95	A-E	7.08	REQUIREMENT