
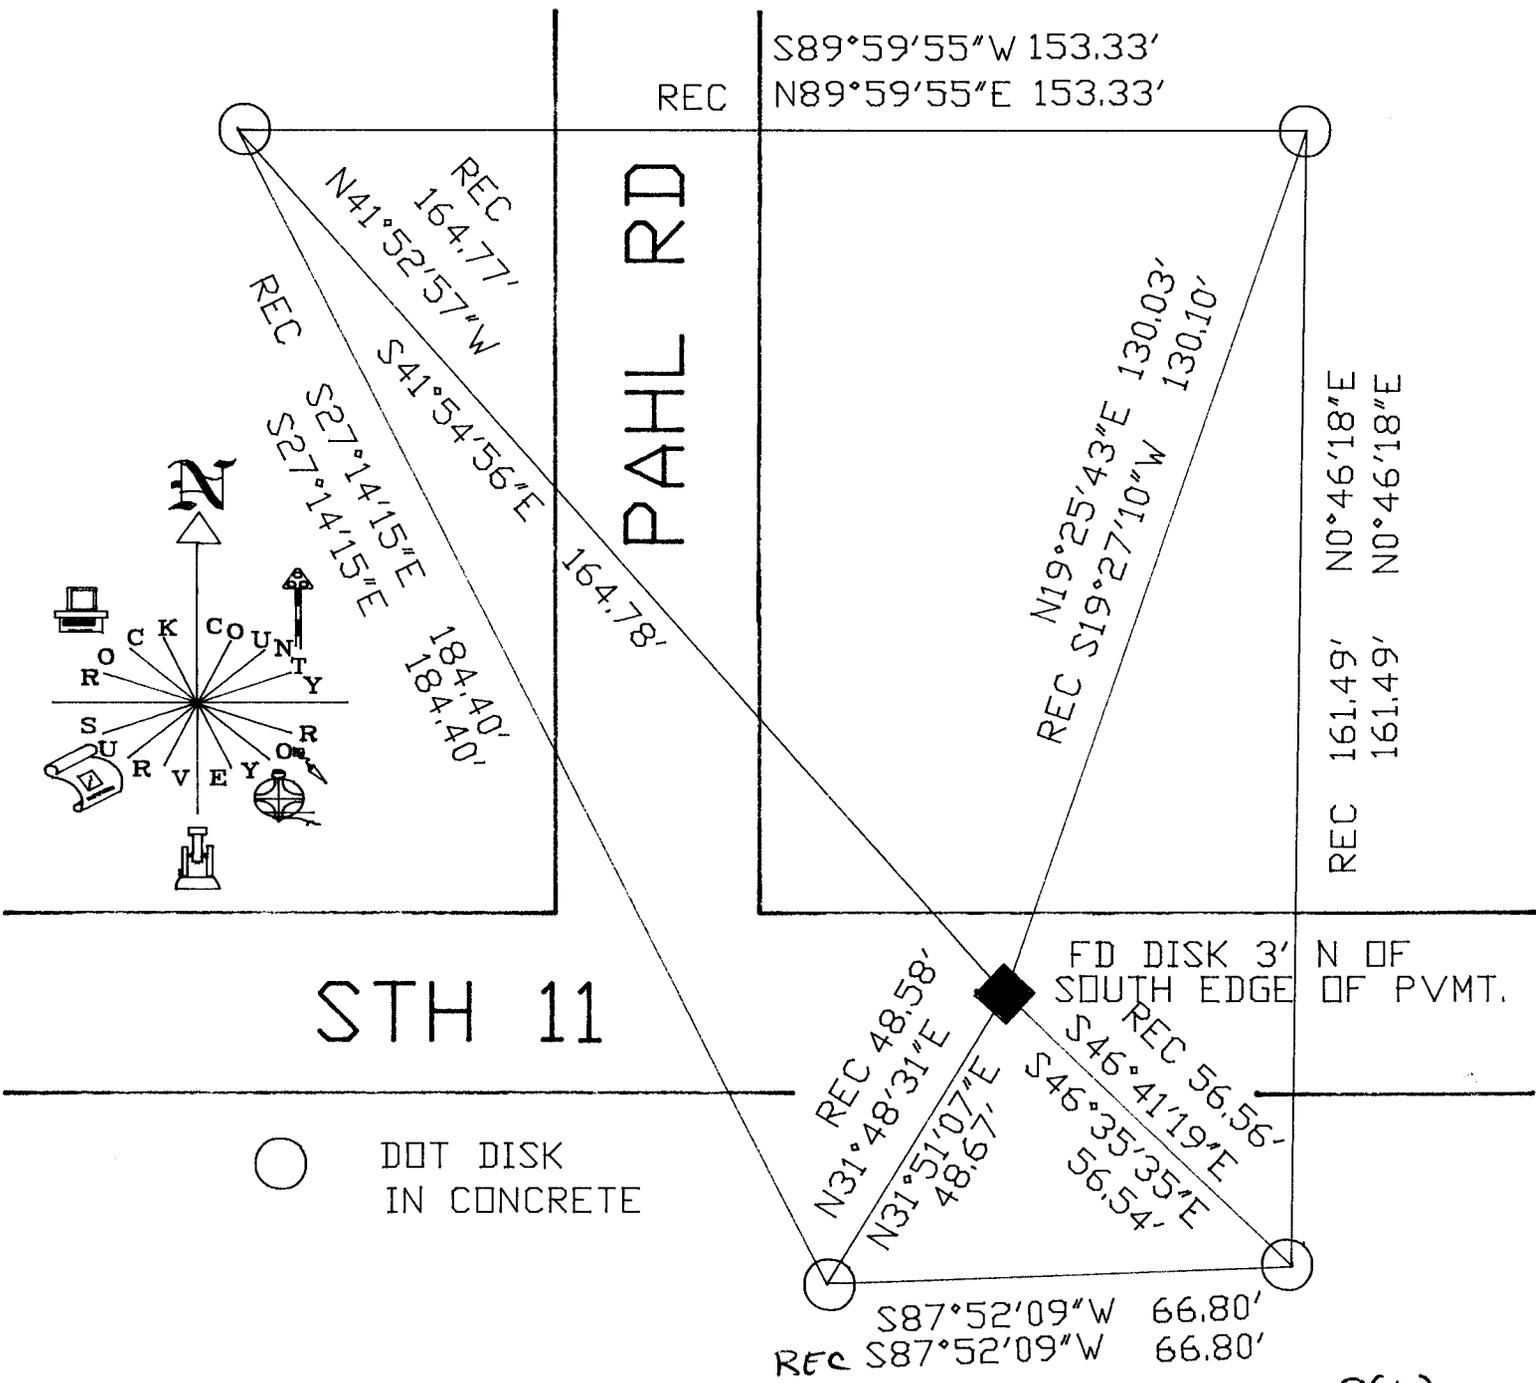


Donald Barnes
11/30/92

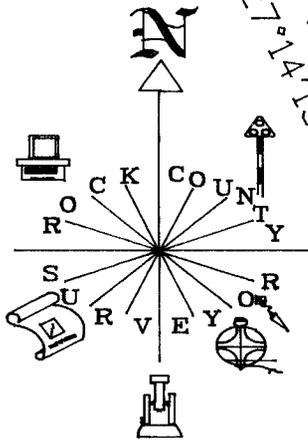

X9(1)

(B) Describe any record evidence, monument evidence, occupational
evid. stimonial evidence o her material evidenc
considered, and whether the monument was found or placed. _____
FOUND DOT DISK.

C) Was the corner restored through acceptance of (1) an obliterated
evidence location, or, (2) a found perpetuated location?
DID NOT ACCEPT FOUND DOT DISK

D) Describe any material discrepancy between the location of the
corner as restored or reestablished and the location of that corner as
previously restored or reestablished by distance and direction. Show
the discrepancy on the plan view drawing under (a), above. Show the
distances between the corner as previously restored or reestablished
and (1) the corner as restored or reestablished, and (2) to at least 4
of the witness monuments shown on the drawing in (a), above.
THE DISK IS 0.05' NORTH AND 0.08' EAST OF THE CORRECT LOCATION.

(E) Was the corner reestablished through lost corner proportionate
methods? If so, show the method, including the directions and
distances to other public land survey corners used as evidence or used
for proportioning the corner location.

I, Donald Barnes, hereby certify that the corner points as identified
by the corner code index were, in a field survey on, November 9, 1992,
established, re-established, monumented, re-monumented, recovered or
restored as expressed below and in conformance with the regulations and
rules as required in the current manual of survey instructions of the
United States Department of Interior, Bureau of Land Management.

Donald Barnes
Seal

11/30/92

COUNTY SURVEYOR FILING DATA

Date of computer entry _____

Date microfilmed _____

Number of included sheets _____
CORNER CODE

AFFIX YOUR LAND SURVEYOR SEAL

x 9(1)