



(B) Describe any record evidence, monument evidence, occupational evidence, testimonial evidence or any other material evidence you considered, and whether the monument was found or placed.

1834 MILLER SET 1/4 SECTION POST IN MOUND OF EARTH AND SOD. 2383.92 TO NE CORNER OF SECTION 3.

1855 CHURCH VOL 1 PG 43. STAKE CORRECT WITH FIELD NOTES. SHOWS THE FOLLOWING:

2678.28 TO CENTER OF SECTION 3

5356.56 TO W 1/4 CORNER OF SECTION 3

1861 RUGER VOL 1 PG 150 THE EAST QUARTER POST BEING GONE PUT IT IN FROM THE SECTION CORNERS. DID NOT STATE WHAT HE PLACED. SHOWS THAT IS ON A STRAIGHT LINE BETWEEN THE SE AND NE CORNERS OF SECTION 3. SHOWS THE FOLLOWING DISTANCES:

2341.35 TO THE NE CORNER OF SECTION 3

2592.48 TO THE SE CORNER OF SECTION 3

2680.26 TO THE CENTER OF SECTION 3

5360.52 TO THE W 1/4 CORNER OF SECTION 3

1929 BATTERMAN VOL 3 PG 159 FOUND OLD STAKE ROTTED AND HOLE SURROUNDED BY 3 HH 6" NORTH OF E/W FENCE AND 6" WEST OF N/S FENCE.

1932 SUNNY VOL 3 PG 159 SHOWS NEW TIES WITH CORNER 11.92 WEST OF CENTER OF PAVEMENT. USES 2 OF BATTERMAN'S REFERENCE PIPES.

1985 DOT C-17 FOUND 1" PIPE AND REFERENCED SAME.


FOUND 1" PIPE 20" DEEP. PLACED A MAGNET ON TOP OF THE PIPE AND REFERENCED SAME. DISTANCES TO THE NE AND SE CORNERS OF SECTION 3 ARE NOT IN HARMONY WITH RUGER'S 1861 DISTANCES. ACCORDING TO RUGER'S VAR., HE INTENDED TO PLACE THE CORNER ON A STRAIGHT LINE BETWEEN THE NE AND SE CORNERS. THE 1950 AIR PHOTOS SHOWS THAT THE E/W FENCE JOGS TO THE NORTH AT THE S 1/16 THE CORNER OF THE NE 1/4 OF SECTION 3. THE PHOTO ALSO INDICATES THAT THERE IS A E/W FENCED IN LANE THAT ALSO COMMENCES AT THIS POINT AND CONTINUES EAST. ALSO THE DISTANCE FROM THE N 1/4 CORNER TO THE E/W QUARTER LINE IS NOT IN HARMONY WITH RUGER'S DISTANCE. SINCE THE TERRIAN INDICATES THAT THERE WAS A ROAD CUT, I DID NOT EXCAVATE FOR RUGER'S OLD MONUMENT.

C) Was the corner restored through acceptance of (1) an obliterated evidence location, or, (2) a found perpetuated location?

ACCEPTED FOUND PIPE WHICH PERPETUATES THE OLD STAKE SURROUNDED BY 3 HH THAT BATTERMAN FOUND IN 1929.

D) Describe any material discrepancy between the location of the corner as restored or reestablished and the location of that corner as previously restored or reestablished by distance and direction. Show the discrepancy on the plan view drawing under (a), above. Show the distances between the corner as previously restored or reestablished and (1) the corner as restored or reestablished, and (2) to at least 4 of the witness monuments shown on the drawing in (a), above.

I, Donald Barnes, hereby certify that the corner points as identified by the corner code index were, in a field survey on, August 20, 1990, established, re-established, monumented, re-monumented, recovered or restored as expressed below and in conformance with the regulations and rules as required in the current manual of survey instructions of the United States Department of Interior Bureau of Land Management.

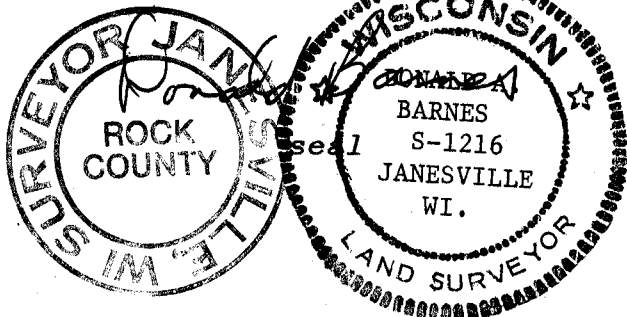

COUNTY SURVEYOR FILING DATA

Date of computer entry \_\_\_\_\_

Date microfilmed \_\_\_\_\_

Number of included sheets \_\_\_\_\_

CORNER CODE

AFFIX YOUR LAND SURVEYOR SEAL

C 17 (1)