
WI ADMINISTRATIVE CODE A-E 7.08 REQUIREMENT

PUBLIC LAND U.S. SURVEY MONUMENT RECORD

For Public Land Survey Corners in: T. 3N., R. //_E

CORNER CODE INDEX

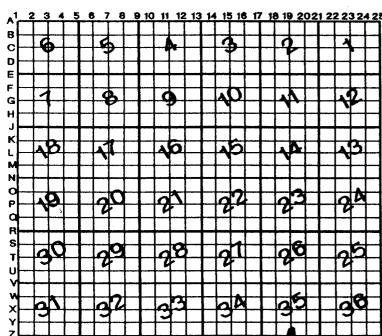

CENTER

ROCK COUNTY WI

IF AVAILABLE ROCK COUNTY COORDINATES PERFERRED

North _

Hor. Datum _____ Vert. Datum __

LATITUDE _____ ____ ELLIPS. HT.

LONGITUTE ____

GPS (X) __ TRAVERSE (X) __

BASED ON THE FOLLOWING CONTROL:

♦CORNER MONUMENT

PLACE MONUMENT SYMBOL & LOCATION ON ABOVE INDEX

WITNESS MONUMENT

BEARINGS ARE BASED ON:

(a)

	SHEET OF	3
FIELD BOOKPAGE #	SHEET OF	
SHOW A PLAN VIEW DRAWING DEPICTING THE CORNER MONUMENT AND	SURROUNDING	
PHYSICAL FEATURES, INCLUDING THE EXCAVATION AREA AND DEPTH.		
PLANNING & ZONING COMMITTEE ADOPTED THE ABOVE FORM ON 12/2/1982		

- (B) Describe any record evidence, monument evidence, occupational evidence, testimonial evidence or any other material evidence you considered, and whether the monument was found or placed.
- 1868 LOCKE REMONUMENTATIN INTERSECTED ¼ LINE FOR TOWN 3 7.26' NORTH OF COR. FOUND STONE WITH STAKE SET BY ANDREW CODDINGTON IN OLD MOUND. COR IN CENTER OF HWY & IN LINE OF FENCE RUNNING NORTH. PLACED NORTH ¼ COR OF SECTION 2 0.66' WEST OF ¼ COR OF SECTION 35. PLACED CUT LIMESTONE AT NORTH ¼ COR. SHOWS A DISTANCE OF 2657.49' FROM THE SW TO S ¼ CORNERS OF SEC 35.
- 1877 RUGER VOL 2 PG 234 SUBDIVIDED SECTION 2 STATES NOTHING ABOUT THE S ¼ COR BUT STATES THAT THE N ¼ COR OF SECTION 2 IS SOUTH OF A LINE DRAWN FROM THE NW TO NE CORNERS OF SEC 2.
- 1933 SUNNY VOL 3 PG 235 AT THE N ¼ COR OF SECTION 2 SET 1"X36" PIPE IN CONCRETE PAVEMENT 8.0' SOUTH OF CENTER OF SAME. SHOWS A DISTANCE OF 2656.9 TO BOTH THE NW AND NE CORNERS OF SECTION 2. SHOWS THE N ¼ COR 0.66' WEST OF THE S ¼ COR OF SECTION 35. STATES NOTHING ABOUT THE S ¼ COR.
- 1977 BARNES VOL 6 PG 364 PLACED ALUM. MONUMENT ON LINE WITH N ¼ COR OF SECTION 2 AND THE NE COR OF SECTION 2 AT RECORD DISTANCE, 0.66'. AT N ¼ COR OF SEC 2 FOUND 1" PIPE 0.2' DEEP.
- 1988 BARNES A19 DUG AND FOUND CUT LIMESTONE 26" DEEP AT THE N ¼ COR OF SEC 2 T2N R11E. THE STONE IS 3.26' FROM THE ALUMINUM MONUMENT. REJECTED THE PERPETUATED LOCATION THAT SUNNY ESTABLISHED IN 1933. ESTABLISHED THE SOUTH QUARTER ON LINE WITH THE CUT LIMESTONE AND THE NW CORNER OF SEC 2. DID NOT MONUMENT BECAUSE STH 11 WILL BE RECONSTRUCTED WITHIN THE NEXT TWO YEARS.
- 1992 BARNES Z-19(1) FOUND DOT DISK THAT APPEARED TO PERPETUATE THEIR STATION 379+20. ACCEPTED TIES OF RECORD. DOT DID NOT PLACE A MONUMENT

COMBS CONTACTED ME ABOUT EXISTING TIES. USED OLD OBSERVATIONS AND REDREW TIES TO CLARIFY THINGS.

C) Was the corner restored through acceptance of (1) an obliterated evidence location, or, (2) a found perpetuated location?


ACCEPTED TIES OF RECORD. DID NOT PLACE MONUMENT.

- D) Describe any material discrepancy between the location of the corner as restored or reestablished and the location of that corner as previously restored or reestablished by distance and direction. Show the discrepancy on the plan view drawing under (a), above. Show the distances between the corner as previously restored or reestablished and (1) the corner as restored or reestablished, and (2) to at least 4 of the witness monuments shown on the drawing in (a), above.
- (E) Was the corner reestablished through lost corner proportionate methods? If so, show the method, including the directions and distances to other public land survey corners used as evidence or used for proportioning the corner location.
- I, Donald Barnes, hereby certify that the corner location as identified by the corner code index was determined by me under my direction and control and that this U.S. Public Land Survey Monument Record is correct and complete to the best of my knowledge and belief.

seal

Number of included sheets 1

CORNER CODE Z19(2)

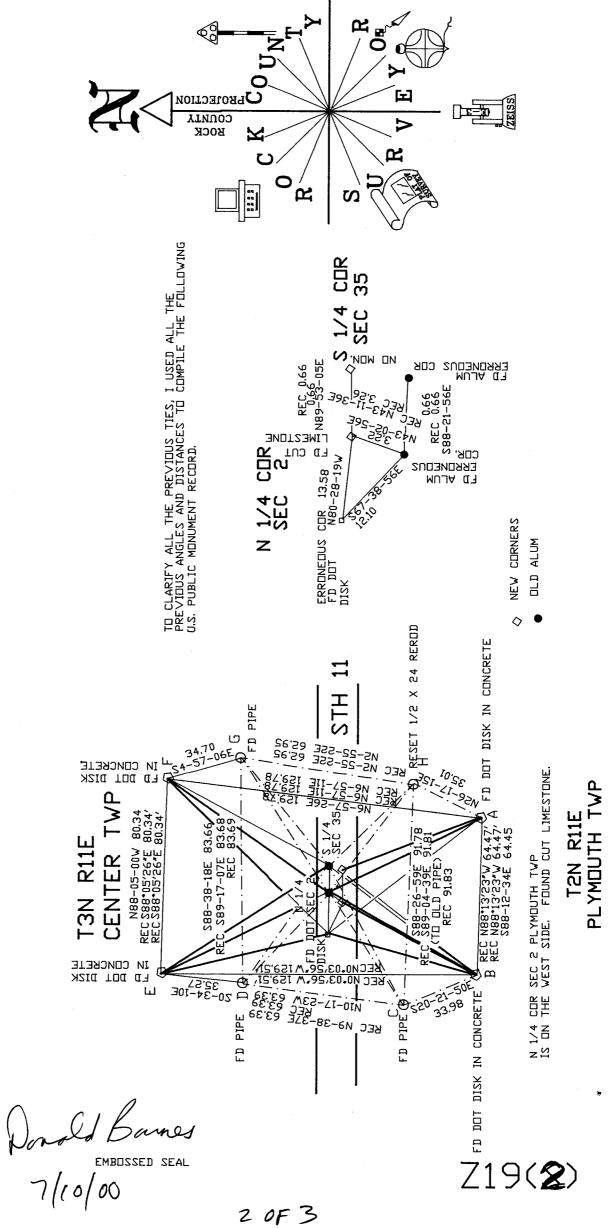

35 SEC e ERRONEDUS S 1/4 CDR Σ ND N ALUM. 00

RECORD

ณ

TO N 1/4 COR SEC

LIMESTONE

N25-02-20W 65.52 N32-36-47E 68.08 N62-17-12E 54.81 S45-14-30E 52.38 S27-03-06E 81.01 S32-01-32W 81.93 S53-04-53W 58.09 N57-05-57W 51.49 **TOUMPOT**

TO OLD ALUM. PERRONEOUS N 1. COR SEC 2 **AMUDMFDI**

N25-33-09W 65.81 N32-08-05E 67.74 N61-56-41E 54.23 S4-44-37E 51.90 S26-38-26E 80.70 S32-25-20W 82.27 S53-29-01W 58.61 N57-28-34W 52.06

S52-52-54W 58.5958.58 52.03 N25-32-52W 65.84 N32-07-16E 67.78 N61-55-02E 54.25 54.26 N61-14-59E 54.26 5 844-45-56E 51.87;51.87 51.90 82.25 58.59, 52.12, N32-25-45E S53-30-00W N58-03-15W

RECORD

a

54.58

TO CLARIFY ALL THE PREVIDUS TIES, I USED ALL THE PREVIDUS ANGLES AND DISTANCES TO COMPILE THE FOLLOWING U.S. PUBLIC MONUMENT RECORD.

Ā 2671.2 FROM DOT DISK TO DOT DISK RON COMBS REPORTED DISTANCE OF

31 SEC

COR SE

N23-00-52W 67.02 N32-38-34E 70.88 N60-34-50E 57.291 57.29 \$60-56-12W 57.27 \$48-15-39E 51.89 \$45-25-42W 51.871 51.891 51.90 \$31-58-29W 79.15 \$54-02-47W 55.47 \$53-26-04W 55.46 55.46 N54-00-23W 51.56 N58-35-21W 51.58 51.57 51.58 RECORD DISK TD ERRONEOUS DDT 1 N31-44-37W 75.23 N21-50-34E 66.76 S20-18-40E 72.01 S40-27-38E 85.22 N22-59-18W 67.06 N32-37-39E 70.91 N60-54-04E 57.29 S48-18-07E 51.88 S28-48-55E 79.64 S31-59-30W 79.10 S54-05-12W 55.44 N53-57-14W 51.57 **⊄**₩∪⊓⊩⊓±

N31-44-53E N21-50-46E S20-18-40E S40-27-14W

RECORD MDN, 1/4 COR SEC POSITION-NO M AEV P

N22-28-00W 66.80 N33-04-26W 71.27 N61-13-04E 57.86 S48-47-00E 52.37 S29-13-48E 79.96 S31-35-06W 78.76 S53-41-02W 54.91 N53-31-00W 51.03 **AWOUMFRI**

N60-34-50E 57.87 S49-25-18E 52.38

S53-01-53E 54,93 N54-09-07E 51.06 N22-28-50W 66.78 N33-05-18E 71.26 N61-14-37E 57.86 N6 S48-45-43E 52.38 S S29-13-32E 79.98 S31-34-07W 78.78 S53-39-04W 54.92 S1 N53-32-58W 51.03 N

Z19(2)

3 OF 3