

U.S. PUBLIC LAND SURVEY MONUMENT RECORD

For Public Land Survey Corners in:

WI ADMINISTRATIVE CODE A-E 7.08 REQUIREMENT

T. 1 N., R. 11 E

CORNER CODE INDEX

A	1	2	3	4	5	6	7	8	9	10	11	12	13	14	15	16	17	18	19	20	21	22	23	24	25
B																									
C	6																								
D																									
E																									
F	1																								
G																									
H																									
I																									
J																									
K																									
L	18																								
M																									
N																									
O																									
P	19																								
Q																									
R																									
S																									
T	30																								
U																									
V																									
W																									
X	31																								
Y																									
Z																									

NEWARK TWP

ROCK COUNTY WI

IF AVAILABLE
ROCK COUNTY COORDINATES PREFERRED

North _____ Elev. _____

East _____

Hor. Datum _____ Vert. Datum _____

LATITUDE _____ ELLIPS. HT. _____

LONGITUDE _____

GPS (X) _____ TRAVERSE (X) _____

BASED ON THE FOLLOWING CONTROL:

PLACE MONUMENT SYMBOL AT PROPER LOCATION ON ABOVE INDEX

CORNER MONUMENT

WITNESS MONUMENT

(a)

BEARINGS ARE BASED ON:

USED DATA FROM FIELD
BOOK # 1 Pg 54

FIELD BOOK _____ PAGE # _____

SHEET 1 OF 2

SHOW A PLAN VIEW DRAWING DEPICTING THE CORNER MONUMENT AND SURROUNDING PHYSICAL FEATURES, INCLUDING THE EXCAVATION AREA AND DEPTH.

PLANNING & ZONING COMMITTEE ADOPTED THE ABOVE FORM ON 12/2/1982

CORNER CODE A(17)(1)

NE509

(B) Describe any record evidence, monument evidence, occupational evidence, testimonial evidence or any other material evidence you considered, and whether the monument was found or placed.

- 1833 MULLETT WEST ON SOUTH SIDE SECTION 35
1387.32 WHITE OAK 10 IN DIAMETER
2640 SET QUARTER SECTION POST WHITE OAK 18 N69E 14.52'; WHITE OAK 14 N78W 23.76'
5280 SET POST CORNER SECTION 34 & 35 WHITE OAK 20 N62E 33'; WHITE OAK 3 N62W 24.42'
WEST ON SOUTH SIDE SECTION 34
2640 SET QUARTER SECTION POST WHITE OAK 16 N29E 155.76' BUR OAK; BUR OAK 12 N60 1/2W 167.64';
3960 ENTER PRAIRIE
5280 SET POST CORNER SECTIONS 33 & 34 MADE A MOUND OF STONES 3 FEET IN DIAMETER AT BASE & 3 FEET HIGH FIRST 3/4 THINLY TIMBERED WITH BLACK WHITE AND BUR OAK THICK UNDERGROWTH HAZEL BRIERS GRAPE VINES & LAST 1/4 RICH DRY PRAIRIE.
- 1833 HARRISON NORTH BET 34 & 35
2640 QUARTER SEC COR. BLK O 14 S57W 33'; W.O. 13 N26W 33'; BLK O 14 & W.O. 13 MARKED
4835.16 BUR O 13
5280 COR TO SECS 26,27,34,&35 W.O. 14 S16W 38.94'; BUR OA 11 S71E 132; BUR OAK 36 N78E 170.94'; BURR OAK 14 N70W 86.46'
- 1834 MILLER NORTH BET 2 & 3
2640 SET 1/4 SEC POST BUR OAK 12 S47E 274.56' , BUR OAK 12 N9E 4.03'
3960 LEAVE PRAIRIE
5326.2 INTERSECTED NORTH BOUNDARY 31.02 WEST OF POST. SET POST COR OF 2 & 3. BUR OAK 12 IN S45E 85.8', WHITE OAK 20 S80W 64.68' LAND GENTLY ROLLING 2ND RATE. MARCH 9, 1834
- 1868 LOCKE PLYMOUTH TWP REMONUMENTATION
PG 16 WEST ON SOUTH LINE SEC 34 VAR 6
264 SET OFF 3.3' SOUTH
528 SET OFF 6.6' SOUTH
792 SET OFF 1.32' SOUTH
1518 SET OFF 1.65' SOUTH
2673 INTERSECTED WEST BOUNDARY 30.36' SOUTH OF COR. FOUND LARGE LIMESTONE SET FOR CORNER COR IN CENTER HIGHWAYS RUNNING NE & W SET MONUMENT IN MOUND OF STONES COVERED WITH EARTH. VAR CORRECTED 5-43 1/4 MONUMENT MARKED 34 ON NORTH FACE.
PG 15 EAST ON SOUTH LNE OF SEC 35 VAR 5-30
330 SET OFF 15.18' NORTH
1716 SET OFF 6.27' NORTH
1452 SET OFF 4.29' NORTH
1848 SET OFF 46.86 NORTH
2696.1 INTERSECTED 1/4 LINE 52.8' NORTH OF COR. FOUND STUMP OF EAST BT AND WHERE WEST BT WAS DUG OUT AND OLD STAKE. COR. 3 FT NORTH OF E & W FENCE AND 3 FT WEST OF N & S FENCE VAR CORRECTED 5-56
CONTINUED EAST FROM 1/4 COR WITH VAR 5-50
5346 INTERSECTED EAST BOUNDARY 3.63' SOUTH OF COR. VAR CORRECTED 5-55 1/4 MONUMENT MARKED WITH FIGURE 35 ON NORTH FACE.
PG 14 SOUTH BETWEEN SEC 34 AND 35 VAR 6-55
2650.56 INTERSECTED 1/4 LINE AT COR. FOUND NORTH BT AND STUMP OF SOUTH BT AND OLD STAKE. COR IN CENTER OF HIGHWAY. CONTINUED SOUTH FROM 1/4 COR WITH VAR 6-30.
4092 SET OFF 15.51' EAST
4290 SET OFF 9.9' EAST
4488 SET OFF 12.21' WEST

Donald Baues

6-29-01

5148 SET OFF 19.8' WEST

5307.72 INTERSECTED SOUTH BOUNDARY 5.28' WEST OF COR. FOUND EAST BT AND STUMP OF WEST BT AND OLD STAKE. VAR CORRECTED 7-08 1/2 AUG 20, 1868

1871 COLLINS REMONUMENTATION PG 159 NORTH BETWEEN 2 & 3 VARIATION 6

2654.52 INTERSECT 1/4 LINE 7.26' EAST OF CORNER. SET 14 STONE IN CENTER OF HIGHWAY IN LINE WITH FENCE EAST. CORRECTED VARIATION 5-50

CONTINUED NORTH VARIATION 6

5497.14 INTERSECT TOWN LINE 38.28' EAST OF CORNER. SET STONE FOR CORNER OF 2 & 3 STUMPS OF WITNESS TREES. CORNER OF 34 & 35 T2 R11 IS 31.02 EAST. CORRECTED VARIATION 5-10

PG 160 EAST ON NORTH LINE OF 2 VARIATION 6-16

5454.24 SEC CORNER

BACK TO

2727.12 SET 1/4 STONE 1.98' EAST OF PLYMOUTH CORNER. OCT 21 1871

PG 173 EAST ON NORTH LINE OF SEC 3 VARIATION 5-50

5280 SECTION CORNER

BACK TO

2640 SET 1/4 STONE 1.98' EAST OF PLYMOUTH COR. OCT 26 1871

1873 RUGER VOL 2 PG 114 STONE MON @ SE COR SEC 34 VAR 6-21 2650.23' FROM SE COR SEC 34 TO E 1/4 COR SEC 34 & FROM SE COR SEC 34 TO S 1/4 COR SEC 34 2667.06' VAR 5-15.

1873 RUGER VOL 2 PG 116 STONE MON @ SE COR SEC 34. FROM SW COR SEC 35 TO W 1/4 COR SEC 35 2650.23' VAR 6-21 & FROM SW COR SEC 35 TO S 1/4 COR SEC 35 2684.88' VAR 5-27.

1873 RUGER VOL 2 PG 117 CALLS FOR STONE MON. 31.02' WEST OF STONE MON AT SE COR SEC 34.

1882 HOLMES VOL 2 PG 349 COR MON SOUTH 1440.71' TO 1/16TH COR & 2832.72' TO E 1/4 COR SEC 3.

1967 BATTERMAN VOL 4 PG 337 FD CUT L.S. 4X6X24 4' DEEP. REFERENCED SAME.

1986 BARNES VOL 6-358 30.17' TO SE COR SEC 34, 2738.99' TO E 1/4 COR SEC 3

1986 BARNES A-17& Z17 ESTABLISHED REFERENCE TIES. FOUND L.S. 3' DEEP PLACED POLY MON. ON TOP & PLACED CARSONITE NEXT TO MON. WEST OF PAVEMENT 30.17'.

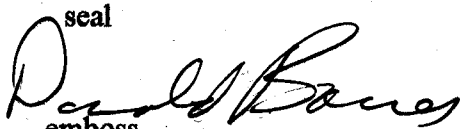
FOUND ALUM. MON & TIES.

C) Was the corner restored through acceptance of (1) an obliterated evidence location, or, (2) a found perpetuated location?

ACCEPTED FOUND ALUM. MON. AS PERPETUATED.

D) Describe any material discrepancy between the location of the corner as restored or reestablished and the location of that corner as previously restored or reestablished by distance and direction. Show the discrepancy on the plan view drawing under (a), above. Show the distances between the corner as previously restored or reestablished and (1) the corner as restored or reestablished, and (2) to at least 4 of the witness monuments shown on the drawing in (a), above.

I, Donald Barnes, hereby certify that the corner location as identified by the corner code index was determined by me under my direction and control and that this U.S. Public Land Survey Monument Record is correct and complete to the best of my knowledge and belief.

seal

emboss
6-29-01

SHEET 2 OF 2

CORNER CODE A-17(1)

A-E 7.08 REQUIREMENT