
PUBLIC LAND SURVEY MONUMENT RECORD

For Public Land Survey Corners in:

WI ADMINISTRATIVE CODE A-E 7.08 REQUIREMENT

T. _/N., R. _//__E

CORNER CODE INDEX

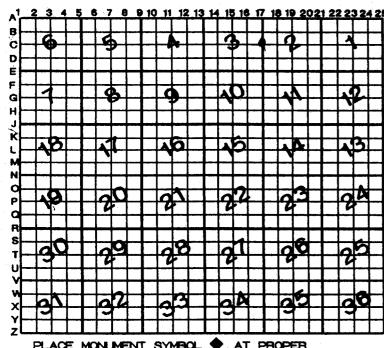

NEWARK ROCK COUNTY WI

IF AVAILABLE ROCK COUNTY COORDINATES PERFERRED

North Elev. East Hor. Datum _____ Vert. Datum __ELLIPS. HT. LONGITUTE GPS (X) ___ TRAVERSE (X) ___ BASED ON THE FOLLOWING. CONTROL:

CORNER MONUMENT

O WITNESS MONUMENT

Ż BEARINGS ARE BASED

(a)

FIELD BOOKPAGE #	SHEET
SHOW A PLAN VIEW DRAWING DEPICTING THE CORNER MO	NUMENT AND SURROUNDING
PHYSICAL FEATURES, INCLUDING THE EXCAVATION AREA A	ND DEPTH.
PLANNING & ZONING COMMITTEE ADOPTED THE ABOVE FORM ON 12/2	/1982

NE518

(B)Describe any record evidence, monument evidence, occupational evidence, testimonial evidence or any other material evidence you considered, and whether the monument was found or placed.

NORTH BET 2 & 3

2640 SET 1/4 SEC POST BUR OAK 12 S47E 274.56', BUR OAK 12 N9E 4.03'

3960 LEAVE PRAIRIE

5326.2 INTERSECTED NORTH BOUNDARY 31.02 WEST OF POST. SET POST COR OF 2 & 3. BUR OAK 12 IN S45E 85.8', WHITE OAK 20 S80W 64.68' LAND GENTLY ROLLING 2ND RATE. MARCH 9, 1834

1871 COLLIN REMONUMENTATION

NORTH BETWEEN 2 & 3 VARIATION 6

2654.52 INTERSECT 1/4 LINE 7.26' EAST OF CORNER. SET 14 STONE IN CENTER OF HIGHWAY IN LINE WITH FENCE EAST. CORRECTED VARIATION 5-50

CONTINUED NORTH VARIATION 6

- 5497.14 INTERSECT TOWN LINE 38.28' EAST OF CORNER. SET STONE FOR CORNER OF 2 & 3 STUMPS OF WITNESS TREES. CORNER OF 34 & 35 T2R11 IS 31.02' EAST. CORRECTED VARIATION 5-10
- 1873 RUGER VOL 2 PG 117 STONE MON. 2646.27' VAR 1-20 TO CENTER OF SEC 3 & 5304.92' TO W 1/4 COR SEC 3.
- 1882 HOLMES VOL 2 PG 349 1/4 MON. 2662.44' TO CENTER OF SEC 2, 5341.38' TO E 1/4 COR SEC 2, & 2832.72' TO NW COR SEC 2.
- 1986 BARNES VOL 6 PG 358 S0-14-57E 2648.06' TO SE COR SEC 3, N0-43-27W 1394.70' TO 1/16TH COR, & N0-42-42W 1444.29' FROM 1/16TH COR TO NE COR SEC 3.
- 1986 BARNES C-17 FD CUT STONE 1' BELOW RD PVMT. REFERENCED SAME. FIELD BOOK #1 PG 53 CALLS FOR 3.00' PK TIES TO NE & SE. LATER R.H. BATTERMAN CO. CALLED AND SAID PK TIES WERE PROBABLY 2.00'.

FD PK TIES 0.1' DEEP. SET MAG. NAIL 2.00' SOUTH AND WEST OF FD PKS. TOWNSHIP NETWORK ADJUSTMENT INDICATES THE FD NORTH PK IS THE 1/4 COR AND THE EASTERN PK IS THE 3.00' REFERENCE TIE. THE REPORTED 2.00' DISTANCES FROM PKS IS INCORRECT. THE ORIGINAL FIELD BOOK DISTANCES OF 3.00' ARE CORRECT. THIS WAS CONFIRMED BY FINDING A METAL SOUND 3.0X' TO THE NE OF COR. FD ERROR IN REDUCTION OF SLOPE TO HORIZONTAL IN OLD

C) Was the corner restored through acceptance of (1) an obliterated evidence location, or, (2) a found perpetuated location?

ACCEPTED FOUND PERPETUATED LOCATION.

D) Describe any material discrepancy between the location of the corner as restored or reestablished and the location of that corner as previously restored or reestablished by distance and direction. Show the discrepancy on the plan view drawing under (a), above. Show the distances between the corner as previously restored or reestablished and (1) the corner as restored or reestablished, and (2) to at least 4 of the witness monuments shown on the drawing in (a), above.

IN 1986, BATTERMAN USED THE PK AT THE CORNER AS ONE OF THE REFERENCE PKs & USED THE POSITION AS MONUMENTED BY THE MAG. NAIL AS THE 1/4 COR.

- (E) Was the corner reestablished through lost corner proportionate methods? If so, show the method, including the directions and distances to other public land survey corners used as evidence or used for proportioning the corner location. NA
- I, Donald Barnes, hereby certify that the corner location as identified by the corner code index was determined by me under my direction and control and that this U.S. Public Land Survey Monument Record is correct and complete to the best of my knowledge and belief.

Number of included sheets 1

Horale Baines emboss March 13, 2001

CORNER CODE C-17(1)

