

U.S. PUBLIC LAND SURVEY MONUMENT RECORD

For Public Land Survey Corners in:

WI ADMINISTRATIVE CODE A-E 7.08 REQUIREMENT

T. 1 N., R. 11 E

CORNER CODE INDEX

	1	2	3	4	5	6	7	8	9	10	11	12	13	14	15	16	17	18	19	20	21	22	23	24	25
A																									
B																									
C	6																								
D																									
E																									
F																									
G	7																								
H																									
I																									
J																									
K																									
L	18																								
M																									
N																									
O																									
P	19																								
Q																									
R																									
S																									
T	30																								
U																									
V																									
W																									
X	31																								
Y																									
Z																									

NEWARK TWP

ROCK COUNTY WI

IF AVAILABLE
ROCK COUNTY COORDINATES PREFERRED

North _____ Elev. _____

East _____

Hor. Datum _____ Vert. Datum _____

LATITUDE _____ ELLIPS. HT. _____

LONGITUDE _____

GPS (X) _____ TRAVERSE (X) _____

BASED ON THE FOLLOWING CONTROL:

PLACE MONUMENT SYMBOL AT PROPER LOCATION ON ABOVE INDEX

CORNER MONUMENT

WITNESS MONUMENT

(a)

BEARINGS ARE BASED ON:

FIELD BOOK _____ PAGE # _____

SHEET 1 OF 3

SHOW A PLAN VIEW DRAWING DEPICTING THE CORNER MONUMENT AND SURROUNDING PHYSICAL FEATURES, INCLUDING THE EXCAVATION AREA AND DEPTH.

PLANNING & ZONING COMMITTEE, ADOPTED THE ABOVE FORM CON 1222/3882

CORNER CODE A1 (2)

ne501

(B) Describe any record evidence, monument evidence, occupational evidence, testimonial evidence or any other material evidence you considered, and whether the monument was found or placed.

- 1833 MULLETT NORTH ON EAST SIDE SECTION 1 (T1N R10E)
539.22 BLACK OAK 12 IN DIAMETER
2640 SET QUARTER SECTION POST BLACK OAK 18 N36W 65.34'; BLACK OAK 8 S64W 177.54'
3794.34 BUR OAK 10 IN DIAMETER
5280 SET TEMPORARY 6 MILE POST LAND ROLLING SECOND RATE WHITE & BUR OAK. RED ROOT ROSE WILLOW. SEPT 4TH 1833.
- 1833 MULLETT WEST ON SOUTH SIDE SECTION 31 (T2N R11E)
660 LEAVE PRAIRIE & ENTER WOODLAND
2640 SET QUARTER SECTION POST BUR OAK 14 N31E 116.16'; BUR OAK 16 N42W 80.52'
5280 INTERSECTED RANGE LINE 264' SOUTH OF TEMPORARY POST FOR CORNER TO TOWNSHIP 1 & 2 N RANGES 10 & 11E. BUR OAK 14 S34E 15.84', BUR OAK 12 N82W 33', BUR OAK 12 S46W, BUR OAK 14 N68E. LAND ROLLING FIRST RATE BLACK WHITE AND BUR OAK. SEPT 6TH, 1833.
- 1833 MULLETT VAR 7-00 WEST ON SOUTH SIDE SECTION 36 (T2N R10E)
2640 SET QUARTER SECTION POST BUR OAK 12 N29W 49.5'; BUR OAK 12 N23E 49.5'
5280 SET POST CORNERS SECTIONS 35 & 36 BUR OAK 16 N 76 1/2W 229.02'; BUR OAK 14 N44 1/2E 145.2' LAND ROLLING FIRST RATE TIMBERED BLACK WHITE AND BUR OAK RED ROOT, HAZEL ROSE WILLOW. VAR BY OBSERVATION 7-40E
- 1833 MULLETT NORTH ON EAST SIDE OF SECTION 36 (T2N R10E) VAR 8-15E
2640 SET QUARTER SECTION POST BUR OAK 14 N73W 36.96'; BUR OAK S57W 35.64'
5280 SET POST CORNER SECTIONS 25 & 36 WHITE OAK 14 S52W 126.06'; BUR OAK 12 N38W 97.68'. LAND ROLLING SECOND RATE THINLY TIMBER BASED WITH W, BUR & BLK OAK.
- 1868 LOCKE PLYMOUTH TWP REMONUMENTATION SEPT 14 1868
PG 72 SOUTH ON WEST LINE SEC 31 VAR 7-30
1382.7 SMALL BROOK
1521.3 SMALL BROOK
2631.42 INTERSECTED 1/4 LINE 12.87' EAST OF COR. FOUND B.T.S COR IN CENTER OF ROAD AND 6.6' NORTH OF E AND W FENCES. VAR CORRECTED 7-18
SET OFF FROM 1/4 COR .66' WEST AND CONTINUED SOUTH WITH VAR 7-20
4092 SET OFF 9.57' WEST
5267.79 INTERSECTED SOUTH BOUNDARY 3.96' WEST OF COR. FOUND NORTH BT AND WHERE SOUTH BT WAS DUG OUT AND LARGE LIMESTONE ON COR. COR IN CENTER OF HIGHWAY. VAR CORRECTED 7-13
PG 73 EAST ON SOUTH LINE SEC 31 VAR 6 SEPT 14, 1868
2657.82 INTERSECTED 1/4 LINE 13.53' NORTH OF COR. FOUND WEST B.T. AND STUMP OF EAST B.T. COR. IN CENTER OF HIGHWAY AND IN LINE OF FENCE RUNNING SOUTH. VAR CORRECTED 5-43. CONTINUED EAST FROM 1/4 COR WITH VAR 6
5320.92 INTERSECTED EAST BOUNDARY 22.11' NORTH OF COR. VAR CORRECTED 5-31 1/4 MONUMENT MARKED 31 ON ITS NORTH FACE.

SHEET 1 OF 3

A-1(2)

Donald Barnes
Jan 4 2001

- 1871 COLLINS REMONUMENTATION NOTES (NOV 4TH 1871)
 PG 208 NORTH ON THE WEST LINE OF SEC 6. VARIATION 6-45
 2661.78 SET 1/4 STONE BY WITNESS TREES.
 CONTINUED NORTH VARIATION 6-30
 5068.14 STONE AT SW COR SEC 31 TOWN 2 R 11
 PG 209 EAST ON NORTH LINE SEC 6 VARIATION 5-52
 5283.96 SET STONE FOR CORNER OF 5 & 6 BY STUMP OF WITNESS TREE.
 PLYMOUTH CORNER IS 30.36' WEST
 BACK
 2641.98 SET 1/4 STONE 13.2' W(?) OF PLYMOUTH CORNER. NOV 4TH 1871
 1937 SUNNY VOL 3 PG 357 FOUND 6X5 LIMESTONE 10" LOW. IT IS NOT IN BLACK
 TOP ROAD. SET NO PIPE ON TOP OF STONE. SHOWS A TIE SHEET.
 1957 BATTERMAN JR. VOL 3 PG 522 SHOWS TIE SHEET AND CORNER AT CENTER OF
 ROAD. ALSO SHOWS A DISTANCE OF 2645.46' FEET TO THE N 1/4 COR SEC 6
 NEWARK TWP. STATES NOTHING ABOUT MON.
 1963 BATTERMAN VOL 4 PG 164 SHOWS TIES. FD CUT STONE @ COR.
 1987 BARNES A-25 FOUND REFERENCE PIPES AS SHOWN. DUG 2' WIDE TRENCH 24"
 DEEP 70.1' FROM REFERENCE PIPE. SOUTH & NORTH END OF TRENCH IS 21.6'
 AND 16.4' FROM REROD ON NORTH SIDE OF ROAD. FOUND NOTHING.
 1993 BARNES A-1(1) FOUND LIMESTONE 2.3' DEEP & REFERENCED SAME. CALLS
 FOR 5323.52 TO NW COR SEC 1 AVON TWP, 2406.19 TO E 1/4 COR SEC 1 AVON
 TWP, & AN ANGLE OF 90-28-31 @ THE NE COR SEC 1 FROM THE EAST LINE
 ALONG THE NORTH LINE OF SEC 1 AVON TWP.

FD 1/2" PIN, PK TRAVERSE STATION, & REFERENCE TIES

C) Was the corner restored through acceptance of (1) an obliterated evidence location, or, (2) a found perpetuated location?

ACCEPTED FOUND PERPETUATED LOCATION.

D) Describe any material discrepancy between the location of the corner as restored or reestablished and the location of that corner as previously restored or reestablished by distance and direction. Show the discrepancy on the plan view drawing under (a), above. Show the distances between the corner as previously restored or reestablished and (1) the corner as restored or reestablished, and (2) to at least 4 of the witness monuments shown on the drawing in (a), above.

(E) Was the corner reestablished through lost corner proportionate methods? If so, show the method, including the directions and distances to other public land survey corners used as evidence or used for proportioning the corner location.

I, Donald Barnes, hereby certify that the corner location as identified by the corner code index was determined by me under my direction and control and that this U.S. Public Land Survey Monument Record is correct and complete to the best of my knowledge and belief.

seal


SHEET 2 OF 3

emboss

CORNER CODE **A-1(2)**

Donald Barnes
 Jan 4 2001

A-E 7.08 REQUIREMENT

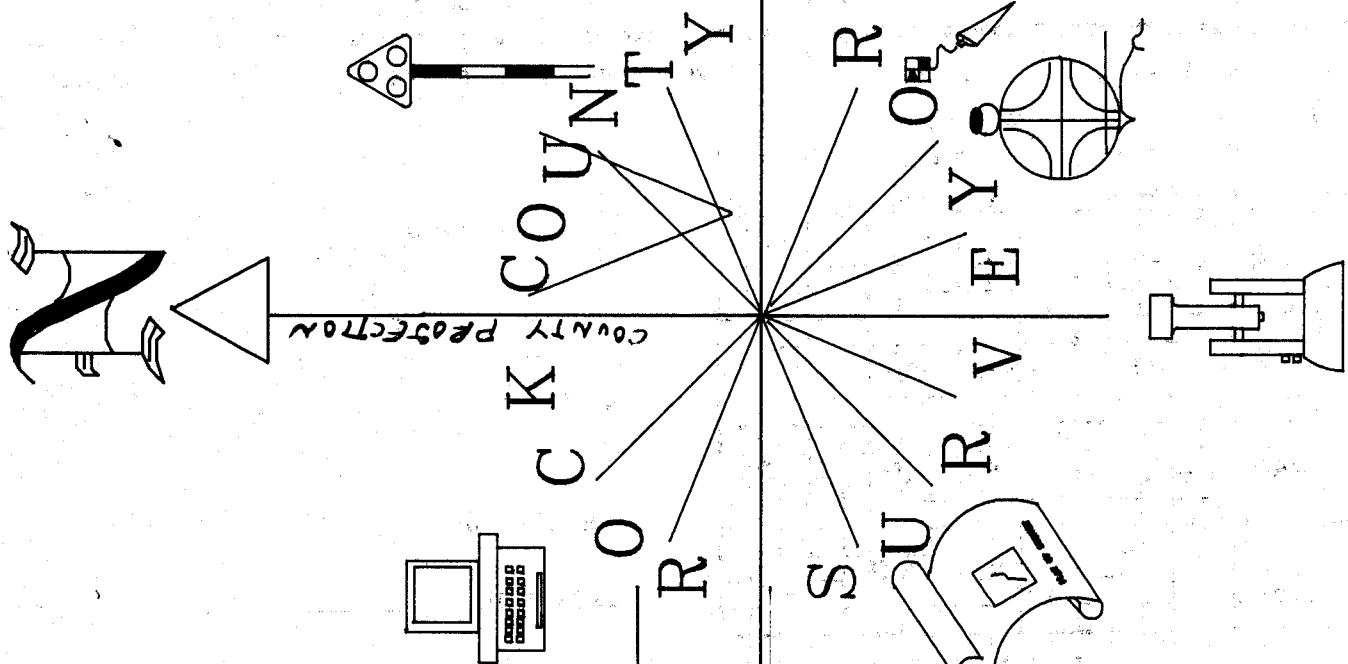

PLYMOUTH TWP

NEWARK TWP

NW COR
SEC 6
NEWARK TWP
T1N R11E

OBSERVATION SHEET #501
FB#2 PG 60 SPRING VALLEY TWP
FB#2 PG 10&11 NEWARK TWP
OLD TIES VOL 4 PG 165

FD REROD
REC N4-43-47E
REC 20.37
REC N3-57-37E
20.37
8'

FD 1/2" PIN
CUT LIMESTONE 2.3' DEEP

FD 1 1/2" PIPE
IN WOODS

REC N28-06-13E 70.91
REC N22-19-22W 70.91
REC N20-20-02W 88.84
REC N21-06-31W 88.84

REC S58-17-08E 70.14'
REC S57-30-58E 69.36

FD PK
N61-16-52W
20.13

REC N58-08-13E 17.84
REC N58-08-13E 17.84
REC N58-08-13E 17.84

FOSSUM RD

REC N18-31-39E 64.93E
REC N18-18-29E 64.93E
REC N18-31-39E 64.93E

FD REROD

SPRING VALLEY TWP

AVON TWP

NORTH TOWN RD

FD BENT PIPE

Donald Barnes

EMBOSSSED
SEAL

Jan 4
2001

A-1(?)