

# U. S. PUBLIC LAND SURVEY MONUMENT RECORD


For Public Land Survey Corners in the  
T. 3 N., R. 11 E.

## CORNER CODE INDEX

	1	2	3	4	5	6	7	8	9	10	11	12	13	14	15	16	17	18	19	20	21	22	23	24	25
A																									
B																									
C	6																								
D		5																							
E			4																						
F				3																					
G					2																				
H																									
I																									
J	7																								
K		8																							
L			9																						
M				10																					
N					11																				
O						12																			
P							13																		
Q								14																	
R									15																
S										16															
T											17														
U												18													
V													19												
W														20											
X															21										
Y																22									
Z																	23								
																		24							
																			25						
																				26					
																					27				
																						28			
																							29		
																								30	
																									31
																									32
																									33
																									34
																									35
																									36

PLACE MONUMENT SYMBOL (◆) AT PROPER LOCATION ON ABOVE INDEX

### EXAMPLE

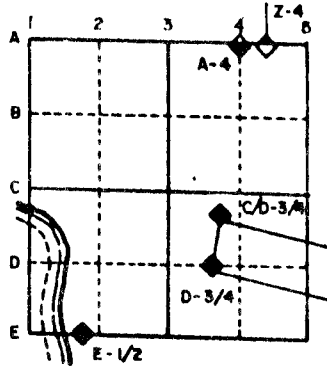

CENTER TWP  
ROCK COUNTY WI

IF AVAILABLE  
STATE PLANE COORDINATES

North (Y) \_\_\_\_\_ Eleve. (Z) \_\_\_\_\_  
 East (X) \_\_\_\_\_ Zone \_\_\_\_\_  
 Hor. Datum \_\_\_\_\_ Vert. Datum \_\_\_\_\_

(a.)

◆ CORNER MONUMENT

○ WITNESS MONUMENT

BEARINGS ARE BASED ON:

FIELD BOOK \_\_\_\_\_ PAGE # \_\_\_\_\_

MICROFILMED

SHOW A PLAN VIEW DRAWING DEPICTING THE CORNER MONUMENT AND SURROUNDING PHYSICAL FEATURES, INCLUDING THE EXCAVATION AREA AND DEPTH. THE CORNER MONUMENT SHALL HAVE THE FOLLOWING CHARACTERISTICS: 1) HAVE AT LEAST TWO PREDETERMINED BREAK-OFF POINTS. 2) IF BROKEN, LEAVE A PERMANENTLY MAGNETIZED REMNANT AT THE ORIGINAL POINT. 3) MUST BE EXTENDABLE. 4) THE CAP IS INSCRIBED: ROCK COUNTY SURVEY MONUMENT - PENALTY FOR DISTURBING MARKER. 5) OR AN EXISTING CUT LIMESTONE. AN IRON PIPE 1 1/2" x 4'0" (MINIMUM) MAY BE USED IN AREAS WHERE GROUND WATER IS WITHIN ONE FOOT OF THE SURFACE. IF THE CORNER IS OCCUPIED BY AN IMPROVEMENT (MANHOLE, BURIED CABLE, ETC.) ANY DURABLE, DISTINCT MONUMENT MAY BE USED. CORNERS SHALL BE REFERENCED WITH AT LEAST 4 DURABLE WITNESS MONUMENTS. WITNESS MONUMENTS SHALL BE MADE OF CONCRETE, NATURAL STONE, IRON OR OTHER EQUALLY DURABLE MATERIAL, EXCEPT WOOD. DESCRIBE THE CORNER AND THE WITNESS MONUMENTS.

CORNER CODE:

Z 13(1)

(B) Describe any record evidence, monument evidence, occupational evidence, testimonial evidence or any other material evidence you considered, and whether the monument was found or placed.

1866 LOCKE REMONUMENTATION. INTERSECTED NORTH BOUNDARY 11.88' EAST OF CORNER. CORNERS FOR TOWN 2 AND 3 BOTH LOST. SET CORNER FOR TOWN 3 MIDWAY AND ON A RIGHT LINE BETWEEN THE 1/4 CORNERS 1/2 MILE EAST AND WEST, AND SET THE CORNER FOR TOWN 2 2.64' EAST OF CORNER FOR TOWN 3. CORNER IN CENTER OF HIGHWAY. PLACED CUT LIMESTONE.

1934 SUNNY VOL 3 PG 236 SHOWS CORNER IS 40 LINKS WEST OF THE NE CORNER OF SECTION 4. STATES NOTHING ELSE ABOUT THE CORNER.

1988 BARNES Z-13 DUG 4'X10' HOLE AND FOUND NOTHING. SUBSOIL INDICATES AREA WAS CUT. LARGE BANK CUT ON NORTH SIDE AND POSSIBLY SMALL CUT ON SOUTH SIDE. PLACED CORNER ON LINE WITH THE NE CORNER OF SECTION 3 PLYMOUTH AND NORTH QUARTER CORNER OF SECTION 4 PLYMOUTH AT RECORD DISTANCE.

FOUND DOT DISK.

C) Was the corner restored through acceptance of (1) an obliterated evidence location, or, (2) a found perpetuated location?

DID NOT ACCEPT DOT DISK. ACCEPTED LOCATION AS DETERMINED BY RECORD TIE DISTANCES.

D) Describe any material discrepancy between the location of the corner as restored or reestablished and the location of that corner as previously restored or reestablished by distance and direction. Show the discrepancy on the plan view drawing under (a), above. Show the distances between the corner as previously restored or reestablished and (1) the corner as restored or reestablished, and (2) to at least 4 of the witness monuments shown on the drawing in (a), above.

THE DISK IS .08' SOUTH AND 0.02' WEST OF THE CORRECT LOCATION

(E) Was the corner reestablished through lost corner proportionate methods? If so, show the method, including the directions and distances to other public land survey corners used as evidence or used for proportioning the corner location.

I, Donald Barnes, hereby certify that the corner points as identified by the corner code index were, in a field survey on, November 9, 1992, established, re-established, monumented, re-monumented, recovered or restored as expressed below and in conformance with the regulations and rules as required in the current manual of survey instructions of the United States Department of Interior, Bureau of Land Management.

COUNTY SURVEYOR FILING DATA

Date of computer entry \_\_\_\_\_

Date microfilmed \_\_\_\_\_

Number of included sheets \_\_\_\_\_  
CORNER CODE

AFFIX YOUR LAND SURVEYOR SEAL

Z 13 (1)

Donald Barnes  
11/30/92

N89°55'05"E 104.96'  
REC S89°55'05"W 104.96'

N2°04'14"E 149.62'  
REC S2°04'14"W 149.62'

S38°35'53"E 109.68' DISK  
S38°33'26"E 109.67'  
N26°28'39"W 94.16' REC  
N26°26'36"W 94.22' DISK

DISK N36°41'58"E 105.40  
REC N36°43'05"E 105.33'  
S23°04'23"W 93.38' REC  
N23°02'37"E 93.32' DISK

STH

11

SE COR  
SEC 33  
DOT 299+44

REC 26.42'  
N86°47'19"W  
REC 26.40'

NE COR  
SEC 4  
DOT 299+71  
FD DISK

DISK N36°00'41"E 80.56'  
REC N35°59'33"E 80.63'  
REC S49°09'40"E 97.50  
N49°10'13"E 97.58' DISK

REC N36°45'22"W 96.48'  
DISK N36°47'43"W 96.43'  
DISK S22°22'07.1"E 82.05'  
REC S22°22'07.1"E 82.05'  
REC S22°22'07.1"E 82.05'

REC N1°51'22"E 161.81'  
S1°51'22"W 161.81'

REC S83°27'21"E 105.81'  
N83°27'21"W 105.81'

DOT DISK IN CONCRETE

213(1)

