


PUBLIC LAND SURVEY MONUMENT RECORD

For Public Land Survey Corners in the

T. 1 N., R. 13 E.

CORNER CODE INDEX

	1	2	3	4	5	6	7	8	9	10	11	12	13	14	15	16	17	18	19	20	21	22	23	24	25
A																									
B																									
C																									
D																									
E																									
F																									
G																									
H																									
I																									
J																									
K																									
L																									
M																									
N																									
O																									
P																									
Q																									
R																									
S																									
T																									
U																									
V																									
W																									
X																									
Y																									

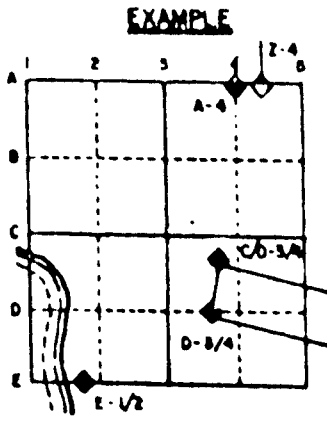

TURTLE TWP
ROCK COUNTY WI

IF AVAILABLE
STATE PLANE COORDINATES

North (Y) 203,628.33 Elev. (Z) _____
East (X) 501,446.81 Zone _____
Hor. Datum _____ Vert. Datum _____

PLACE MONUMENT SYMBOL (●) AT PROPER LOCATION ON ABOVE INDEX

ROSS MICHAELS 203,628.48
501,446.90

◆ CORNER MONUMENT

○ WITNESS MONUMENT

FD TIES IN X5

BEARINGS ARE BASED ON:

SHEET ___ OF ___

X5(1)

CORNER CODE:

(B) Describe any record evidence, monument evidence, occupational evidence, testimonial evidence or any other material evidence you considered, and whether the monument was found or placed.

1836 LYONS SET QUARTER SECTION POST & MADE MOUND OF EARTH & SOD
1874 RUGER FOUND OLD STAKE & DROVE NEW STAKE. IN PLACE OF OLD ONE.
SUBDIVIDED SEC 31.

1979 BARNES VOL 6 PG 14 DUG & FOUND NOTHING. SET ALUM. MON. ON LINE
WITH SW & NW CORNERS OF SEC 32 AT SINGLE PROPORTIONATE. 1' SOUTH
OF E/W FENCE & 3' WEST OF N/S FENCE.

1993 MICHAELS X-5 FOUND ALUM. MON & REFERENCED SAME.

FOUND ALUM MON & MICHAELS' TIES.

C) Was the corner restored through acceptance of (1) an obliterated evidence location, or, (2) a found perpetuated location?
ACCEPTED FOUND PERPETUATED LOCATION.

D) Describe any material discrepancy between the location of the corner as restored or reestablished and the location of that corner as previously restored or reestablished by distance and direction. Show the discrepancy on the plan view drawing under (a), above. Show the distances between the corner as previously restored or reestablished and (1) the corner as restored or reestablished, and (2) to at least 4 of the witness monuments shown on the drawing in (a), above.

(E) Was the corner reestablished through lost corner proportionate methods? If so, show the method, including the directions and distances to other public land survey corners used as evidence or used for proportioning the corner location.

NO

I, Donald Barnes, hereby certify that the corner points as identified by the corner code index were, in a field survey on, 1994, established, re-established, monumented, re-monumented, recovered or restored as expressed below and in conformance with the regulations and rules as required in the current manual of survey instructions of the United States Department of Interior, Bureau of Land Management.

seal
Donald Barnes
7/12/95

EMBOSS LAND SURVEYOR SEAL

COUNTY SURVEYOR FILING DATA

Date of computer entry _____

Date microfilmed _____

Number of included sheets _____
CORNER CODE _____

A-E 7.08 REQUIREMENT

X5(1)