
$\mathbf{U.S.}$

SURVEY UBLIC MONUMENT RECORD

For Public Land Survey Corners in the T. 11. R. 13 E

CORNER CODE INDEX

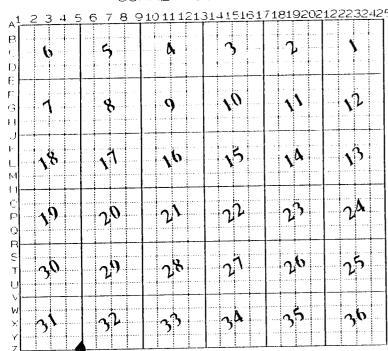

TUFTLE ROCK COUNTY WI

IF AVAILABLE ROCK COUNTY COORDINATES PERFERRED

Morth 200, 974, 76 Elev.

East 501,487,17

Hor. Datum <u>COUNT</u>Y Vert. Datum ____

GPS (X) ____

TRAVERSE (X)

BASED ON THE FOLLOWING CONTROL:

PLACE MONUMENT SYMBOL

AT PROPER LOCATION ON ABOVE INCEX

OCORNER MONUMENT

O WITHESS MONUMENT

(a)

BEARINGS ATH BASHO ON:

Fd ALUM MON

Fd TIES IN 25

FLAINING & ZONING COMMITTEE ADOPTED THE ABOVE FORM ON 12/2/1982 WE ADMINISTRATIVE CODE A=E 7.08 PEODIFFFEUR

SHEET ____OF __

- Describe any record evidence, monument evidence, occupational evidence, testimonial evidence or any other material evidence you considered, and whether the monument was found or placed.
- 1832 LYONS ORIGINAL FIELD NOTES. SET POST AND RAISED A SQUARE MOUND OF EARTH FOR CORNER TO SECTIONS 31 & 32.
- 1838 SPALDING FIELD NOTES PG 390 & 391. ILL TWP. INTERSECTED BASE LINE OF NORTH WEST TERRITORY & NORTH BOUNDARY OF ILL. 2056.6 WEST OF COR TO SEC 31 & 32 T1N R13E OF THE 4TH PM AT SAID INTERSECTION SET A POST & STONE 14" LONG 8" WIDE & 6" THICK FOR CORNER TO SEC 3 & 4 T46N R2E OF 3RD PM.
- 1975 RICHARDSON CSM VOL 5 PG 57. CALLS FOR A PIPE AT THE CORNER.
 1979 BARNES VOL 6 PG 14 FOUND 1 1/2" PIPE. REPLACED WITH ALUMINUM MONUMENT. CALLS FOR 2653.72 TO THE W 1/4 CORNER OF SECTION 32.
- 1982 LEE MAP # 5002 CALLS FOR AN ALUMINUM MONUMENT.
- 1987 LEE CSM VOL 13 VOL 102 SYMBOL SHOWS A PIPE. CALLS FOR 5307.44 TO THE NW CORNER OF SECTION 32.
- 1988 LEE CSM VOL 13 PG 268 SYMBOL CALLS FOR A FOUND ALUMINUM MONUMENT.
- 1989 LEE MAP#12167 STATES NOTHING ABOUT THE MONUMENT.
- 1991 BATTERMAN & CO. VOL 6 PG 14 FOUND ALUMINUM MONUMENT 662.06 WEST OF THE N 1/4 CORNER OF SECTION 3.

FOUND ALUMINUM MONUMENT.

Was the corner restored through acceptance of (1) an obliterated evidence location, or, (2) a found perpetuated location?

ACCEPTED FOUND PERPETUATED LOCATION.

- Describe any material discrepancy between the location of the corner as restored or reestablished and the location of that corner as previously restored or reestablished by distance and direction. Show the discrepancy on the plan view drawing under (a), above. Show the distances between the corner as previously restored or reestablished and (1) the corner as restored or reestablished, and (2) to at least 4 of the witness monuments shown on the drawing in (a), above.
- (E) Was the corner reestablished through lost corner proportionate methods? If so, show the method, including the directions and distances to other public land survey corners used as evidence or used for proportioning the corner location.

I, Donald Barnes, hereby certify that the corner points as identified by the corner code index were, in a field survey on, FeB 19 , 1992 established, re-established, monumented, re-monumented, recovered or restored as expressed below and in conformance with the regulations and rules as required in the current manual of survey instructions of the United States Department of Interior, Bureau of Land Management.

	COUNTY SURVEYOR FILING DATA
seal	Date of computer entry
	Date microfilmed
	Number of included sheets

AFFIX YOUR LAND SURVEYOR SEAL

Donald Barres 7/12/95

25(1)