
## U.S.

## SURWE TUBLIC MONUMENT RECORD

For Public Land Survey Corners in the T. \_N., R. 13\_E

CORNER CODE INDEX

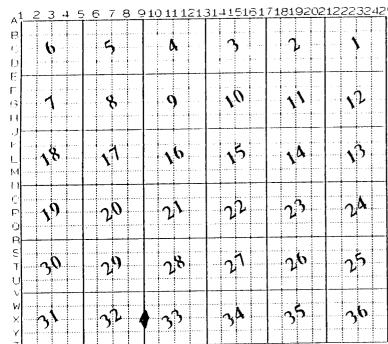

TURTLE ROCK COUNTY WI

1F AVAILABLE ROCK COUNTY COORDINATES PERFERRED

North 203, 564, 33 Elev.

East 506756.00

Hor. Datum COUNTY Vert. Datum \_\_\_\_\_

TRAVERSE (X) X

BASED ON THE FOLLOWING CONTROL:

ROSS MICHARLS 203,564,44 506,755.93 CONVERTED HIS NAD 83 COORDINATES

PLACE MONUMENT SYMBOL & LOCATION ON ABOVE INDEX AT PROPER

CORNER MONUMENT

O WITHESS MONUMENT

(a)

BEABINGS ATE BASED ON:

Fd TIES IN X9

FIELD BOOK

PAGE #

SHOW A PLAN VIEW DRAWLING DEPICTING THE CORNER MONDERN ALD SUPROLUDING PHYSICAL FEATURES, INCLUDING THE EXCAVATION AREA AND DEPTH. THE CORNER MONDERN SHALL HAVE THE FOLLOWING CHARACHERISTICS: 11 HAVE A LEAST TWO PREDETERMINED BREAK-OFF POINTS. 2) IF BROKER LEAVE A PERMINENTLY MAGNETIZED REMAINT AT THE ORIGINAL POINT.

3) HUST DE EXTENDABLE. 4) THE CAP IS INSCRIBED TROK COUNTY SURVEY MONDERN - PENALTY FOR DISTURBING MARKER? 5) OR AN EXISTING OUT LINESTONE. AN I ROLD PLY 1.72'X

4) DISTURBING MARKER? 5) OR AN EXISTING COUNTY SURVEY MONDERN - PENALTY FOR DISTURBING MARKER? 5) OR AN EXISTING OUT LINESTONE. AND TROK ESTICA AND DEPTH AS DECEMBED BY AN INFROVENENT MARKER CHOICE AND DRABLE, DISTINCT MONDERN MARKER SHALL BE REFERRIZED WITH AN LEAST 4 DURBAGE. BY THESS MONDREINS SHALL BE MADE OF CONCRETE, HAIRTAL STONE, BROKE COUNTY BY AND THE CORNER FOR CONCRETE, HAIRTAL STONE, BROKE COUNTY BY AND THE CORNER MADE OF CONCRETE, HAIRTAL STONE, BROKE COUNTY BY AND THE CORNER MADE OF CONCRETE, HAIRTAL STONE, BROKE COUNTY BY AND THE CORNER MADE OF CONCRETE, HAIRTAL STONE, BROKE COUNTY BY AND THE CORNER MADE OF CONCRETE, HAIRTAL STONE, BROKE COUNTY BY AND THE CORNER MADE OF CONCRETE, HAIRTAL STONE, BROKE COUNTY BY AND THE CORNER MADE OF CONCRETE.

FLAFFIERD & ZONIERD CONMITTEE ADOPTED THE ABOVE FORM ON 12/2/1982 WI ADMINISTRATIVE CODE A-E 7.08 REQUIREMENT

SHEET \_\_\_\_OF \_\_\_\_

TU616 W 1/4 33

- (B) Describe any record evidence, monument evidence, occupational evidence, testimonial evidence or any other material evidence you
- considered, and whether the monument was found or placed.

  1973 SHIMEALL MAP #5008 FOUND AXLE. ANGLE 88-30 AT SE FROM S 1/4 TO E
  1/4 CORNERS OF SECTION 32. 2636.5( MAYBE 2656.5) TO SE CORNER OF
  SECTION 32. 1577.9 (MAY BE 1597.9) SOUTHERLY TO PIPE IN CENTER OF PAVEMENT. 1330.0 FROM SE TO S 1/16TH CORNER OF SE 1/4 OF SECTION
- 1979 BARNES VOL 6 PG 14 FOUND AXLE. 1979 BARNES VOL 6 PG 14 FOUND AXLE. DROVE DEEP & SET ALUM. MON. 1980 THOM MAP #50111 2655.92 TO SW CORNER SECTION 33. ANGLE 91-(?91-44-59) AT SW COR FROM W 1/4 TO S 1/4 CORNER OF SECTION 33, ANGLE 88-15-48 (?88-15-48) FROM E 1/4 TO SW CORNER OF SECTION 33. 1597.26 SOUTHERLY TO PIPE IN CENTER OF PAVEMENT. FOUND SHIMEALL'S PIPE TO THE EAST (REC 813.53). STATES PIPE IS NO-01-08W 2.17 OF THE SECTION LINE WHICH IS A BEARING OF S88-16-01E. CALLS FOR
- 5306.2 (?5306.07) TO THE E 1/4 CORNER TO SECTION 33.

  1987 LEE CSM VOL 13 PG 102 DOES NOT USE CORNER INSTEAD USES THE SW
  CORNER TO DEFINE THE WEST LINE OF SECTION 32. CALLS FOR 5307. (TWP PROJ 5321.29) FROM THE NW TO SW CORNERS OF SECTION 33. CALLS FOR 5307.44 2647.14 TO CENTER OF SECTION 32. ANGLE 91-13-47 AT NE COR FROM SE TO N 1/4 COR SECTION 32 & ANGLE 91-13-36 AT CENTER FROM N 1/4 TO W
- 1991 KREBS MAP #11598 CALLS FOR ANGLE 91-44-46 (?91-45-38) AT SW FROM WEST LINE SW 1/4 SEC 33 TO S 1/4 CORNER & ANGLE 88-24-12 AT SE COR FROM SOUTH LINE SE 1/4 SEC 32 TO E 1/4 CORNER OF SECTION 32. 1058.64 (REC 1058.6, 1058.66) FROM SW 33 TO PIPE IN ROAD, 1330.00 (REC 1330.00) FROM SE 32 TO S 1/16TH OF SE 1/4 SECTION 32, 1994.31 TO CLOSING CORNER WEST OF SE CORNER OF SECTION 32, AND 2642.87 FROM SW TO S 1/4 CORNER OF SECTION 33.
- 1993 MICHAELS X-009 FOUND ALUMINUM MONUMENT & ESTABLISHED TIES. CALLED FOR NAD83(91) COORDINATES OF 185,027.10;2,245,455.53 WHICH WERE BASED ON DOT GPS. I CONVERTED TO THE FOLLOWING: LAT 42-30-10.69206 LONG 88-58-22.82776 LOCAL: 203,564.44'; 506,755.93'

FOUND POLY MON & MICHAEL'S REFERENCE TIES.

C) Was the corner restored through acceptance of (1) an obliterated evidence location, or, (2) a found perpetuated location? ACCEPTED FOUND PERPETUATED LOCATION.

I, Donald Barnes, hereby certify that the corner points as identified by the corner code index were, in a field survey on, 1994, established, re-established, monumented, re-monumented, recovered or restored as expressed below and in conformance with the regulations and rules as required in the current manual of survey instructions of the United States Department of Interior, Bureau of Land Management.

seal	COUNTY SURVEYOR FILING DATA
	Date of computer entry
	Date microfilmed
	Number of included sheets CORNER CODE

Donal Baines 7/14/95