

# PUBLIC LAND SURVEY MONUMENT RECORD

For Public Land Survey Corners in the


T. 1 N., R. 13 E.

## CORNER CODE INDEX

	1	2	3	4	5	6	7	8	9	10	11	12	13	14	15	16	17	18	19	20	21	22	23	24	25
A																									
B																									
C	8																								
D																									
E																									
F																									
G																									
H																									
I																									
J																									
K																									
L																									
M																									
N																									
O																									
P																									
Q																									
R																									
S																									
T																									
U																									
V																									
W																									
X																									
Y																									
Z																									

PLACE MONUMENT SYMBOL (◆) AT PROPER LOCATION ON ABOVE INDEX

### EXAMPLE

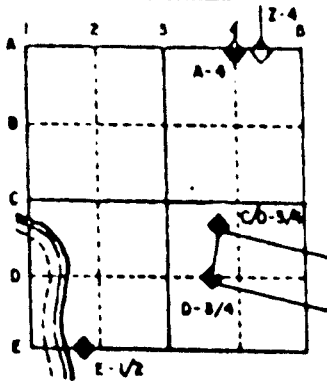

TURTLE TWP  
ROCK COUNTY WI

IF AVAILABLE  
STATE PLANE COORDINATES

North (Y) 230,134,78 Elev. (Z) \_\_\_\_\_  
 East (X) 506,760,74 Zone \_\_\_\_\_  
 Hor. Datum COUNTY Vert. Datum \_\_\_\_\_

◆ CORNER MONUMENT

○ WITNESS MONUMENT

BEARINGS ARE BASED ON:

(B) Describe any record evidence, monument evidence, occupational evidence, testimonial evidence or any other material evidence you considered, and whether the monument was found or placed.

- 1836 LYONS SET QUARTER SECTION POST & MADE MOUND OF EARTH & SOD. CALLS FOR 2640 TO SE CORNER & 2904 TO NE CORNERS OF SEC 5.
- 1853 McVEAN VOL 1 PG 19 STATES NOTHING ABOUT THE CORNER. SUBDIVIDED SECTION 5. CALLS FOR 5268.78 TO W 1/4 COR SEC 5 & 2636.70 TO SE CORNER OF SEC 5.
- 1956 SHIMEALL FIELD BOOK #9 PG 35 (IN HAROLD COMB'S OFFICE). FIELD NOTES SHOWS THAT HE PLACED A PIN BUT DOES NOT STATE WHAT HE FOUND NOR HOW HE DETERMINED THE LOCATION. HE MADE SEVERAL SURVEYS IN SECTION 4 & 5 USING THIS PIN.
- 1964 BATTERMAN VOL 4 PG 203 SET 1" PIPE IN LINE WITH CENTER & E 1/4 COR SEC 4 & ON LINE BETWEEN THE NW & SW CORNERS OF SECTION 4.
- 1987 BARNES C 9. LEUENBERGER STATED THAT HE DID NOT FIND ANY SURVEYS IN THE R.H. BATTERMAN OFFICE THAT USED BATTERMAN'S PIPE. ALSO THERE WERE NO SURVEYS IN THIS OFFICE THAT USED THE PIPE. SINCE I DID NOT ACCEPT THE SW CORNER OF SECTION 4 THAT BATTERMAN PLACED, THEN THE PIPE WOULD NOT BE ON LINE WITH THE NW CORNER OF SECTION 4 AS STATED IN VOL 4 PG 203. USING THE PIN AND THE EAST QUARTER CORNER OF SEC 4 WOULD PLACE THE CENTER OF SECTION OFF THE STRAIGHT LINE BY ABOUT 1.6' WHICH IS WITHIN THE LEGAL ALLOWABLE ERROR OF RUGER'S PERIOD. I REPLACED SHIMEALL'S PIN WITH A POLY MONUMENT AND DROVE THE PIPE ABOUT 1' DEEP. PLACED WHITE PLASTIC POST NEXT TO MONUMENT.

FOUND POLY MONUMENT & REFERENCE RERODS.

C) Was the corner restored through acceptance of (1) an obliterated evidence location, or, (2) a found perpetuated location?  
ACCEPTED FOUND PERPETUATED LOCATION.

D) Describe any material discrepancy between the location of the corner as restored or reestablished and the location of that corner as previously restored or reestablished by distance and direction. Show the discrepancy on the plan view drawing under (a), above. Show the distances between the corner as previously restored or reestablished and (1) the corner as restored or reestablished, and (2) to at least 4 of the witness monuments shown on the drawing in (a), above.

(E) Was the corner reestablished through lost corner proportionate methods? If so, show the method, including the directions and distances to other public land survey corners used as evidence or used for proportioning the corner location.

I, Donald Barnes, hereby certify that the corner points as identified by the corner code index were, in a field survey on, OCT 17, 1993, established, re-established, monumented, re-monumented, recovered or restored as expressed below and in conformance with the regulations and rules as required in the current manual of survey instructions of the United States Department of Interior, Bureau of Land Management.

seal 6/2/95

*Donald Barnes*

EMBOSS LAND SURVEYOR SEAL

COUNTY SURVEYOR FILING DATA

Date of computer entry \_\_\_\_\_

Date microfilmed \_\_\_\_\_

Number of included sheets \_\_\_\_\_  
CORNER CODE

