

Paper weight-110# (minimum)

Black nonfading ink required

# U.S. PUBLIC LAND SURVEY MONUMENT RECORD

For Public Land Survey Corners In:  
T. 2 N. R. 11 E. 4th P.M.

WI ADMINISTRATIVE CODE A-E 7.08 REQUIREMENT

REV 10/23/2004 USMONREC.DWG

CORNER CODE INDEX

1	2	3	4	5	6	7	8	9	10	11	12	13	14	15	16	17	18	19	20	21	22	23	24	25	
A																									A
B																									B
C	6																								C
D		5																							D
E			4																						E
F				3																					F
G					2																				G
H						1																			H
I																									I
J																									J
K																									K
L																									L
M																									M
N																									N
O																									O
P																									P
Q																									Q
R																									R
S																									S
T																									T
U																									U
V																									V
W																									W
X																									X
Y																									Y
Z																									Z

PLYMOUTH TWP  
ROCK COUNTY WI

IF AVAILABLE  
ROCK COUNTY COORDINATES PREFERRED

North \_\_\_\_\_ Elev. \_\_\_\_\_

East \_\_\_\_\_

Hor. Datum \_\_\_\_\_ Vert. Datum \_\_\_\_\_

LATITUDE \_\_\_\_\_ ELLIPS. HT. \_\_\_\_\_

LONGITUDE \_\_\_\_\_

NAD83(91) \_\_\_\_\_ NETWORK ADJ. YR \_\_\_\_\_

GPS (X) \_\_\_\_\_ TRAVERSE (X) \_\_\_\_\_

BASED ON THE FOLLOWING CONTROL:

PLACE MONUMENT SYMBOL  AT PROPER LOCATION ON ABOVE INDEX

CORNER MONUMENT

WITNESS MONUMENT

BEARINGS ARE BASED ON: \_\_\_\_\_

FIELD BOOK \_\_\_\_\_ PAGE # \_\_\_\_\_

SHEET 1 OF 4

SHOW A PLAN VIEW DRAWING DEPICTING THE CORNER MONUMENT AND SURROUNDING PHYSICAL FEATURES, INCLUDING THE EXCAVATION AREA AND DEPTH.

PLANNING & ZONING COMMITTEE ADOPTED THIS FORM ON 12/2/1982

CORNER CODE A-15(A)

**PL508 N1/4CORSEC3**

*(B) Describe any record evidence, monument evidence, occupational evidence, testimonial evidence or any other material evidence you considered, and whether the monument was found or placed.*

- 1833 MULLET WEST ON SOUTH SIDE SECTION 34  
26408ET QUARTER SECTION POST IN PRAIRIE AND  
MADE MOUND  
5280 SET POST CORNER SECTIONS 33 & 34 IN PRAIRIE  
AND MADE MOUND LAND ROLLING PRAIRIE  
SECOND RATE.**
- 1855 CHURCH VOL 1 PG 39 USED N 1/4 CORNER TO SUBDIVIDE  
SECTION 3. SHOWS A DISTANCE OF 2638.35 FROM CENTER  
OF SECTION 3 TO E & W 1/4 CORNERS.**
- 1868 LOCKE PLYMOUTH TWP REMONUMENTATION FIELD NOTES.  
PLACED CUT LIMESTONE.  
PG 48 WEST ON NORTH LINE SEC 3 VAR 7  
2668.05 INTERSECTED 1/4 LINE FOR SEC 34 TOWN 3 N AT  
COR. FOUND OLD STAKE IN CENTER OF HIGHWAY  
AND IN LINE OF FENCES RUNNING NORTH AND  
SOUTH.  
2654.85 SET 1/4 COR 13.2' EAST OF 1/4 COR. FOR TOWN 3  
THE SEC. CORRS WEST BEING LOST.  
2979.9 CENTER SLUICE BRIDGE 5.28' WIDE  
4068.9 CENTER SLUICE BRIDGE 5.28' WIDE  
5300.13 INTERSECTED WEST BOUNDARY 12.62' SOUTH OF  
COR. SET AS PREVIOUSLY STATED (PAGE 47) VAR  
CORRECTED 6-44 MARKED 1/4 MONUMENT WITH  
FIGURE 3 ON SOUTH FACE. SEPT 3 1868**
- 1886 RUGER VOL 2 PG 272 USED TO SUBDIVIDE SECTION 3 BUT  
STATES NOTHING ABOUT THE N 1/4 CORNER SEC 3. SHOWS  
A DISTANCE OF 2648.42 & VAR 4-35 FROM E 1/4 COR SEC 3  
TO THE CENTER OF SECTION 3.**
- 1933 SUNNY VOL 3 PG 235 SET 1X36" PIPE IN CONC. PVMT. 0.4' N  
OF CENTER OF SAME. CALLS FOR S 1/4 COR SEC 34 AS 13.2'  
TO THE WEST. 2645.4 FROM N 1/4 COR SEC 3 TO NW COR  
SEC 3 & 2653.6 FROM N 1/4 COR SEC 3 TO NE COR SEC 3.**
- 1970 BATTERMAN VOL 4 PG 484 SHOWS N 1/4 CORNER SEC 3  
REFERENCED. STATES NOTHING ABOUT MON. 32.01 FROM  
COR TO NW REFERENCE PIPE WITH NOTE 34.01 BY C.S.**
- 1972 SHIMEALL VOL 3 PG 235 NOTE STATES THAT HE PLACED A  
1" PIPE @ N 1/4 COR SEC 3.**
- 1982 LEE CBM11-131 FD PK @ N 1/4 COR SEC 3**
- 1988 BARNES A-15 & Z-15 @ N 1/4 COR SEC 3 FD REROD AT ROAD  
SURFACE. 6" DEEP FOUND PIPE IN CONCRETE PAVEMENT.  
34" DEEP FOUND CUT LIMESTONE. PLACED MAGNET ON TOP  
OF STONE. ACCEPTED FOUND CUT LIMESTONE. PIPE IS N50-  
40-29E 0.10' & THE REROD IS N86-20-24E 0.17'  
REFERENCED SAME. EXCAVATION FOR S 1/4 COR SEC 34  
CENTER TWP IS SHOWN WEST OF LIMESTONE. S 1/4 COR SEC  
34 CENTER TWP PLACED ON LINE WITH N 1/4 COR SEC 3 AND  
NW COR SEC 3 AT RECORD DISTANCE WHICH IS 888-56-44W  
13.20' OF THE CUT L.S. @ N 1/4 COR SEC 3 PLYMOUTH TWP.**
- 1988 BARNES VOL 6 PG 388 BEARINGS & DISTANCES ARE BASED  
WIDOT CONTROL. S 1/4 COR SEC 34 TO SE COR SEC 34 IS  
N88-43-23E 2667.91, S 1/4 COR SEC 34 TO SW COR SEC 34  
IS 888-56-48W 2658.48, N 1/4 COR SEC 3 TO NE COR SEC 3  
IS N88-43-19E 2654.71, N 1/4 COR SEC 3 TO NW COR SEC 3  
IS 888-56-44W 2645.99, NW COR SEC 3 TO W 1/4 COR SEC 3  
IS 81-27-22E 2587.08, NE COR SEC 3 TO E 1/4 COR SEC 3 IS  
801-04-00E 2701.33, SW COR SEC 34 TO W 1/4 COR SEC 34  
IS N1-57-37W 2662.16, SW COR SEC 34 TO NW COR SEC 3 IS  
26.40, & NW COR SEC 3 IS EAST OF SW COR SEC 34.**

*David Barnes*

*10/13/2009*

**PL508 N1/4CORSEC3**

**SHEET 1 OF 4  
CORNER CODE A-15(4)**

PL508 N1/4CORSEC3

- 1989 WIDOT STH 11 MAP #16698 PROJECT 1704-03-22 @ N 1/4 COR SEC 3 FD CUT LIMESTONE 246,064.92; 2,220,619.41 888-56-43W 13.20 TO S 1/4 COR SEC 34 MON TO BE SET 246,064.68; 2,220,606.21 1992 BARNES A-15(1) & Z-15(1) MONUMENT WILL BE DESTROYED BY CONSTRUCTION. REFERENCED SAME. S 1/4 COR 34 CENTER TWP IS 889-00-06W 13.20' (REC 13.20). @ S 1/4 COR SEC 34 CENTER TWP DOT DID NOT INSTALL A MON. ACCEPTED LOCATION AS PERPETUATED BY RECORD TIE DISTANCES.
- 1992 BARNES A-15(2) & Z-15(1) FOUND DOT DISK @ N 1/4 COR SEC 3. ACCEPTED FOUND CUT LIMESTONE. DID NOT ACCEPT DOT DISK. DISK IS 0.06' NORTH AND 0.04' EAST OF THE CORRECT POSITION. FOUND PREVIOUS REFERENCE MONUMENTS.
- 1993 COMBS GSM VOL 17 PG 75 DOT MON. @ N1/4 COR SEC 3, NW COR SEC 3, & SW SEC 34. FD PIPE @ S 1/4 COR SEC 33. 2658.31 FROM S 1/4 TO SW CORNERS OF SEC 34.
- 2003 BARNES A-15(3) USED MY OLD OBSERVATIONS. ACCEPTED FOUND CUT LIMESTONE
- 2004 BARNES PLYMOUTH TWP. REMONUMENTATION

PRIOR TO RESURFACING SEARCHED & DID NOT FD WIDOT DISKS @ SURFACE. FD 4 RECORD REFERENCE WIDOT MONUMENTS. AFTER RESURFACING, I FOUND PK/FLASHER. FLASHER STAMPED "WIDOT SURVEY" & IS JUST BELOW PVMT SURFACE.

*C) Was the corner restored through acceptance of (1) an obliterated evidence location, or, (2) a found perpetuated location?*

ACCEPTED CUT LIMESTONE. THE FD PK/FLASHER MONUMENT THE LIMESTONE LOCATION. IT APPEARS BY COMPARING LOCKE'S JOBS @ THE N 1/4 COR SEC 3 & SEC 4 WITH THE ORIGINAL JOBS @ THE ADJACENT CLOSING CORNERS, HE PLACED THE N 1/4 CORNERS NOT AT A MIDPOINT BETWEEN THE SEC CORNERS BUT RATHER BY TAKING 1/2 OF THE ORIG JOB DISTANCES AT THE CLOSING CORNERS.

HIS RECORD JOB DISTANCE @ THE N1/4 COR SEC 4 IS 35.00 (ORIG 39.60 @ NW COR SEC 4 & ORIG 26.40 @ NE COR SEC 4. THE MEAN OF THE TWO IS 33.00. LOCKE USED 33 TO ESTABLISH THE N 1/4 COR SEC 4.)

HIS RECORD JOB DISTANCE @ THE N 1/4 COR SEC 3 IS 13.2 (ORIG 26.40 @ NW COR SEC 3 & ORIG 0' @ THE NE COR SEC 3. THE MEAN OF THE TWO IS 13.2. LOCKE USED 13.2 TO ESTABLISH THE N 1/4 COR SEC 3.

*D) Describe any material discrepancy between the location of the corner as restored or reestablished and the location of that corner as previously restored or reestablished by distance and direction. Show the discrepancy on the plan view drawing under (a), above. Show the distances between the corner as previously restored or reestablished and (1) the corner as restored or reestablished, and (2) to at least 4 of the witness monuments shown on the drawing in (a), above.*


AS PREVIOUSLY STATED & SHOWN ON SKETCH, THE 1992 WIDOT DISK, THE 1972 FD PIPE, & 1988 FD REROD THE DOES NOT FIT THE REFERENCE MONUMENTS.

I, **Donald Barnes**, hereby certify that the corner location as identified by the corner code index was determined by me under my direction and control and that this U.S. Public Land Survey Monument Record is correct and complete to the best of my knowledge and belief.

Seal  
Donald Barnes  
Emboss  
10/13/2009

SHEET 2 OF 4

CORNER CODE A-15(4)  
A-E 7.08 REQUIREMENT

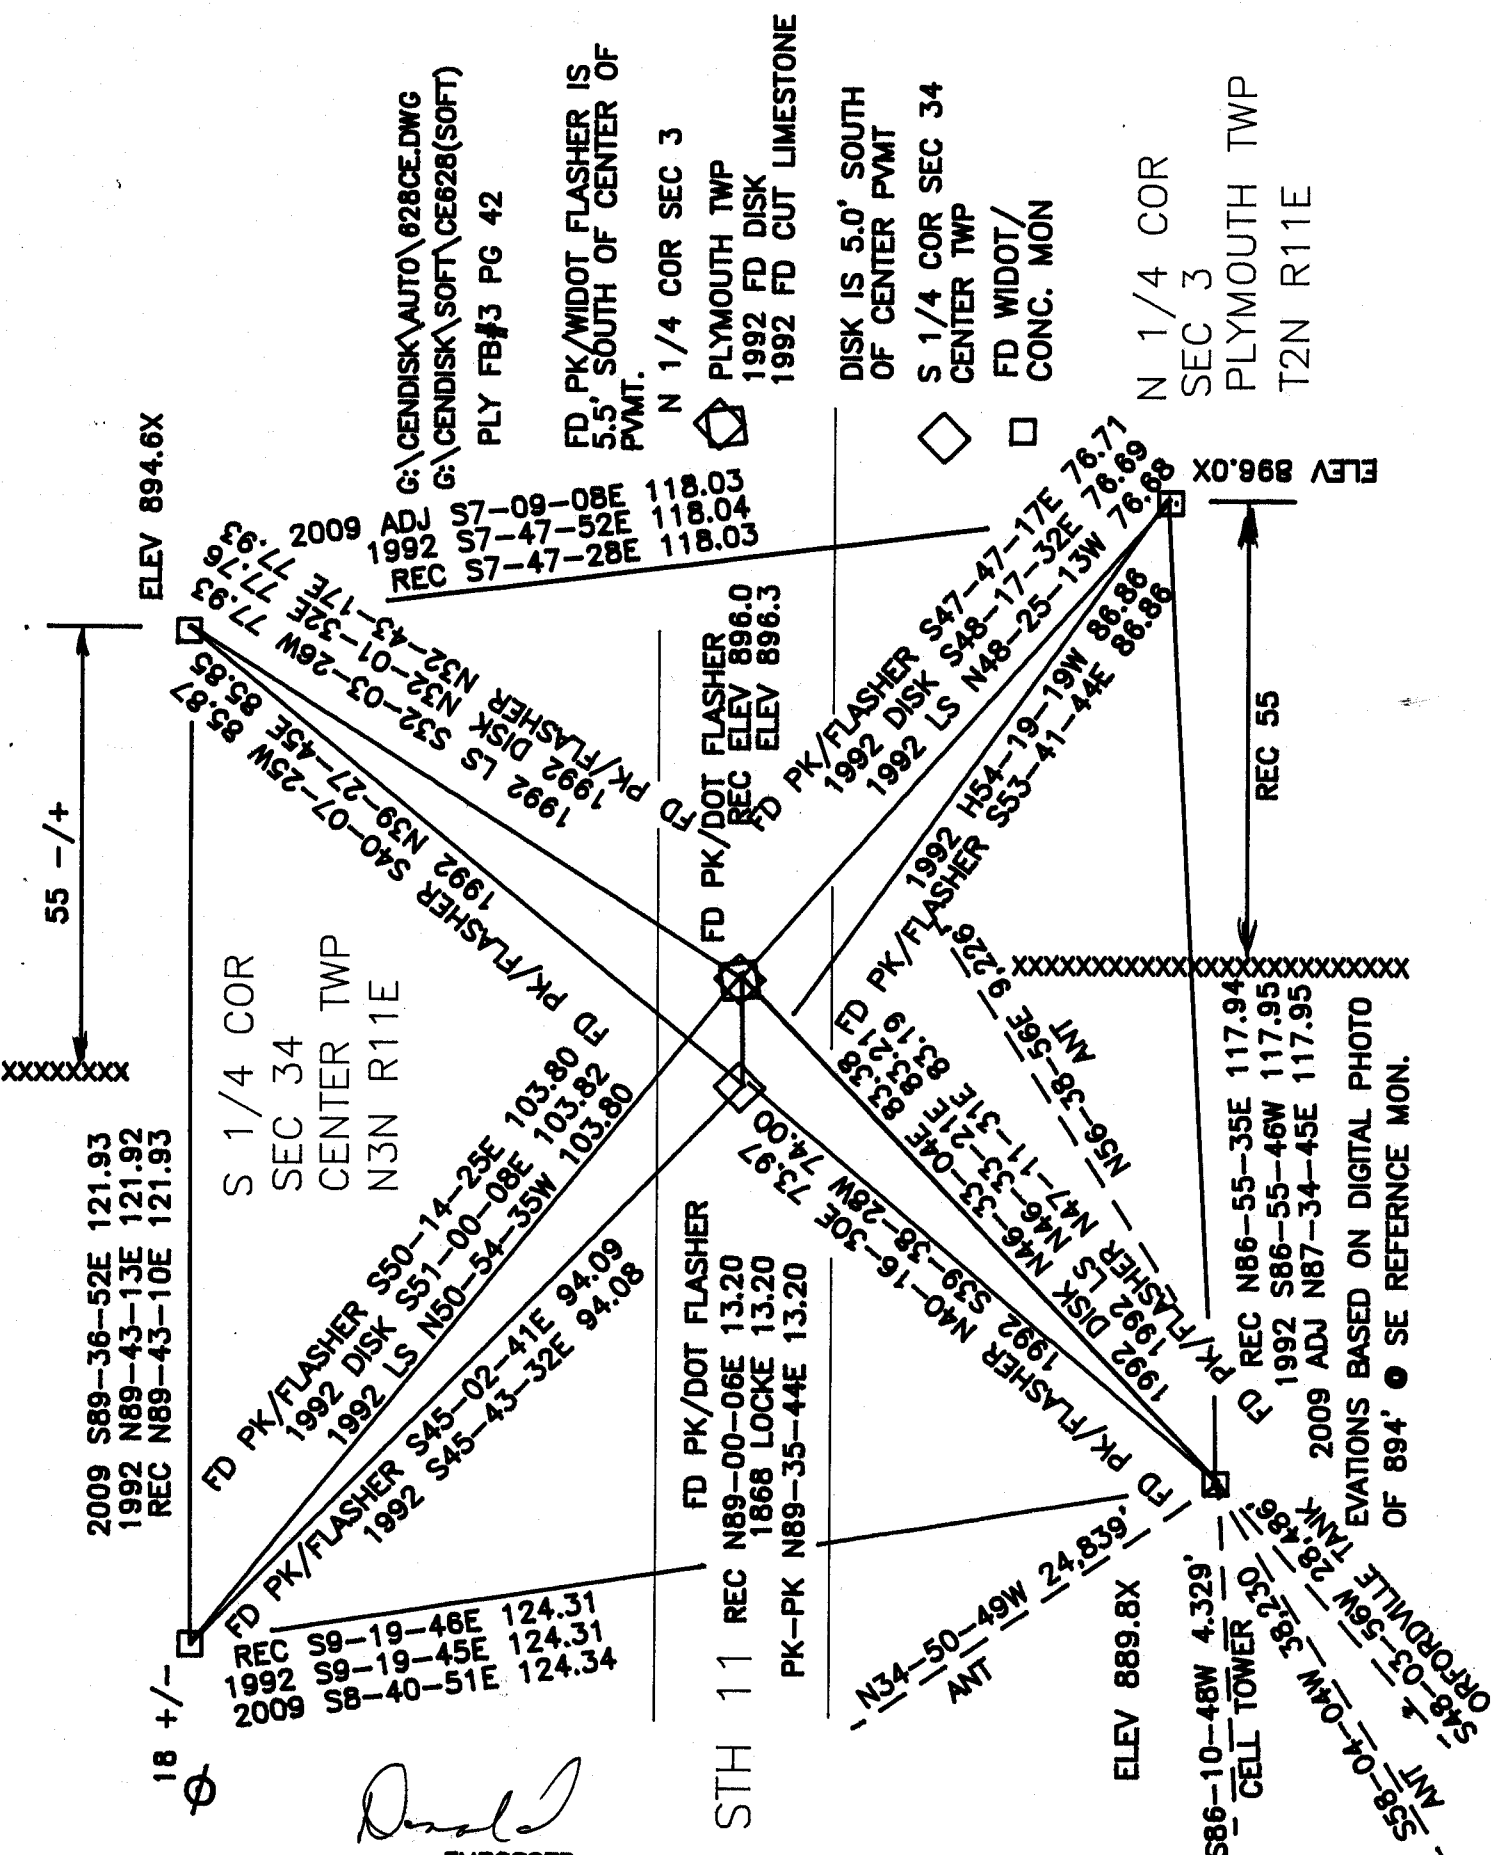

*Donald*  
 EMBOSSSED SEAL  
*Barnes*  
 10/13/2009

G:\CENDISK\AUTO\628CE.DWG  
 G:\CENDISK\SOFT\CE628(SOFT)  
 PLY FB#3 PG 42

FD PK/WIDOT FLASHER IS  
 5.5' SOUTH OF CENTER OF  
 PVMT.  
 N 1/4 COR SEC 3  
 PLYMOUTH TWP  
 1992 FD DISK  
 1992 FD CUT LIMESTONE

DISK IS 5.0' SOUTH  
 OF CENTER PVMT  
 S 1/4 COR SEC 34  
 CENTER TWP  
 FD WIDOT/  
 CONC. MON

N 1/4 COR  
 SEC 3  
 PLYMOUTH TWP  
 T2N R11E

EVATIONS BASED ON DIGITAL PHOTO  
 OF 894' SE REFERENCE MON.

T3N  
R11E

CENTER  
TWP

34

34

1995 BARNES A11 2009 BARNES N89-22-29E 26.47 2004 BARNES N89-33-46E 26.41 2002 REIGEL #14302 26.52 1997 BARNES 26.42	1995 LEUBENBERGER CSM18-425 26.46 1993 COMBS CSM17-75 26.40 1988 BARNES 6-388 26.40 1982 WIDOT INVERSE N89-03-59E 26.40 1933 SUNNY 3-235 26.4 1868 LOCKE 26.40 1833 HARRISON 26.40	2009 ADJ 5326.32 1997 BARNES 5326.18 1989 WIDOT 5326.25 1988 BARNES 6-388 5326.39 1868 LOCKE REMON 5326.53 1833 MULLETT 5280	2009 BARNES N89-21-39E 2667.96 2004 BARNES N89-21-40E 2667.99 1997 BARNES N89-21-37E 2667.92 1997 BARNES N89-21-37E 2667.92 1989 WIDOT INVERSE N88-43-23E 2667.91 1989 WIDOT N88-43-23E 2667.94 1988 BARNES 6-388 2667.91 1868 LOCKE 2668.05 1833 MULLETT 2640	1989 WIDOT INVERSE S36-37-17E 22.13 1989 WIDOT N88-56-43E 13.20 1976 BARNES 5-204 1.93 1868 LOCKE 13.2 1933 SUNNY 3-235 13.2 1933 SUNNY 5-204 1.93	1989 WIDOT INVERSE S36-37-17E 22.13 1992 BARNES A-15(1) 13.20 1997 BARNES N89-35-24E 13.20 1997 COMBS A15 13.25 2004 BARNES N89-34-16E 13.20 2009 BARNES N89-34-29E 13.20	1868 LOCKE VAR6-44 2645.28 1933 SUNNY 3-235 2645.4 1988 BARNES 6-388 2645.09 1989 WIDOT INV N89-20-08E 2644.82 1997 BARNES N89-34-59E 2644.99 2004 BARNES N89-34-56E 2645.15 2009 BARNES N89-34-55E 2645.15	1868 LOCKE VAR7-00 2654.85 1886 RUGER 2-272 VAR4-55 2654.52 1933 SUNNY 3-235 2653.6 1988 BARNES 6-388 2654.71 2004 BARNES N89-21-36E 2654.76 1989 WIDOT INVERSE N88-20-00E 2655.17 2009 BARNES N89-21-35E 2654.76	1868 LOCKE REMON 5300.13 1933 SUNNY 5299.0X 1988 BARNES 5299.80 1989 DOT 5299.99 2004 BARNES 5299.91 2009 ADJ 5299.91	1886 RUGER 2-272 VAR7-30 1889 WIDOT R/W 246,046.92 2,220,619.41 CUT LS	1886 RUGER 2-272 VAR7-30 1889 WIDOT 246,124.14 2,223,273.46 1833 HARRISON 2666.40 1868 LOCKE VAR7-16 2702.70 1877 RUGER 2-234 VAR5-37 2697.75	1988 BARNES 6-388 2701.33 1989 WIDOT 2695.72 2009 SO-25-42E 2701.37
--	--	---	--	---	--	---	---	--	---	--	---

1889 WIDOT MON TO BE SET  
246,046.92  
2,220,606.21

1982 WIDOT  
246,015.82  
2,217,948.38

1995 LEUBENBERGER CSM18-425  
1988 BARNES 6-388  
1988 BARNES 5-388  
2009 NO-49-20W 2587.08  
1913 OWEN #6335  
1868 LOCKE VAR7-35 2587.20

10/13/2009  
D. Barnes