

PLAT AND RECORD

Of a Survey on Section 16 T 3 R 13 E. of the 4 P. M. in Harmony Township

Rock County, Wisconsin, made January the 28th 1859


I hereby certify that the following is a correct record of said survey as made by me.

COUNTY BUILDING
IN CITY OF BELOIT

(Signed) Edward Ruger
EAR

County Surveyor.

Made for School District, X.

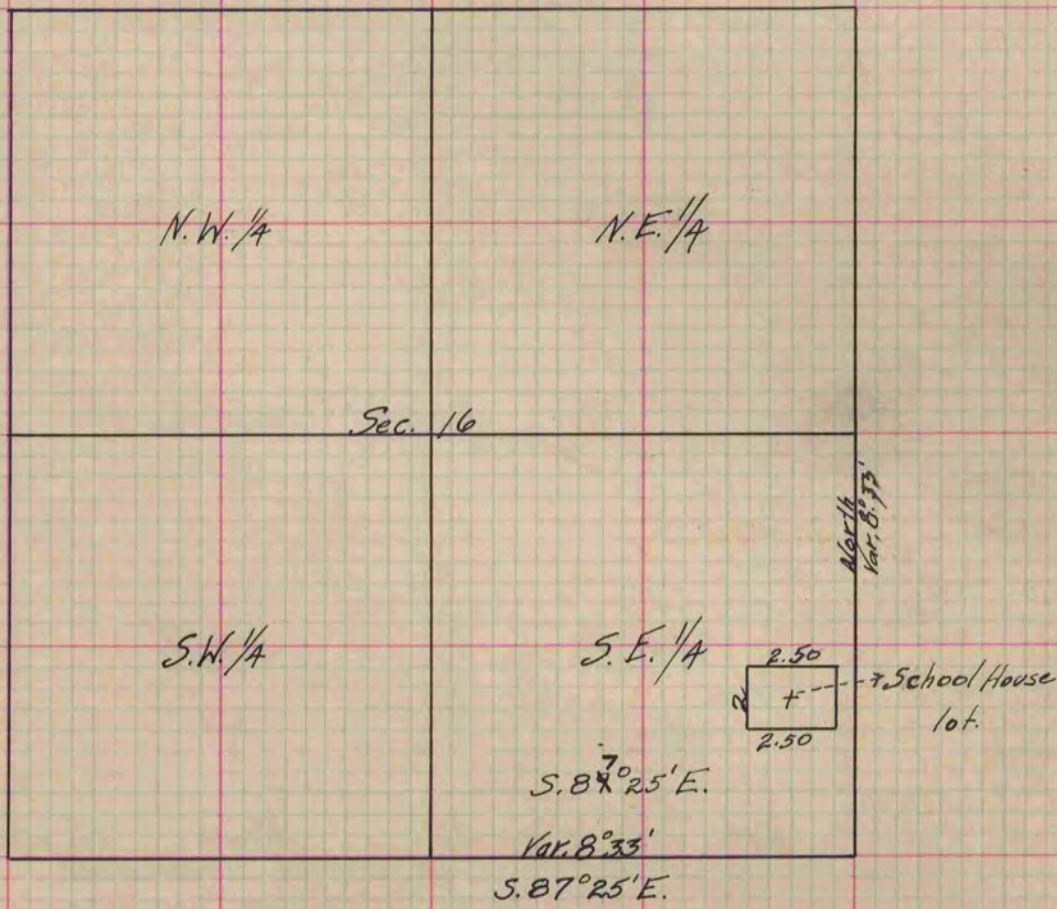

+ Represents the School House lot of the District above referred to.
Distances given in chains.

Copied from Page 88 Vol. 1 Original County Surveyor's Record.