

PLAT AND RECORD


Of a Survey on Section 22 T 4 R 12 E. of the 4 P. M. in Fulton Township
Rock County, Wisconsin, made February the 3rd 1858

I hereby certify that the following is a correct record of said survey as made by me.

COUNTY BUILDING
IN CITY OF БЕЛОIT

(Signed) Joseph Church
R.M.B.

County Surveyor.

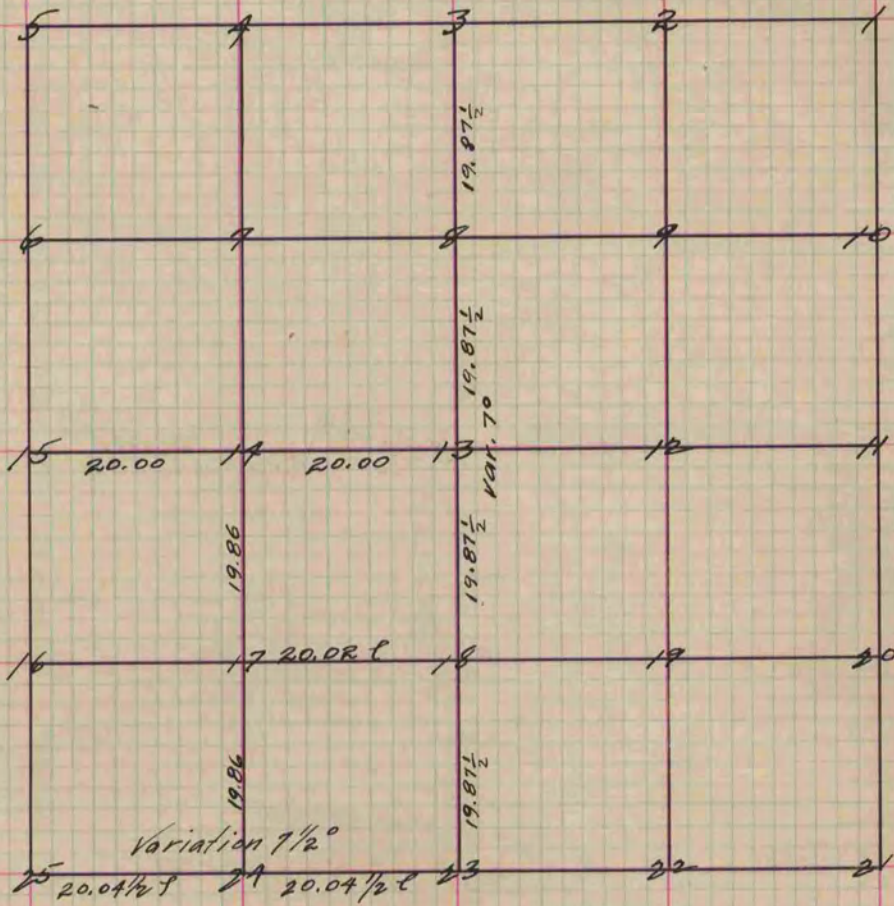

- Fig. 13 Br. O. 20 N. 56 1/2 E. 37 links.
- " " 12 N. 39 E. 25 "
- " 8 " " 18 N. 39 1/2 W. 27 "
- " 24 " " 8 S. 58 W. 28 "
- Hickory 8 N. 5 E. 37 "
- " 17 Br. O. 12 S. 14 E. 87 "
- " " 12 S. 85 W. 56 "
- " 18 Hickory 6 N. 44 1/2 E. 11 "
- Br. O. 10 S. 3 E. 9

Copied from Page 78 Vol. 1 Original County Surveyors Record.