

# U.S. PUBLIC LAND SURVEY MONUMENT RECORD

For Public Land Survey Corners in the


T. 4 N., R. 12 E.

## CORNER CODE INDEX

	1	2	3	4	5	6	7	8	9	10	11	12	13	14	15	16	17	18	19	20	21	22	23	24	25
A																									
B																									
C																									
D																									
E																									
F																									
G																									
H																									
I																									
J																									
K																									
L																									
M																									
N																									
O																									
P																									
Q																									
R																									
S																									
T																									
U																									
V																									
W																									
X																									
Y																									
Z																									

PLACE MONUMENT SYMBOL (◆) AT PROPER LOCATION ON ABOVE INDEX

### EXAMPLE

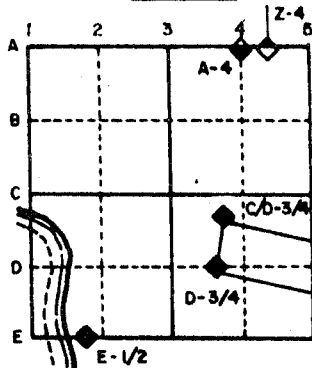

FULTON TWP  
ROCK COUNTY WI

IF AVAILABLE  
STATE PLANE COORDINATES


North (Y) \_\_\_\_\_ Eleve. (Z) \_\_\_\_\_  
 East (X) \_\_\_\_\_ Zone \_\_\_\_\_  
 Hor. Datum \_\_\_\_\_ Vert. Datum \_\_\_\_\_

(a) **◆ CORNER MONUMENT** **○ WITNESS MONUMENT**

GOVERNMENT CORNER REFERENCE  
Dane County, Wisconsin


Government corner 32  
 Township T 4 North  
 Range R 12 East  
 Date of survey \_\_\_\_\_  
 Fieldbook \_\_\_\_\_

SAID TO BE THERE DANE CO. 32 32 44.98 FOUND

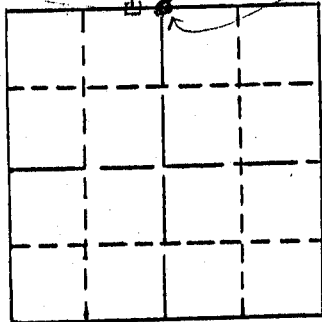

FULTON  
LOCATION SKETCH

This space for drawing of corner showing type of Monument set, distance and direction of reference monument, a note if distances are not measured on a horizontal plane, and where measurement is taken on reference point.

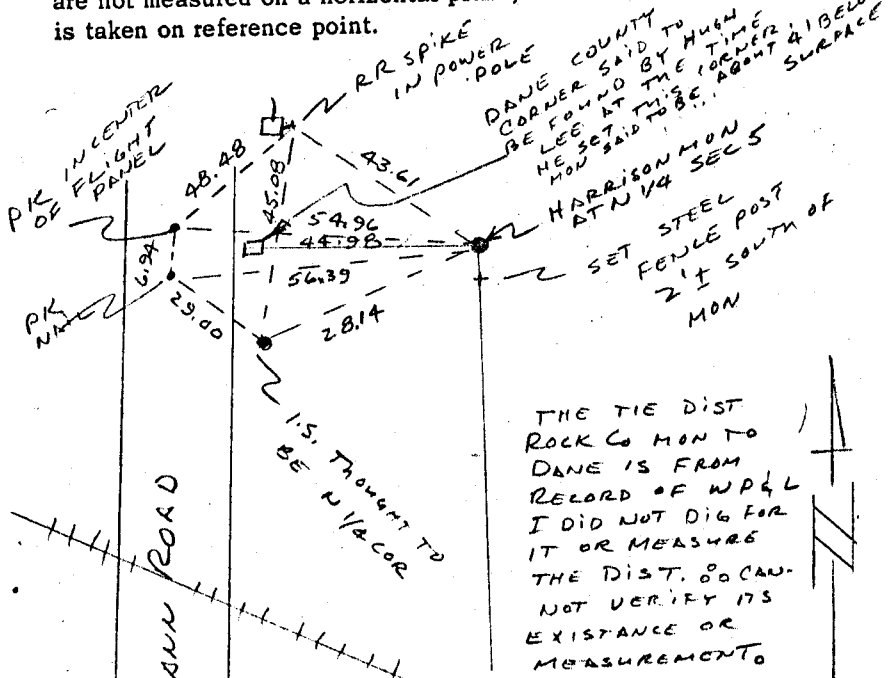

THE TIE DIST ROCK CO MON TO DANE IS FROM RECORD OF WPL I DID NOT DIG FOR IT OR MEASURE THE DIST. SO CAN NOT VERIFY ITS EXISTANCE OR MEASUREMENT.


**MICROFILMED**

SURVEYORS AFFIDAVIT (Surveyor must certify the method by which the above described corner has been located or relocated.)

STATE OF WISCONSIN )  
COUNTY OF DANE ) ss

I hereby certify that FOUND A HARRISON MONUMENT &

TIED IT AS SHOWN. MON SET BY HUGH LEE & TOM  
SPRAGUE PRIOR TO 1970 I BELIEVE

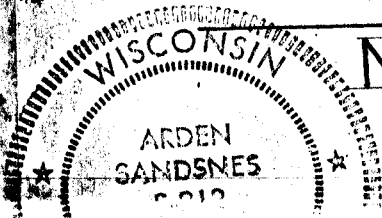

MAP # 1050  
**MICROFILMED**

Arden T. Sanderson  
Registered Land Surveyor - Number S. 812

SE 5 FULTON TWP B-FILE

**"FILE B-1"**

MATERIAL, EXCEPT WOOD. DESCRIBE THE CORNER AND THE WITNESS MONUMENTS.

CORNER CODE: A 7

CORNER NUMBER 2-7

PLBION

(b.) Describe any record evidence, monument evidence, occupational evidence, testimonial evidence or any other material evidence you considered, and whether the monument was found or placed.


(c.) Was the corner restored through acceptance of (1) an obliterated evidence location, or, (2) a found perpetuated location?

(d.) Describe any material discrepancy between the location of the corner as restored or reestablished and the location of that corner as previously restored or reestablished by distance and direction. Show the discrepancy on the plan view drawing under (a), above. Show the distances between the corner as previously restored or reestablished and (1) the corner as restored or reestablished, and (2) to at least 4 of the witness monuments shown on the drawing in (a), above.

(e.) Was the corner reestablished through lost corner proportionate methods? If so, show the method, including the directions and distances to other public land survey corners used as evidence or used for proportioning in determining the corner location.

TIES WERE MOVED FROM B-1  
FILES TO THIS FORM  
1/7/85 Dan Barnett

I, \_\_\_\_\_, hereby certify that the corner points as identified by the corner code index were, in a field survey on \_\_\_\_\_, established, re-established, monumented, re-monumented, recovered or restored as expressed below and in conformance with the regulations and rules as required in the current manual of survey instructions of the United States Department of Interior, Bureau of Land Management.

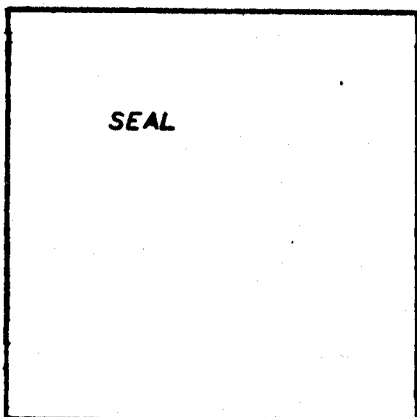

COUNTY SURVEYOR FILING DATA

Date of Computer Entry \_\_\_\_\_

Date Received \_\_\_\_\_

Date Microfilmed \_\_\_\_\_

Treasurer's Receipt No. \_\_\_\_\_

Number of Included Sheets \_\_\_\_\_

AFFIX YOUR LAND SURVEYOR SEAL.

CORNER  
CODE A2