

U.S. PUBLIC LAND SURVEY MONUMENT RECORD

For Public Land Survey Corners in:

WI ADMINISTRATIVE CODE A-E 7.08 REQUIREMENT

T. 2N., R. 10E

CORNER CODE INDEX

	1	2	3	4	5	6	7	8	9	10	11	12	13	14	15	16	17	18	19	20	21	22	23	24	25
A																									
B																									
C		6																							
D																									
E																									
F																									
G																									
H																									
I																									
J																									
K																									
L																									
M																									
N																									
O																									
P																									
Q																									
R																									
S																									
T																									
U																									
V																									
W																									
X																									
Y																									
Z																									

SPRING VALLEY TWP

ROCK COUNTY WI

IF AVAILABLE
ROCK COUNTY COORDINATES PREFERRED

North _____ Elev. _____

East _____

Hor. Datum _____ Vert. Datum _____

LATITUDE _____ ELLIPS. HT. _____

LONGITUDE _____

GPS (X) _____ TRAVERSE (X) _____

BASED ON THE FOLLOWING CONTROL:

PLACE MONUMENT SYMBOL AT PROPER LOCATION ON ABOVE INDEX

CORNER MONUMENT WITNESS MONUMENT

BEARINGS ARE BASED ON:

FIELD BOOK _____ PAGE # _____

SHEET 1 OF 2

SHOW A PLAN VIEW DRAWING DEPICTING THE CORNER MONUMENT AND SURROUNDING PHYSICAL FEATURES, INCLUDING THE EXCAVATION AREA AND DEPTH.

PLANNING & ZONING COMMITTEE ADOPTED THE ABOVE FORM ON 12/2/1982

CORNER CODE C-17(2)

SP518

(B) Describe any record evidence, monument evidence, occupational evidence, testimonial evidence or any other material evidence you considered, and whether the monument was found or placed.

- 1834 MILLER SET 1/4 SECTION POST IN MOUND OF EARTH AND SOD. 2383.92 TO NE CORNER OF SECTION 3.**
- 1855 CHURCH VOL 1 PG 43. STAKE CORRECT WITH FIELD NOTES. SHOWS THE FOLLOWING:
2678.28 TO CENTER OF SECTION 3.5356.56 TO W 1/4 CORNER OF SECTION 3**
- 1861 RUGER VOL 1 PG 150 THE EAST QUARTER POST BEING GONE PUT IT IN FROM THE SECTION CORNERS. DID NOT STATE WHAT HE PLACED. SHOWS THAT IT IS ON A STRAIGHT LINE BETWEEN THE SE AND NE CORNERS OF SECTION 3. SHOWS THE FOLLOWING DISTANCES: 2341.35 TO THE NE CORNER OF SECTION 3; 2592.48 TO THE SE CORNER OF SECTION 3; 2680.26 TO THE CENTER OF SECTION 3; 5360.52 TO THE W 1/4 CORNER OF SECTION 3.**
- 1929 BATTERMAN VOL 3 PG 159 FOUND OLD STAKE ROTTED AND HOLE SURROUNDED BY 3 HH 6" NORTH OF E/W FENCE AND 6" WEST OF N/S FENCE. REFERENCED SAME.**
- 1932 SUNNY VOL 3 PG 159 SHOWS NEW TIES WITH CORNER 11.92 WEST OF CENTER OF PAVEMENT. USES 2 OF BATTERMAN'S REFERENCE PIPES.**
- 1985 DOT C-17 FOUND 1" PIPE AND REFERENCED SAME. MAP SHOWS WEST OF WEST PAVEMENT EDGE.**
- 1990 BARNES C-17(1). FOUND 1" PIPE 20" DEEP. PLACED A MAGNET ON TOP OF THE PIPE AND REFERENCED SAME. DISTANCES TO THE NE AND SE CORNERS OF SECTION 3 ARE NOT IN HARMONY WITH RUGER'S 1861 DISTANCES. ACCORDING TO RUGER'S VAR. HE INTENDED TO PLACE THE CORNER ON A STRAIGHT LINE BETWEEN THE NE AND SE CORNERS. THE 1950 AIR PHOTOS SHOWS THAT THE E/W FENCE JOGS TO THE NORTH AT THE S 1/16 THE CORNER OF THE NE 1/4 OF SECTION 3. THE PHOTO ALSO INDICATES THAT THERE IS A E/W FENCED LANE THAT COMMENCES AT THIS POINT AND CONTINUES EAST. ALSO THE DISTANCE FROM THE N 1/4 CORNER TO THE E/W QUARTER LINE IS NOT IN HARMONY WITH RUGER'S DISTANCE. SINCE THE TERRAIN INDICATES THAT THERE WAS A ROAD CUT, I DID NOT EXCAVATE FOR RUGER'S OLD MONUMENT. MAPS SHOWS WEST OF WEST PAVEMENT EDGE.**

FOUND PIN THAT WAS NOT IN HARMONY WITH TIES.

C) Was the corner restored through acceptance of (1) an obliterated evidence location, or, (2) a found perpetuated location?

ACCEPTED FOUND PIPE WHICH PERPETUATES THE OLD STAKE SURROUNDED BY 3 HH THAT BATTERMAN FOUND IN 1929.

D) Describe any material discrepancy between the location of the corner as restored or reestablished and the location of that corner as previously restored or reestablished by distance and direction. Show the discrepancy on the plan view drawing under (a), above. Show the distances between the corner as previously restored or reestablished and (1) the corner as restored or reestablished, and (2) to at least 4 of the witness monuments shown on the drawing in (a), above.

SEE DRAWING.

I, Donald Barnes, hereby certify that the corner location as identified by the corner code index was determined by me under my direction and control and that this U.S. Public Land Survey Monument Record is correct and complete to the best of my knowledge and belief.

Seal

Donald Barnes
2003


05/08/00

Number of included sheets 1


CORNER CODE **C-17(2)**

A-E 7.08 REQUIREMENT

Donald Barnes
05/08/00

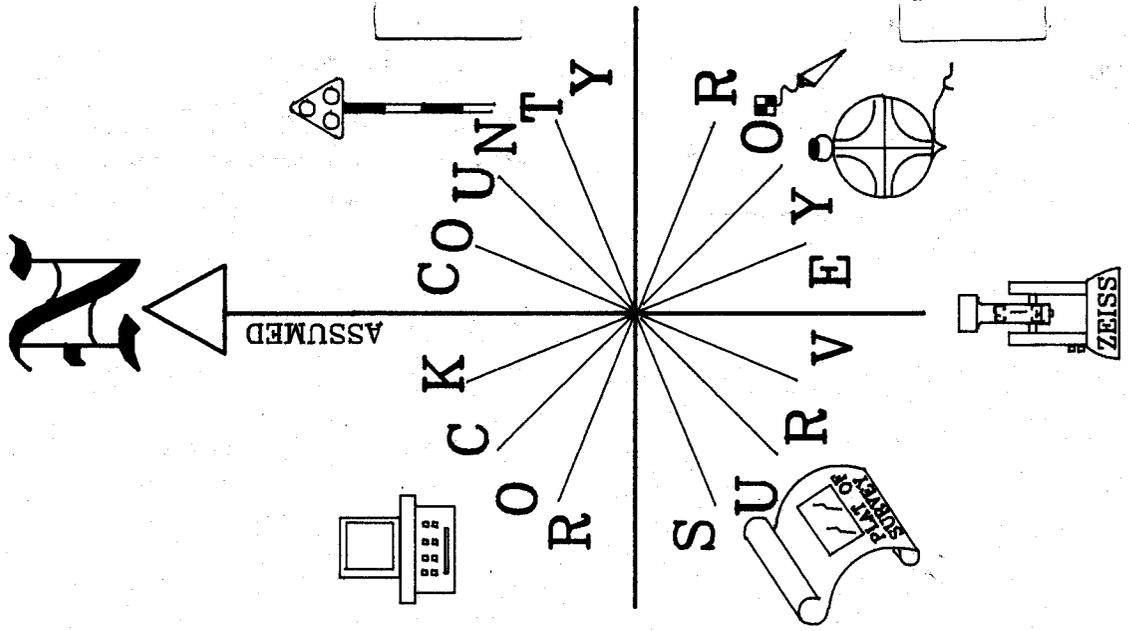

E 1/4 CDR
SEC 3
T2N R10E

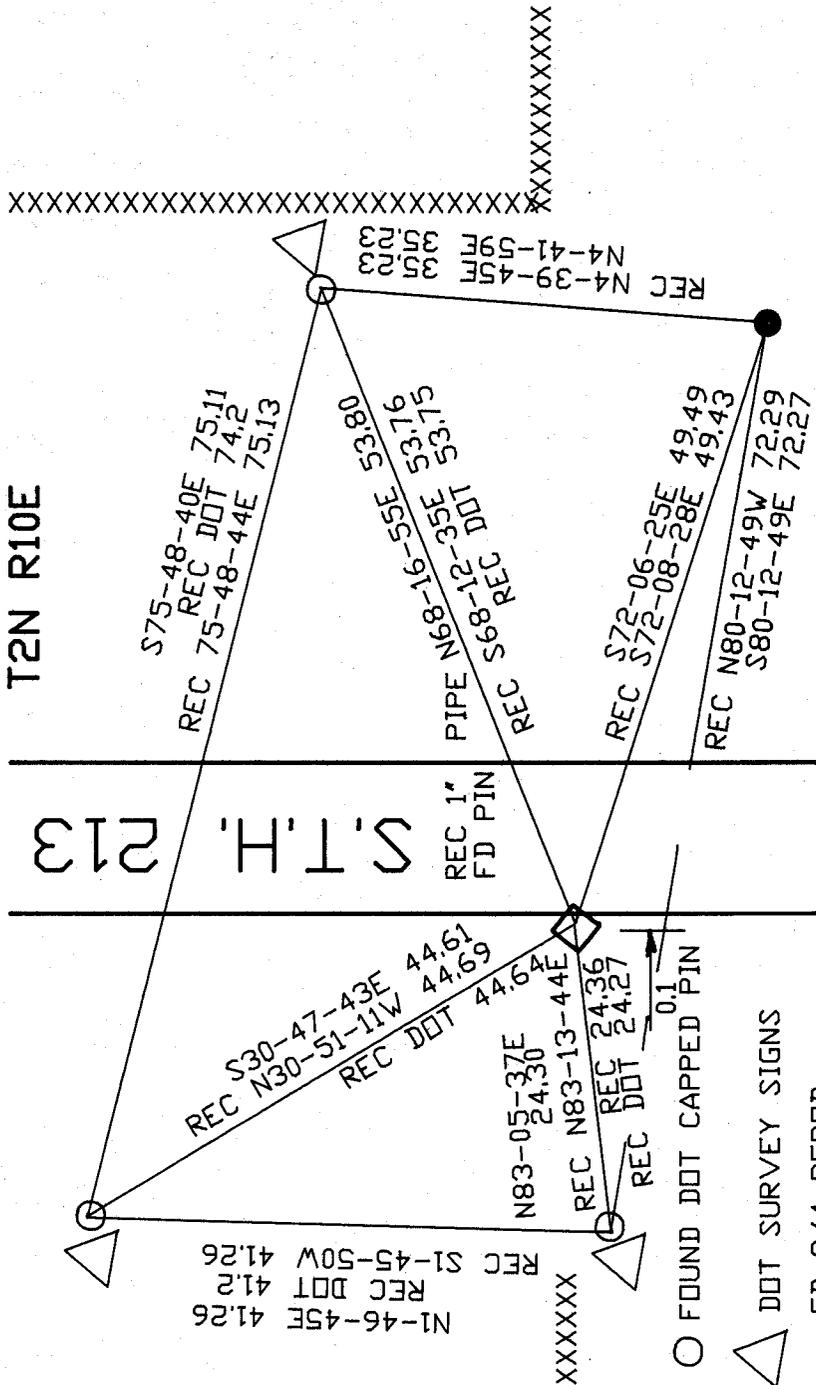

FIELD BOOK # 3 PG 30
OBSERVATION SHEET

DATA ENTRY FOUND IN OLD MAP.
RECORD BEARING & DISTANCES FROM
NE REFERENCE PIPE IS AS CORRECTED.

- FOUND DOT CAPPED PIN
- △ DOT SURVEY SIGNS
- FD 3/4 REROD
- ORANGE PLASTIC CAP

XXXXXXXXXXXXXXXXXXXXXXXXXXXX

C-17(2)