
Black nor required

U.S. PUBLIC LAND SURVEY MONUMENT RECORD

For Public Land Survey Corners in: WI ADMINISTRATIVE CODE A-E 7.08 REQUIREMENT

T.2 N., R. 13 E 4th P.M.

CORNER CODE INDEX

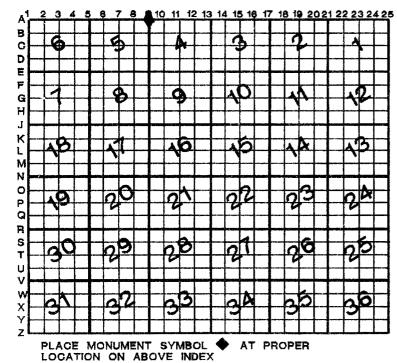

ROCK COUNTY, WI

IF AVAILABLE
ROCK COUNTY COORDINATES PERFERRED

North Elev	
East	
Hor. Datum Vert. Datum	
LATITUDE ELI	LIPS. HT.
LONGITUTE	
ELLIPS. DATUM	
NAD83(91) COUNTY LIST_	-
GPS (X) TRAVERSE (X)	
BASED ON THE FOLLOWING CON	TROL:

◆CORNER MONUMENT

WITNESS MONUMENT

BEARINGS ARE BASED ON:

(a)

FIELD	воок	A month of the latest and the latest	PAGE #	/	-			;	SHEET		OF	<u>z_</u>
SHOW	A PLA	N VIEW	DRAWING	DEPICTING	THE	CORNER	MONUMENT	AND	SURRO	UNDING		
PHYSIC	AL FE	ATURES,	INCLUDING	THE EX	CAVAT	ION AREA	AND DEPT	Ή.				
-	A 0 7A	LIINO CON	MUTTEE AND	DIED THE	ADOME	EODM ON	101011000					

- (B)Describe any record evidence, monument evidence, occupational evidence, testimonial evidence or any other material evidence you considered, and whether the monument was found or placed.
 1835 MULLETT CALLS FOR 2640 TO S 1/4 CORNERS OF SECTIONS 32 & 33.
- 1859 RUGER VOL 1 PG 119 POST SURROUNDED BY 5 LIMESTONES. CALLS FOR 2625.48 TO S 1/4 COR SEC 32.
- 1860 RUGER VOL 1 PG 127 CALLS FOR VAR 6-18 2625.48 TO S 1/4 COR SEC 32
- 1870 RUGER REMONUMENTATION FIELD NOTES. WEST ON SOUTH LINE OF SW 1/4 OF SEC 33 ON A VAR 5-25 AT 2648.58 INTERSECTED WEST BOUNDARY LINE FOUND STAKE SET BY SELF SURROUNDED BY LIMESTONES. PLACED CUT LIMESTONE. CALLS FOR VAR 5-37 2638.02 TO S 1/4 COR SEC 32 & 2626.14 TO E 1/4 COR SEC 32.
- 1877 RUGER VOL 3 PG 228 CALLS FOR STONE MONUMENT.
- 1883 RUGER VOL 2 PG 360 CALLS FOR 2661.34 TO W 1/4 COR SEC 4 LA PRAIRIE
- 1901 KERCH VOL 3 PG 5 FOUND MONUMENT & CALLS FOR 2648.8 TO S 1/4 COR
- SEC 33 & 2629 TO E 1/4 COR SEC 32.

 1935 B.J. SUNNY VOL 3 PG 273. SET 1X30" PIPE THRU CONC. PAVEMENT FOR CORNER. 15' EAST OF EAST FENCE ON NORTH RD, 89 SOUTH TO 30" MAPLE, 87.6' TO BOX ELDER.
- FOUND PIPE IN PAVEMENT SET BY SUNNY. 1964 BATTERMAN VOL 4 PG 106 REFERENCED MONUMENT.
- 197? HURD MAPPING CO. ESTABLISHED NAD27 COORDINATES.
- 1984 BARNES Z-9 DUG AND FOUND NOTHING. SET POLY MONUMENT. THE CORNER WAS ESTABLISHED USING KERCH & SUNNY'S RECORD DISTANCES. THIS WAS IN HARMONY WITH THE BENT REFERENCE PIPE TO THE SE. REFERENCED CORNER.
- 1985 BARNES TWP PROJECT. CALLS FOR N88-35-56W 2640.05 TO S 1/4 COR SEC 32, S88-38-20E 2648.72, & NO-04-00W 2629.57 TO W 1/4 COR SEC 33.
- 1988 BARNES Z-9(1) WITHIN TWO MONTHS, I FOUND THE SCHONSTEDT WAS NOT WORKING PROPERLY AND WAS SENT IN FOR REPAIR. BASED ON INFORMATION SUPPLIED BY RON COMBS, IF FOUND A 1" PIPE AND DROVE IT DEEP AND PLACED AN ALUMINUM MONUMENT. I REMOVED THE POLY MONUMENT THAT I INSTALLED IN 1984 & REFERENCED CORNER.
- 1988 DOT MADE ROAD IMPROVEMENTS & INSTALLED ROUND MONUMENT BOX AROUND EXISTING ALUM. MONUMENT.
- 1988 Z-9(2) FOUND ALUM MONUMENT IN ROUND DOT MONUMENT BOX & REFERENCED SAME.
- 1994 WIDOT Z-9(3) DOT ESTABLISHED NAD83(91) COORDINATES.
- Was the corner restored through acceptance of (1) an obliterated evidence location, or, (2) a found perpetuated location? ACCEPTED TIES. ALUM. MON WAS LEANING SO I USED TIES TO COMPUTE POSITION
- Describe any material discrepancy between the location of the corner as restored or reestablished and the location of that corner as previously restored or reestablished by distance and direction. Show the discrepancy on the plan view drawing under (a), above. Show the distances between the corner as previously restored or reestablished and (1) the corner as restored or reestablished, and (2) to at least 4 of the witness monuments shown on the drawing in (a), above.
- Was the corner reestablished through lost corner proportionate ods? If so, show the method, including the directions and (E) distances to other public land survey corners used as evidence or used for proportioning the corner location.
- I, Donald Barnes, hereby certify that the corner location as identified by the corner code index was determined by me under my direction and control and that this U.S. Public Land Survey Monument Record is correct and complete to the best of my knowledge and belief.

Number of included sheets

