

# U.S. PUBLIC LAND SURVEY MONUMENT RECORD


For Public Land Survey Corners in the  
T. 2 N., R. 13 E.

## CORNER CODE INDEX

	1	2	3	4	5	6	7	8	9	10	11	12	13	14	15	16	17	18	19	20	21	22	23	24	25
A																									
B																									
C	6																								
D		5																							
E			4																						
F				3																					
G					2																				
H																									
I																									
J																									
K																									
L																									
M																									
N																									
O																									
P																									
Q																									
R																									
S																									
T																									
U																									
V																									
W																									
X																									
Y																									
Z																									

PLACE MONUMENT SYMBOL (◆) AT PROPER LOCATION ON ABOVE INDEX

### EXAMPLE

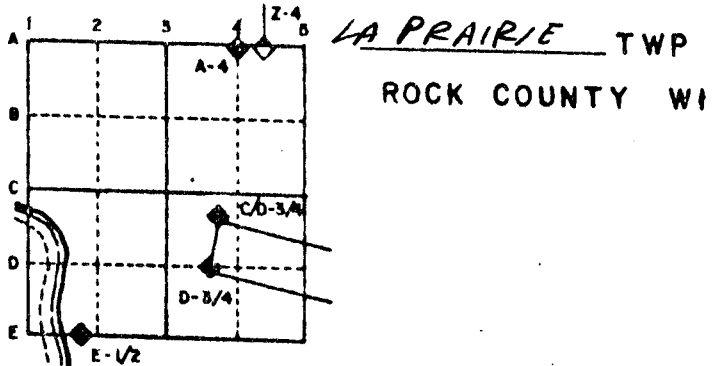

IF AVAILABLE  
STATE PLANE COORDINATES

North (Y) \_\_\_\_\_ Elev. (Z) \_\_\_\_\_  
 East (X) \_\_\_\_\_ Zone \_\_\_\_\_  
 Hor. Datum \_\_\_\_\_ Vert. Datum \_\_\_\_\_


e.)

◆ CORNER MONUMENT

○ WITNESS MONUMENT

REFERENCED FOR ROAD  
CONSTRUCTION.

BEARINGS ARE BASED ON: ASSUMED

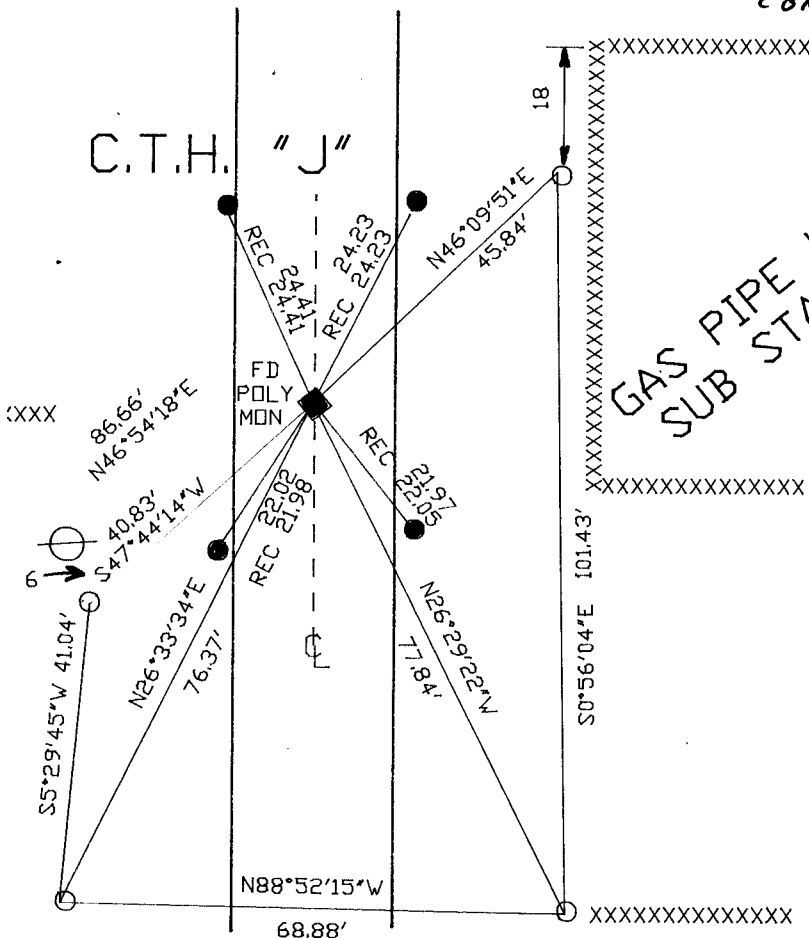


○ 3/4X24 REROD WITH ORANGE PLASTIC CAP

○ FD 1/2 REROD

◆ FOUND POLY MONUMENT WITH TOP BROKEN OFF

FIELD BOOK #3 PG 55

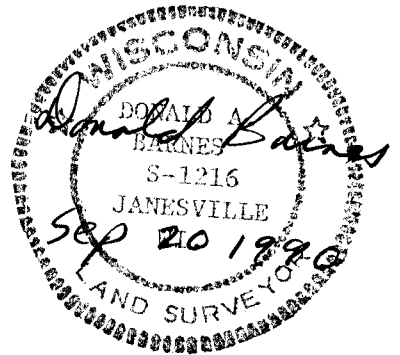

SHEET \_\_\_ OF \_\_\_

CORNER CODE: E9 (2)