

PUBLIC LAND SURVEY MONUMENT RECORD

For Public Land Survey Corners in the


T. 2 N., R. 13 E.

CORNER CODE INDEX

	1	2	3	4	5	6	7	8	9	10	11	12	13	14	15	16	17	18	19	20	21	22	23	24	25	
A																										
B																										
C																										
D																										
E																										
F																										
G																										
H																										
I																										
J																										
K																										
L																										
M																										
N																										
O																										
P																										
Q																										
R																										
S																										
T																										
U																										
V																										
W																										
X																										
Y																										
Z																										

PLACE MONUMENT SYMBOL (●) AT PROPER LOCATION ON ABOVE INDEX

EXAMPLE

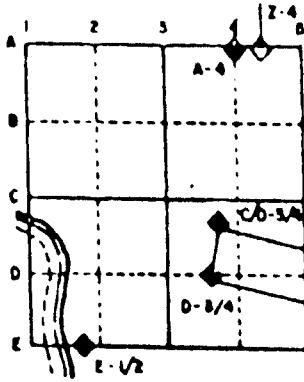

1/4 PRAIRIE TWP
ROCK COUNTY WI

IF AVAILABLE
STATE PLANE COORDINATES

North (Y) _____ Eleve. (Z) _____
 East (X) _____ Zone _____
 Hor. Datum _____ Vert. Datum _____

◆ CORNER MONUMENT



○ WITNESS MONUMENT

BEARINGS ARE BASED ON:

S 1/4 COR
SEC 25

FIELD

FIELD

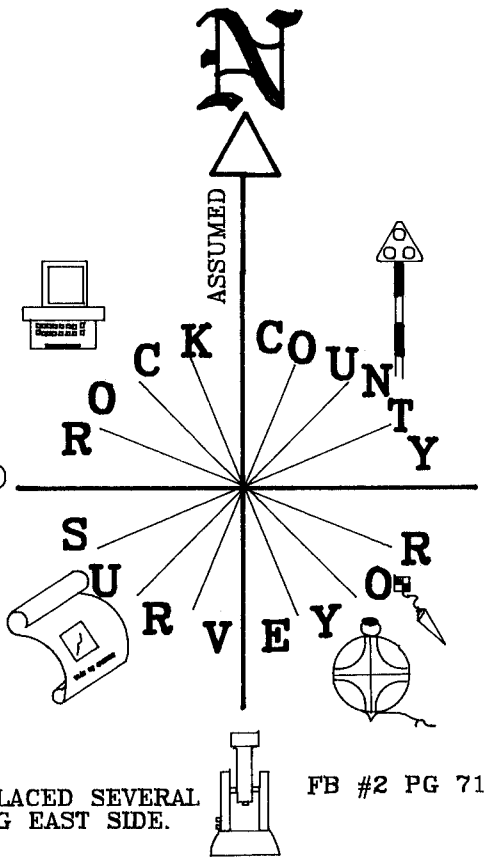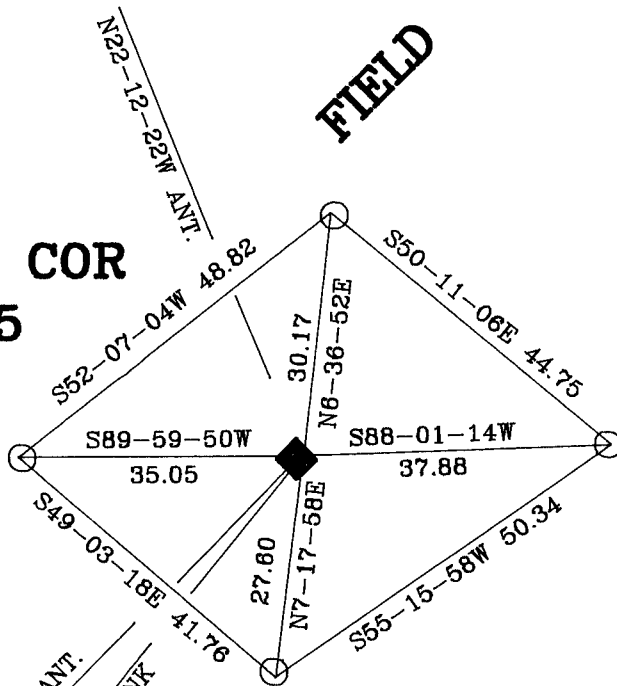

- ◆ FOUND CUT LIMESTONE PLACED SEVERAL MAGNETS 28" DEEP ALONG EAST SIDE.
- 3/4 24 REROD 18" DEEP WITH MAGNET

MONUMENT WILL BE DISTURBED BY LAND OWNER.
FENCES WERE REMOVED. LAND WILL BE CULTIVATED.

FB #2 PG 71

SHEET ___ OF ___

CORNER CODE

v23(1)

(B) Describe any record evidence, monument evidence, occupational evidence, testimonial evidence or any other material evidence you considered, and whether the monument was found or placed.

- 1834 LYONS ORIGINAL SURVEYOR CALLS FOR 2607.00' TO THE SE & SW CORNERS OF SECTION 25.
- 1865 LOCKE VOL 1 PG 236 CORNER LOST SET LIMESTONE 18X15X10 & SURROUNDED IT WITH 4 L.S. CALLS FOR 2608.32' TO SE & 2608.32' TO SW CORNERS OF SECTION 25, 5261.85 TO N 1/4 CORNER SEC 25, & 5255.58' TO S 1/4 COR SEC 36.
- 1870 RUGER REMONUMENTATION FIELD NOTES. WEST ON NORTH LINE OF NE 1/4 36 ON A VAR 5-15 OFFSET SOUTH 16LKS (10.56') AT 39.695 CH (2619.87') INTERSECTED 1/4 LINE 50 LKS (33') SOUTH OF 1/4 CORNER FOUND LIMESTONE AT CORNER VAR COR 4-46. CALLS FOR 2618.88 VAR 4-57 TO SW CORNER. PLACED CUT LIMESTONE.
- 1978 BARNES VOL 5 PG 439 SHOWS TRAVERSE CONNECTED TO CORNER.
- 1978 BARNES VOL 5 PG 440 FOUND CUT LIMESTONE AT GROUND LEVEL. PLACED 2X24 IRON PIPE HORIZONTALLY ON EAST SIDE OF STONE & REFERENCED CORNER.
- 1985 BARNES V-23 FOUND LIMESTONE & REFERENCED SAME.
- 1985 BARNES TOWNSHIP PROJECT. CALLS FOR N89-33-17W 2616.80 TO SW & S89-33-38E 2620.40 TO SE CORNERS OF SECTION 25.

FOUND CUT LIMESTONE & REFERENCED SAME.

C) Was the corner restored through acceptance of (1) an obliterated evidence location, or, (2) a found perpetuated location?

ACCEPTED FOUND PERPETUATED LOCATION.

D) Describe any material discrepancy between the location of the corner as restored or reestablished and the location of that corner as previously restored or reestablished by distance and direction. Show the discrepancy on the plan view drawing under (a), above. Show the distances between the corner as previously restored or reestablished and (1) the corner as restored or reestablished, and (2) to at least 4 of the witness monuments shown on the drawing in (a), above.

(E) Was the corner reestablished through lost corner proportionate methods? If so, show the method, including the directions and distances to other public land survey corners used as evidence or used for proportioning the corner location.

NO

I, Donald Barnes, hereby certify that the corner points as identified by the corner code index were, in a field survey on, SEP 16, 1994, established, re-established, monumented, re-monumented, recovered or restored as expressed below and in conformance with the regulations and rules as required in the current manual of survey instructions of the United States Department of Interior, Bureau of Land Management.

seal

Sep 21, 1994
Donald Barnes

EMBOSS LAND SURVEYOR SEAL

COUNTY SURVEYOR FILING DATA

Date of computer entry _____

Date microfilmed _____

Number of included sheets _____
CORNER CODE