

# U.S. PUBLIC LAND SURVEY MONUMENT RECORD

For Public Land Survey Corners in the


T. 2 N., R. 10 E.

## CORNER CODE INDEX

	1	2	3	4	5	6	7	8	9	10	11	12	13	14	15	16	17	18	19	20	21	22	23	24	25
A																									
B																									
C		6																							
D			5																						
E				4																					
F					3																				
G						2																			
H																									
I																									
J																									
K																									
L																									
M																									
N																									
O																									
P																									
Q																									
R																									
S																									
T																									
U																									
V																									
W																									
X																									
Y																									
Z																									

PLACE MONUMENT SYMBOL (◆) AT PROPER LOCATION ON ABOVE INDEX

### EXAMPLE

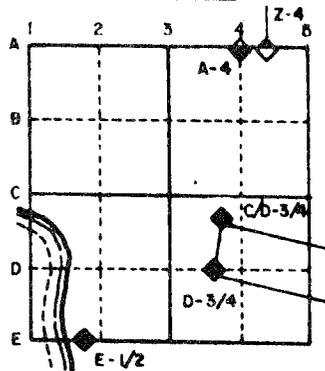

SPRING VALLEY TWP  
ROCK COUNTY WI


IF AVAILABLE  
STATE PLANE COORDINATES

North (Y) \_\_\_\_\_ Elev. (Z) \_\_\_\_\_  
 East (X) \_\_\_\_\_ Zone \_\_\_\_\_  
 Hor. Datum \_\_\_\_\_ Vert. Datum \_\_\_\_\_

(a.)

◆ CORNER MONUMENT      ○ WITNESS MONUMENT

BEARINGS ARE BASED ON: ASSUMED DATUM

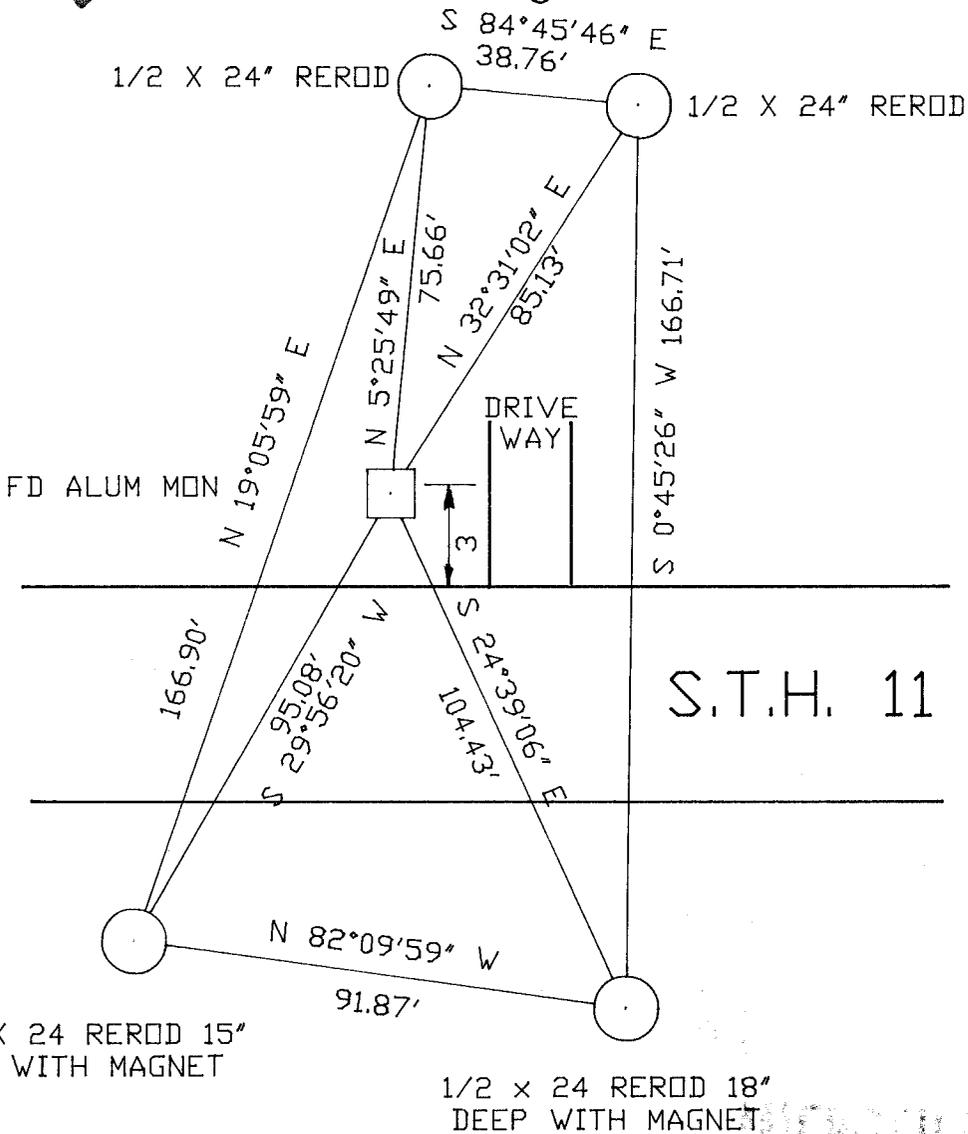

FIELD BOOK 2 PAGE # 66

SHOW A PLAN VIEW DRAWING DEPICTING THE CORNER MONUMENT AND SURROUNDING PHYSICAL FEATURES, INCLUDING THE EXCAVATION AREA AND DEPTH. THE CORNER MONUMENT SHALL HAVE THE FOLLOWING CHARACTERISTICS: 1) HAVE AT LEAST TWO PREDETERMINED BREAK-OFF POINTS. 2) IF BROKEN, LEAVE A PERMANENTLY MAGNETIZED REMNANT AT THE ORIGINAL POINT. 3) MUST BE EXTENDABLE. 4) THE CAP IS INSCRIBED: ROCK COUNTY SURVEY MONUMENT - PENALTY FOR DISTURBING MARKER. 5) OR AN EXISTING CUT LIMESTONE. AN IRON PIPE 1 1/2" x 4'0" (MINIMUM) MAY BE USED IN AREAS WHERE GROUND WATER IS WITHIN ONE FOOT OF THE SURFACE. IF THE CORNER IS OCCUPIED BY AN IMPROVEMENT (MANHOLE, BURIED CABLE, ETC.) ANY DURABLE, DISTINCT MONUMENT MAY BE USED. CORNERS SHALL BE REFERENCED WITH AT LEAST 4 DURABLE WITNESS MONUMENTS. WITNESS MONUMENTS SHALL BE MADE OF CONCRETE, NATURAL STONE, IRON OR OTHER EQUALLY DURABLE MATERIAL, EXCEPT WOOD. DESCRIBE THE CORNER AND THE WITNESS MONUMENTS.

CORNER CODE:  
N3(1)


(b.) Describe any record evidence, monument evidence, occupational evidence, testimonial evidence or any other material evidence you considered, and whether the monument was found or placed.

(c.) Was the corner restored through acceptance of (1) an obliterated evidence location, or, (2) a found perpetuated location?

(d.) Describe any material discrepancy between the location of the corner as restored or reestablished and the location of that corner as previously restored or reestablished by distance and direction. Show the discrepancy on the plan view drawing under (a), above. Show the distances between the corner as previously restored or reestablished and (1) the corner as restored or reestablished, and (2) to at least 4 of the witness monuments shown on the drawing in (a), above.

(e.) Was the corner reestablished through lost corner proportionate methods? If so, show the method, including the directions and distances to other public land survey corners used as evidence or used for proportioning in determining the corner location.

I, Donald Barnes, hereby certify that the corner points as identified by the corner code index were, in a field survey on June 26 1989, established, re-established, monumented, re-monumented, recovered or restored as expressed below and in conformance with the regulations and rules as required in the current manual of survey instructions of the United States Department of Interior, Bureau of Land Management.

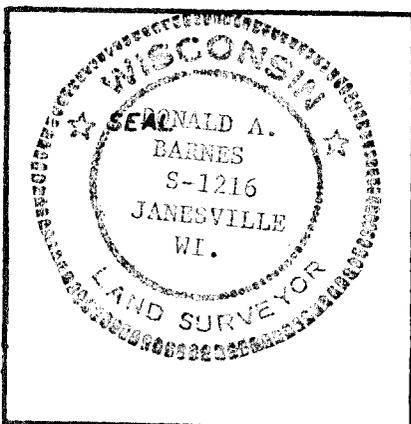

COUNTY SURVEYOR FILING DATA

Date of Computer Entry \_\_\_\_\_

Date Received \_\_\_\_\_

Date Microfilmed \_\_\_\_\_

Treasurer's Receipt No. \_\_\_\_\_


Number of Included Sheets 1

AFFIX YOUR LAND SURVEYOR SEAL. CORNER CODE N30

(B) Describe any record evidence, monument evidence, occupational evidence, testimonial evidence or any other material evidence you considered, and whether the monument was found or placed.

- 1866 LOCKE VOL 1 PG 255 FOUND STUMPS OF B.T.s & OLD STAKE SET STAKE (DIST. TO W.B.T. 64.2). SHOWS A DISTANCE OF 2633.90' TO CENTER OF SEC 18.
- 1869 LEE VOL 1 PG 352 FOUND OLD STAKE AND STUMPS OF BTs. USED CORNER TO SUBDIVIDE SECTION 19
- 1934 SUNNY VOL 3 PG 264 SET 1 1/2" PIPE MONUMENT SURROUNDED IT WITH 4 STONES. 24" MAPLE BEARS N62E 57' 13.5' N OF CENTER OF CONC. PAVMT. SHOWS A DISTANCE OF 2821.4 TO THE SW COR OF SEC 18, 2620.7 TO SE COR SEC 18, 5282.7 TO FENCE & ROAD INTERSECTION AT S 1/4 COR SEC 19, AND 5270.5 TO FENCE INT AT N 1/4 COR SEC 18
- 1977 TALARCZK VOL 6 PG 367 DISTANCE OF 2818.32 TO SW COR SEC 18.
- 1984 BARNES VOL 6 PG 325 FOUND BENT GAS PIPE. SHOWS A DISTANCE OF 2623.53 TO SE CORNER SEC 18, 2818.18 TO SW CORNER OF SEC 18, AND 2632.07 TO FOUND LIMESTONE AT CENTER OF SECTION 19.
- 1987 BARNES VOL 6 PG 367 SHOWS A GRID DISTANCE BY SCHNEIDER OF 2818.14 TO SW COR SEC 18, 2623.67 TO SE COR SEC 18.
- 1987 SCHNEIDER VOL 7 PG 371 COORDINATES OF 230,089.23; 2,173,194.76 AND COORDINATES BY BARNES OF 230,089.28; 2,173,193.92
- 1987 BARNES N-3 FOUND BENT GAS PIPE. REPLACED SAME WITH POLY MONUMENT & REFERENCED CORNER. SHOWS COORDINATES OF 230,089.28; 2,173,193.92

(c) Was the corner restored through acceptance of (1) an obliterated evidence location, or, (2) a found perpetuated location?

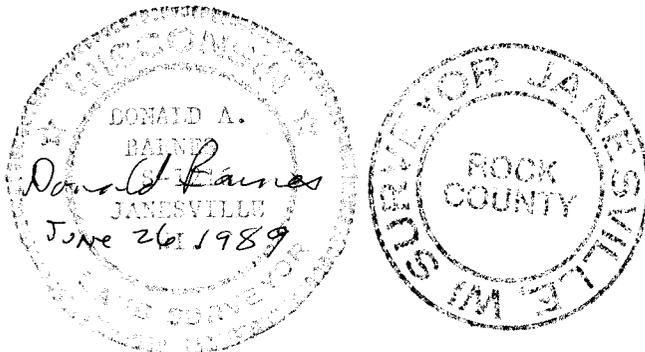

2 OF 2

N 3