

U.S. PUBLIC LAND SURVEY MONUMENT RECORD

For Public Land Survey Corners in:

WI ADMINISTRATIVE CODE A-E 7.08 REQUIREMENT

T. 4 N., R. 11 E 4th P.M.

CORNER CODE INDEX

PORTER TWP
ROCK COUNTY, WI

IF AVAILABLE
ROCK COUNTY COORDINATES PREFERRED

1	2	3	4	5	6	7	8	9	10	11	12	13	14	15	16	17	18	19	20	21	22	23	24	25
A	6																							
B		5																						
C			4																					
D				3																				
E					2																			
F						1																		
G	7																							
H		8																						
I			9																					
J				10																				
K					11																			
L						12																		
M	18																							
N		17																						
O			16																					
P				15																				
Q					14																			
R						13																		
S	19																							
T		20																						
U			21																					
V				22																				
W					23																			
X						24																		
Y	30																							
Z		29																						
			28																					
				27																				
					26																			
						25																		
							30																	
								29																
									28															
PLACE MONUMENT SYMBOL \blacklozenge AT PROPER LOCATION ON ABOVE INDEX

North _____ Elev. _____

East _____

Hor. Datum _____ Vert. Datum _____

LATITUDE _____ ELLIPS. HT. _____

LONGITUDE _____

ELLIPS. DATUM _____

NAD83(91) _____ COUNTY _____ LIST _____



GPS (X) _____ TRAVERSE (X) _____

BASED ON THE FOLLOWING CONTROL:


\blacklozenge CORNER MONUMENT

WITNESS MONUMENT

(a)

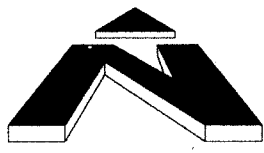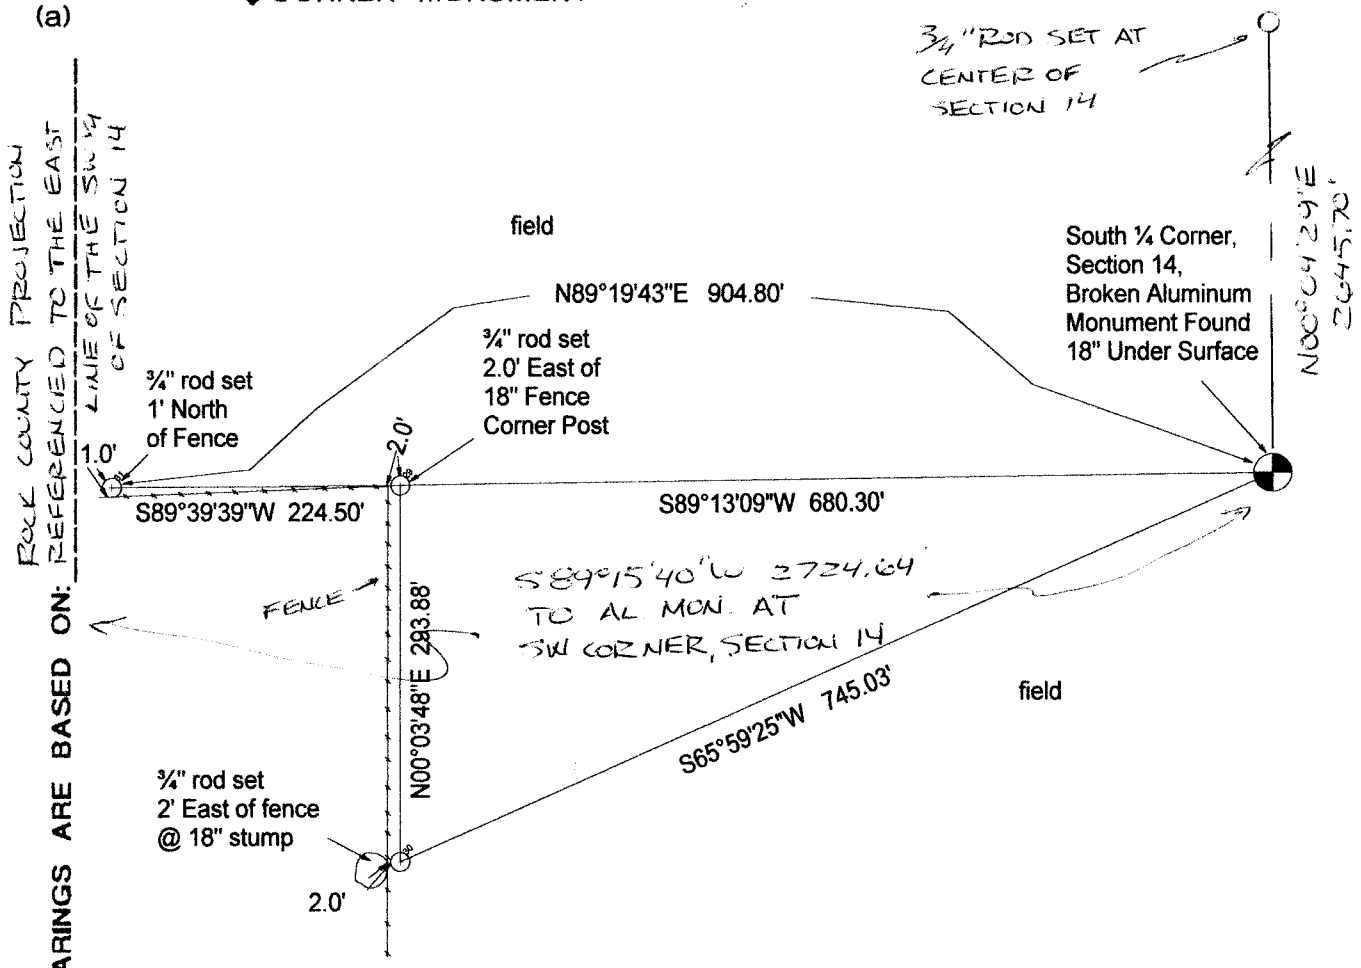

Scale 1" = 150'

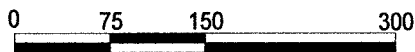

FIELD BOOK _____ PAGE # _____

SHEET 1 OF 2

SHOW A PLAN VIEW DRAWING DEPICTING THE CORNER MONUMENT AND SURROUNDING PHYSICAL FEATURES, INCLUDING THE EXCAVATION AREA AND DEPTH.

PLANNING & ZONING COMMITTEE ADOPTED THE ABOVE FORM ON 12/2/1982

CORNER CODE N-19(1)

B) Describe any record evidence, monument evidence, occupational evidence, testimonial evidence or any other material evidence you considered, and whether the monument was found or placed.

BARNES ESTABLISHED CORNER MIDWAY BETWEEN SE AND SW CORNERS OF SECTION 14. ALUMINUM MONUMENT WAS PLACED. I FOUND THE MONUMENT BASE INTACT IN A PLOWED FIELD. REFERENCE TIES WERE SET AS INDICATED

C) Was the corner restored through acceptance of (1) an obliterated evidence location, or, (2) a found perpetuated location?

FOUND


D) Describe any material discrepancy between the location of the Corner as restored or reestablished and the location of that corner as previously restored or reestablished by distance and direction. Show the discrepancy on the plan view drawing under (a), above. Show the distances between the corner as previously restored or reestablished and (1) the corner as restored or reestablished, and (2) to at least 4 of the witness monuments shown on the drawing in (a), above.

NONE

E) Was the corner reestablished through lost corner proportionate methods? If so, show the method, including the directions and distances to other public land survey corners used as evidence or used for proportioning the corner location.

NA

I, DAVID RIESOP, hereby certify that the corner location as identified by the corner code index was determined by me under by direction and control and that this U.S. Public Land Survey Monument Record is correct and complete to the best of my knowledge and belief.

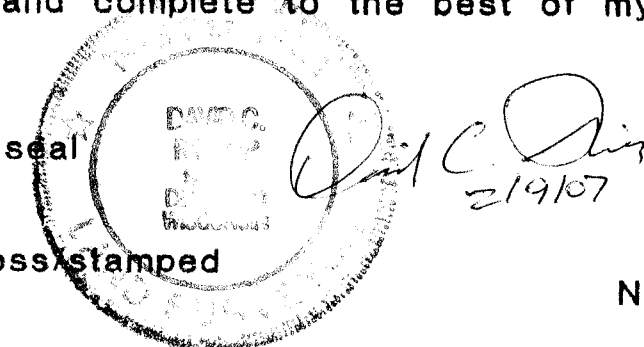

embossed/stamped

Number of included sheets 2082