

Paper weight-110# (minimum)

Black nonfading ink required

# U.S. PUBLIC LAND SURVEY MONUMENT RECORD

For Public Land Survey Corners In:  
T. 4 N. R. 11 E. 4th P.M.  
CORNER CODE INDEX

WI ADMINISTRATIVE CODE A-E 7.08 REQUIREMENT  
REV 10/23/2004 USMONREC.DWG

**PORTER** TWP  
**ROCK COUNTY WI**

IF AVAILABLE  
ROCK COUNTY COORDINATES PREFERRED

A	1	2	3	4	5	6	7	8	9	10	11	12	13	14	15	16	17	18	19	20	21	22	23	24	25	A
B		6				5				4				3			2			1						B
C																										C
D																										D
E																										E
F																										F
G																										G
H																										H
J																										J
K																										K
L																										L
M																										M
N																										N
O																										O
P																										P
Q																										Q
R																										R
S																										S
T																										T
U																										U
V																										V
W																										W
X																										X
Y																										Y
Z																										Z

North \_\_\_\_\_ Elev. \_\_\_\_\_

East \_\_\_\_\_

Hor. Datum \_\_\_\_\_ Vert. Datum \_\_\_\_\_

LATITUDE \_\_\_\_\_ ELLIPS. HT. \_\_\_\_\_

LONGITUDE \_\_\_\_\_

NAD83(91) \_\_\_\_\_ NETWORK ADJ. YR \_\_\_\_\_

GPS (X) \_\_\_\_\_ TRAVERSE (X) \_\_\_\_\_

BASED ON THE FOLLOWING CONTROL:

PLACE MONUMENT SYMBOL  AT PROPER LOCATION ON ABOVE INDEX

CORNER MONUMENT

WITNESS MONUMENT

BEARINGS ARE BASED ON: \_\_\_\_\_

FIELD BOOK \_\_\_\_\_ PAGE # \_\_\_\_\_

SHEET 1 OF 3

SHOW A PLAN VIEW DRAWING DEPICTING THE CORNER MONUMENT AND SURROUNDING PHYSICAL FEATURES, INCLUDING THE EXCAVATION AREA AND DEPTH.

PLANNING & ZONING COMMITTEE ADOPTED THIS FORM ON 12/2/1982

CORNER CODE J-19(1)

PO550

N1/4CORSEC14

(B) Describe any record evidence, monument evidence, occupational evidence, testimonial evidence or any other material evidence you considered, and whether the monument was found or placed.

1833 HARRISON (OCT 31<sup>ST</sup>) T4N R11E 4<sup>TH</sup> MER. EAST ON RAND.  
BET. 11 & 14

495.0 LEAVE PRAIRIE & ENTER TIMBER  
2178.0 CAT-FISH CRK SET MEANDER POST  
2482.26 LEFT CAT-FISH CRS S SET MEANDER POST  
2640.0 TEMPY 1/4 SEC COR  
5214.0 ENTER PRAIRIE  
5332.80 INT. E BDY 16.5' NORTH OF POST  
LAND ROLLING 2<sup>ND</sup> RATE RED, BURR & WHITE  
OAK TIMBER

WEST COR. WEST BETW. SECS 11 & 14

2640.0 QUARTER SEC. COR {WHITE OAK 8 S60W  
39.60'

2850.54 CAT-FISH SET MEANDER POST ON A RED OAK  
10 IN DIAM.

3154.80 LEAVE CAT-FISH WHITE OAK 14 S88W 6.6'  
5332.80 SEC COR

1854 STEBBIN #3585?? PLAT OF SURVEY USED THE CORNER FOR  
A LARGE SURVEY IN SECTION 14. STATES NOTHING ABOUT  
THE CORNER. CALLS FOR DISTANCE OF 384.16 FEET TO A  
MEANDER CORNER THAT IS TO THE SOUTH. SHOWS A  
MEANDER LINE ALONG THE RIVER.

1855 PORTER TWP RD REC BK 1 PG 6 & 7 BEGINNING AT THE 1/4  
POST ON THE EAST LINE OF SEC 13 T4N R1E; THENCE  
WEST ON THE CENTER LINE OF SEC 13; 4540.8'; THENCE  
S6E 419.76'; THENCE S40W 396' DOWN A RAVINE; THENCE  
N82W 198' ACROSS THE CATFISH RIVER; THENCE N15W  
770.88' TO THE CENTER LINE OF SEC 13; THENCE WEST ON  
SAID LINE 122' TO 1/4 POST ON WEST LINE OF SEC 13;  
THENCE WEST ON THE CENTER LINE OF SEC 14, 2640' TO  
CENTER OF SEC 14; THENCE NORTH ON THE N & S CENTER  
LINE OF SEC 14 2057.88' TO RIVER; THENCE N44W 808.5'  
TO NORTH LINE OF SEC 14; THENCE WEST ON THE NORTH  
LINE OF 14, 1897.5' TO NW COR OF 14, THENCE SOUTH 33';  
THENCE WEST PARALLEL TO NORTH LINE OF SEC 15, 3960'  
TO RD RUNNING NORTH AND SOUTH THROUGH SEC 15;  
AND NOW THEREFORE WE THE SUPERVISORS """" DELCARE  
THE ABOVE DESCRIBED RD TO BE A PUBLIC HIGHWAY 66'  
WIDE """" """" """" DECLARE THE ABOVE DESCRIBED ROAD TO  
BE A PUBLIC HIGHWAY 66' WIDE,

1886 RUGER VOL 2 PG 282 DROVE STAKE SURROUNDED BY 3  
H.H. STONES. SHOWS CORNER ON LINE WITH SW AND SE  
CORNERS OF SECTION 11 AND 2722.50 FEET FROM EACH.  
USED CORNER TO SUBDIVIDE SECTION 11.

1980 YOUNG CSM VOL 10 PG 148©150 CALLS FOR THE  
NORTH/SOUTH QUARTER LINE AND THE N1/4 CORNER OF  
SECTION 14. STATES NOTHING ABOUT THE CORNER.

1989 RIESOP #11399 PLAT OF SURVEY. CALLS FOR THE WEST  
LINE OF THE NW1/4 OF THE NE 1/4 OF SECTION 14 PER CSM  
VOL 10 PG 148 -150.

1991 BARNES VOL 6 PG 412 FD ALUM MON N89-32-55E 2723.42  
TO FD PIPE @ SE COR SEC 11, S89-33-35W 2725.70 FD R/R  
SW COR SEC 11

1991 WOODMAN VOL 6 PG 418 S89-13-40W 2725.50 TO NW COR  
SEC 14, S00-08-25E S 1/4 SEC 14

1991 WOODMAN #11918 & #11921FD 4" DIAMETER ALUM. MON.  
S89-13-40W 2725.50 TO NW COR SEC S00-08-25E 2658.07  
TO CEN SEC 14, S00-08-25E 5299.58 TO S 1/4 COR SEC 14

1991 BARNES J-19 & FB#3 PG 26 FD ALUM MON. WITH HH ON  
EAST SIDE. PLACED CARSONITE POST ON WEST SIDE. HH  
ON EAST & NORTH SIDE. DID NOT SEARCH

SHEET 1 OF 3

CORNER CODE J-19(1)

*Donald Barnes*

*3-17-2009*

PO550 N1/4CORSEC14  
 FOR OTHER HH BECAUSE OF THE FROZEN GROUND. IN  
 HARMONY WITH RUGER' SURVEY. REFERENCED CORN. ON  
 WEST SIDE OF N/S FENCE & ABOUT 49' NORTH OF UP.  
 2001 LATHROP #7935 ALUM MON. SB9-13-40W 2725.50 TO PK @  
 NW COR SEC 14, S00-08-25E 5299.20 TO ALUM @ S 1/4  
 COR SEC 14.  
 2001 LATHROP #14107 FD ALUM. S00-08-25E 5269.53 TO S 1/4  
 COR SEC 14, SB9-13-40W 2725.75 TO NW COR SEC 14  
 2007 RIESOP CSM VOL 31 PG 12 FD ALUM. S00-04-29W 2653.72  
 TO SET REROD @ CENTER OF SEC 14, S00-04-29W 5377.88  
 TO FD ALUM. BASE @ S 1/4 COR SEC 14

I USED MY 1991 OBSERVATIONS TO THE FD ALUM. MON. WITH A HH  
 ON THE EAST.

C) Was the corner restored through acceptance of (1) an obliterated evidence location, or, (2) a found  
 perpetuated location?

DID NOT FIND A RECORD ABOUT THE ALUM. MON. IT IS IN HARMONY  
 WITH RUGER'S PLACEMENT OF STAKE SURROUNDED BY 3 H.H.  
 STONES & ON LINE & MIDWAY BETWEEN THE SW & SE CORNERS OF  
 SEC 11. ALSO IN HARMONY WITH CENTER OF SEC 11.

D) Describe any material discrepancy between the location of the corner as restored or reestablished  
 and the location of that corner as previously restored or reestablished by distance and direction. Show  
 the discrepancy on the plan view drawing under (a), above. Show the distances between the corner as  
 previously restored or reestablished and (1) the corner as restored or reestablished, and (2) to at least 4  
 of the witness monuments shown on the drawing in (a), above.

NONE

(E) Was the corner reestablished through lost corner proportionate methods? If so, show the method,  
 including the directions and distances to other public land survey corners used as evidence or used for  
 proportioning the corner location.

YES. IN 1886 RUGER DROVE A STAKE & SURROUNDED IT BY 3 H.H.  
 STONES. HE SHOWS THE CORNER ON LINE WITH SW AND SE  
 CORNERS OF SECTION 11 AND 2722.50 FEET FROM EACH.  
 USED CORNER TO SUBDIVIDE SECTION 11.

THE ALUM. MON IS ABOUT 0.34' SOUTH OF THE LINE BETWEEN THE  
 SE & SW CORNERS OF SEC 11 & ABOUT 1.13 EAST OF THE MID  
 POINT.

I, **Donald Barnes**, hereby certify that the corner location as identified by the corner code index  
 was determined by me under my direction and control and that this U.S. Public Land Survey  
 Monument Record is correct and complete to the best of my knowledge and belief.


Seal  
  
 Emboss

SHEET 2 OF 3

3-17-2009

CORNER CODE **J-19(1)**


A.E. 7.08 REQUIREMENT

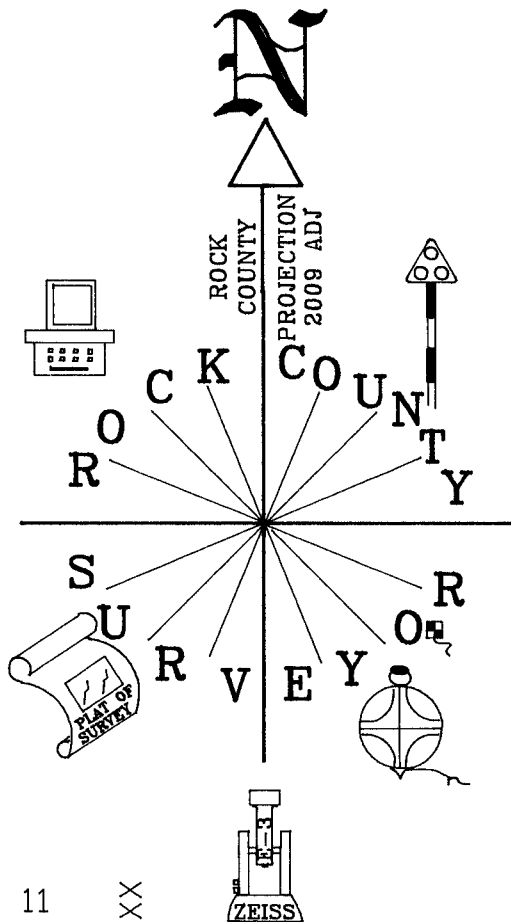

ROCK COUNTY PROJECTION 2009 ADJ

ROCK COUNTY

SURVEYOR

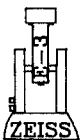

NOT TO SCALE

ELEV 818.5  
3/4X24 REROD

3/4X24 REROD  
ELEV 808.2

WOODS

FIELD WITH TREES

1'

FD. ALUM. MON.  
ELEV 814

3/4X24 REROD  
ELEV 815.5

3/4X24 REROD  
ELEV 807.2

N 1/4 COR  
SEC 14  
PORTER TWP  
T4N R11E

49

ELEV BASED ON ORTHO PHOTO  
FIELD BOOK #3 PG 26  
PLACED ORANGE CARSONITE  
POST

1991 BARNES J-19 SHEET 3 OF 3

EMBOSSSED  
SEAL

U.P.

J-19(1)

*Donald Barnes*  
3-17-2009