Paper weight-110# (minimum)

Black nonfading ink required

#### U.S. LAND PUBLIC SURVEY MONUMENT RECORD


For Public Land Survey Corners In:

WI ADMINISTRATIVE CODE A-E 7.08 REQUIREMENT

USMONREC.DWG REV 10/23/2004

T. 4 N. R. 11 E. 4th P.M.

CORNER CODE INDEX

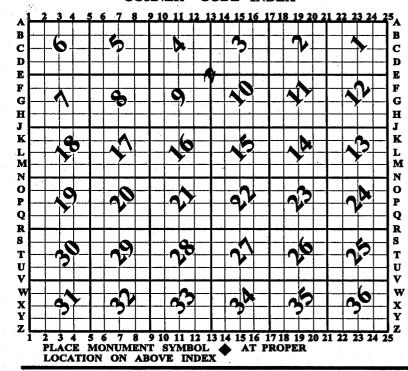

# **PORTER** TWP **ROCK COUNTY WI**

IF AVAILABLE ROCK COUNTY COORDINATES PERFERRED

North	Elev.
East	
Hor. Datum	Vert. Datum
LATITUDE _	ELLIPS. HT.
LONGITUDE	
NAD83(91)	NETWORK ADJ. YR
GPS (X)	TRAVERSE (X)
DACED ON TH	F FOLLOWING CONTROL.

**◆ CORNER MONUMENT** 

WITNESS MONUMENT  $\circ$ 

BEARINGS ARE BASED ON:

(a)

PAGE # A AND DEPTH.
2/2/1982

CORNER CODE E-/3() SHOW A PLAN VIEW DRAWING DEPICTING THE CORNER MONUMENT AND SURROUNDING PHYSICAL FEATURES, INCLUDING THE EXCAVATION AREA AND DEPTH. PLANNING & ZONING COMMITTEE ADOPTED THIS FORM ON 12/2/1982

#### SECORSEC4

(B) Describe any record evidence, monument evidence, occupational evidence, testimonial evidence or any other material evidence you considered, and whether the monument was found or placed.

HARRISON (NOV) TAN R11E 4TH MER. NORTH

BET.9 & 10

2640.0 QUARTER SEC COR. SET A POST & RAISED MOUND OF EARTH & SOD

3630.0 LEAVE PRAIRIE & ENTER TIMBER

3953.40 BURR OAK 12

5280.0 COR TO SECS 3,4,9,10 {BURR OAK 12 N50W 30.36'; BURR OAK 16 S60W 42.24'; BURR OAK 12 S34E 30.36'; BURR OAK 14 N55E 100.98' LAND 1 ST 1/2 MILE ROLLING PRAIRIE 2 ND 1/2 ROLLING 2<sup>ND</sup> RATE WITH ALL BURR DAK TIMBER

T4N R11E 4TH MER. EAST BET. SECS. 1833 HARRISON (NOV 2ND)

3 & 10

495.0 CREEK 19.8' CRS S.E. TEMPY 1/4 SEC COR 2640.0 CREEK 13.2' CRS N.E. 4290.0

INT. E BDY 33' NORTH OF POST 5247.0

LAND ROLLING 2ND RATE TIMBER ??? RED DAK, BRUBS, ?? OF WEEDS

WEST COR. WEST BET. 3 & 10

2623.5 QUARTER SEC. COR. {RED OAK 10 N?5?

65.34'; RED DAK 10 S7E 46.86' {RED DAK

10; RED OAK10}

5247.00 SEC COR

1833 HARRISON (OCT/NOV) T4N R11E 4TH MER. EAST BET. SECS. 4 & 9

TEMPY 1/4 SEC COR. 2640.0

CREEK 19.8' CREEK 19.8' CRS N.E. 2871.0

INT. E BDY 39.60' SOUTH OF POST LAND 5304.42 ROLLING 2ND RATE TIMBER ?? RED & BURR OAK ?? ??? ??? OF WEEDS

WEST COR WEST BET 4 & 9

2652.21 QUARTER SEC. COR. RED DAK 12 N41E 17.82; RED DAK 12 S69E 34.98'.

(NOV 3) HARRISON T4N R11E 4TH MER. NORTH BETWEEN 1833 SECS 3 & 4

> 825.0 CREEK CRS S.E.

1362.24 BURR DAK 12

2640.00 QUARTER SEC. COR. BURR OAK 12 S74W 45.54'; BURR DAK 12 S45E B5.B'. {BURR DAK 12; BURR DAK 12}

2772.0 **ENTER MARSH** 

INT. N. BDY 24.42' EAST OF POST IN MARSH 5214.00 {WILLOW 8 S60E 46.86'; ASPEN 6 S30W 47.52' LAND FOR THE 1<sup>ST</sup> ½ MILE SAME AS BEFORE 2ND 1/2 LEVE & WEST 3RD RATE BEING **MARSH** 

1833 (NOV) HARRISON ORIGINAL SURVEY. BUR OAK 12 N50W 30.26'; BURR DAK 16 S60W 42.24'; BUR DAK 12 S35E 30.36'; BUR DAK 14 N55E 100.98'

ROAD RECORDS. BOARD DIRECTED A ROAD TO BE MADE. 1856 BEGINNING AT THE N.W CORNER OF SECTION 3; THENCE SOUTH ON THE LINE BETWEEN SECTION & 9&10, 120 CHAINS TO THE 1/4 POST OF THE WEST LINE OF SECTION 10; THENCE EAST ON THE E&W 1/4 LINE OF SECTION 10, 20 CHAINS TO A POINT UNITING WITH A ROAD RUNNING N&S ON THE LINE DIVIDING THE E 1/2 FROM W 1/2 OF THE SW 1/4 OF SECTION 10 AND THE WHOLE LENGTH OF THE ROAD IS ONE AND 3/4 MILES AND THE ROAD IS 66' IN WIDTH.

ROAD RECORDS BK 1 PAGE 12. CALLS FOR 10,560 FROM 1858 THE NE CORNER OF SECTION 21.

SHEET # OF 4

CORNER CODE E-13(1)

Mind Baines 3/14/2009

### PO527 SECORSEC4

- 1858 PORTER TWP RD REC BK 1 PG 12 BEGINNING AT A POINT ON THE SECTION LINE BETWEEN SECTIONS 21 & 22 1438.80 SOUTH OF THE NE COR OF SEC 21 AT THE TERMINATION OF A ROAD CONTINUING SOUTH AND AT THE INTERSECTION OF A ROAD RUNNING NORTH WESTERLY THROUGH SECTIONS 21 & 22, THENCE NORTH ON THE SEC LINE BETWEEN SECTIONS 21 & 22, 15 & 16, 9 & 10, 11,998.8 TO THE NE COR OF SEC 9. ALSO BEGINNING AT THE NE COR OF THE WEST 1/2 OF THE NW 1/4 OF SEC 15; THENCE WEST ON THE SEC LINE BETWEEN SECTIONS 10 & 15, 9 & 16, 6,600 TO THE SW COR OF SEC 9 AND THE LINES ABOVE DESCRIBED ARE THE CENTER OF HIGHWAYS 66' WIDE AND WE THE SAID SUPERVISORS DO HEREBY DISCONTINUE THE PUBLIC HIGHWAY DISCRIBED AS FOLLOWS: BEGINNING AT THE SE COR OF THE W 1/4 OF SEC 22 AND RUNNING NORTH ON THE LINE OF EIGHTIES THROUGH SAID QUARTER SECTION AND THROUGH SEC 15 AND A PORTION OF SEC 10, UNTIL IT INTERSECTS THE ROAD RUNNING WEST FROM VAN TATTENS BRIDGE THROUGH SEC 10,
- 1858 ROAD RECORDS PAGE 12 BEGINNING AT A POINT ON THE NORTH LINE OF SECTION 9, AT THE INTERSECTIONS OF THE ABOVE NAMED ROAD WITH SAID LINE, THENCE EAST ON THE NORTH LINE OF SECTION 9, 1056' TO THE NE CORNER OF SECTION 9.
- STEBBINS PORTER RD REC BK 2 PG 6 BEGINNING AT THE SW COR OF SEC 3 T4N R11E; THENCE NORTH ON THE SEC LINE 660' TO A POINT NEAR BADFISH RIVER; THENCE N34 -1/2E 964.92' TO A STAKE ON POINT OF DRY LAND; THENCE N25E 158.4' TO STAKE; THENCE N2 1/2W 155.76' TO A STAKE; THENCE N53 1/2 W 386.1' TO SECTION LINE RUNNING NORTH ON SEC LINE 854.04' TO THE FOOT OF A HILL; THENCE N44 1/2E 200.64' TO STAKE; THENCE N63E 250.14' TO THE EAST & WEST LINE ON SEC 3; THENCE EAST ON THE 1/4 LINE 958.98' TO THE SE COR OF SW 1/4 OF NW 1/4 OF SEC 3; THENCE NORTH ON LINE OF EIGHTIES 2603.70' TO THE NORTH LINE OF SAID SEC 3; THE SAME BEING THE COUNTY LINE AND THE WHOLE LENGTH OF SAID ROAD IS ONE MILE 18 CHAINS AND 98 LINKS. COURSE GIVEN ACCORDING TO THE TRUE MERIDIAN VARIATION OF NEEDLE 8. THE LINE OF SAID SURVEY TO BE THE CENTER OF SAID HIGHWAY AND THE SAME IS ESTABLISHED 66' IN WIDTH. H. STEBBINS, SURVEYOR
- 1934 WIDOT STH 59 #3897 SHOWS CORNER BUT DID NOT USE IT OR STATE ANYTHING ABOUT IT.
- 1950 WIDOT STH 59 #11851 SHOWS CORNER BUT DID NOT USE IT OR STATE ANYTHING ABOUT IT.
- 1967 BATTERMAN JR. VOL 4 PG 323 DUG LARGE HOLE AND FOUND NOTHING.
- 1993 SCHROEDER #10051 STATES NOTHING ABOUT MON. N89-50-08E TO S 1/4 COR SEC 4
- 1993 BARNES E-13 INSTALLED ALUMINUM MONUMENT.
  SEPTEMBER 11, 1993 SINCE BATTERMAN (1967) DUG A
  LARGE HOLE I DID NOT EXCAVATE FOR THE CORNER. I
  RESTORED THE CORNER THROUGH ACCEPTANCE OF
  OBLITERATED EVIDENCE LOCATION. THE ROAD RECORDS
  CALL FOR THE SECTION LINE AS THE CENTER OF THE R/W. I
  USED THE CENTER OF THE PAVEMENT TO CONTROL THE E/W
  LOCATION. THE 1958 AIR PHOTOS SHOW A ROAD GOING TO
  THE WEST. THE PRESENT E/W FENCE LINE AND LARGE OAK
  TREE TO THE NORTH INDICATES THAT THE ROAD WAS A 3
  ROD ROAD. I USED THE CENTER OF THIS TO CONTROL THE
  N/S DIRECTION. THE DISTANCE TO THE E 1/4 CORNER OF

CORNER CODE E-13(1)

Nordd Baines 3/14/2009

- PÒ527 SECORSEC4

  SECTION 4 (2670.64) IS IN HARMONY WITH THE DISTANCES

  OF THE EAST LINE OF THE NE 1/4 OF SECTION 3 (2669.35),

  WEST LINE OF THE SW 1/4 OF SECTION 4 (2671.61) AND THE

  EAST LINE OF THE NW 1/4 OF SECTION 9 (2669.22).
- 1995 LATHROP #9359 ALUM. MON. NOO-45-20W 2670.77 TO ALUM @ E 1/4 COR SEC 4, WEST 2647.74 TO ALUM @ S 1/4 COR SEC 4.
- 1999 NORTHROP #7419 NOO-55-46W 2670.64 TO ALUM @ E 1/4 COR SEC 4, S89-50-08W 2647.76 TO ALUM MON @ S 1/4 COR SEC 4.
- 2004 BAKER #14776 FD ALUM. NOO-55-46W 2670.64 TO ALUM MON @ E 1/4 COR SEC 4, S89-50-08W 2647.76 TO ALUM @ S 1/4 COR SEC 4
- 2008 SANDSNES MAP # FD ROCK COUNTY ALUM. MON.
  REPRESENTING THE SE COR OF SEC 4, S89-50-08W 2647.76
  TO ALUM @ S 1/4 COR SEC 4, & NO-55-46W 2670.64 TO FD
  ALUM REPRESENTING THE E 1/4 COR SEC 4.

## I USED MY 1993 OBSERVATIONS.

C) Was the corner restored through acceptance of (1) an obliterated evidence location, or, (2) a found perpetuated location?

ACCEPTED ALUM. MON. OF RECORD.

13/14/2009

D) Describe any material discrepancy between the location of the corner as restored or reestablished and the location of that corner as previously restored or reestablished by distance and direction. Show the discrepancy on the plan view drawing under (a), above. Show the distances between the corner as previously restored or reestablished and (1) the corner as restored or reestablished, and (2) to at least 4 of the witness monuments shown on the drawing in (a), above.

NO

(E) Was the corner reestablished through lost corner proportionate methods? If so, show the method, including the directions and distances to other public land survey corners used as evidence or used for proportioning the corner location.

I, **Donald Barnes**, hereby certify that the corner location as identified by the corner code index was determined by me under my direction and control and that this U.S. Public Land Survey Monument Record is correct and complete to the best of my knowledge and belief.

SHEET 3 OF 4

CORNER CODE E-13(1)

A.E. 7.08 REQUIREMENT

