

U.S. PUBLIC LAND SURVEY MONUMENT RECORD


For Public Land Survey Corners in the
T. 2 N., R. 13 E.

CORNER CODE INDEX

	1	2	3	4	5	6	7	8	9	10	11	12	13	14	15	16	17	18	19	20	21	22	23	24	25
A																									
B																									
C	6			5	4																				
D																									
E																									
F																									
G	7			8	9																				
H																									
I																									
J																									
K																									
L	18			17	16																				
M																									
N																									
O																									
P	19			20	21																				
Q																									
R																									
S																									
T	30			29	28																				
U																									
V																									
W																									
X	31			32	33																				
Y																									
Z																									

PLACE MONUMENT SYMBOL (◆) AT PROPER LOCATION ON ABOVE INDEX

EXAMPLE

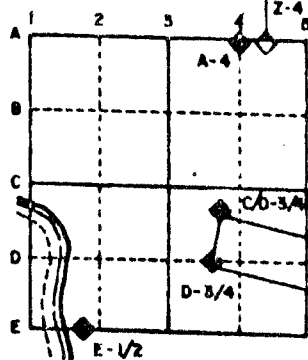

LA PRAIRIE TWP
ROCK COUNTY WI

IF AVAILABLE
STATE PLANE COORDINATES

North (Y) _____ Eleve. (Z) _____
 East (X) _____ Zone _____
 Hor. Datum _____ Vert. Datum _____

(c)

◆ CORNER MONUMENT

○ WITNESS MONUMENT

REFERENCED FOR ROAD CONSTRUCTION



"X" IN SW BOLT OF R/R SIGNAL

C.T.H.
J

R/R

"X" IN SW BOLT OF R/R SIGNAL

PK IN SOUTH FACE OF POWER POLE

58.36
REC 58.40

DRIVEWAY
FD ALUM. MON.

DRIVEWAY

FIELD BOOK #3 PG 57

PK NAIL NORTH FACE OF POWER POLE

SHEET _____ OF _____

CORNER CODE: C 9(2)

BEARINGS ARE BASED ON:



REC 103.37
103.37
103.37
103.37

REC 64.86
64.86
64.74