

U.S. PUBLIC LAND SURVEY MONUMENT RECORD

For Public Land Survey Corners In:
T. 2 N. R. 13 E. 4th P.M.

WI ADMINISTRATIVE CODE A-E 7.08 REQUIREMENT
REV 10/23/2004 USMONREC.DWG

CORNER CODE INDEX

LA PRAIRIE TWP
ROCK COUNTY WI

IF AVAILABLE
ROCK COUNTY COORDINATES PREFERRED

A	1	2	3	4	5	6	7	8	9	10	11	12	13	14	15	16	17	18	19	20	21	22	23	24	25	A
B		6																								B
C			5																							C
D				4																						D
E					3																					E
F						2																				F
G							1																			G
H																										H
J																										J
K																										K
L																										L
M																										M
N																										N
O																										O
P																										P
Q																										Q
R																										R
S																										S
T																										T
U																										U
V																										V
W																										W
X																										X
Y																										Y
Z																										Z

North _____ Elev. _____
 East _____
 Hor. Datum _____ Vert. Datum _____
 LATITUDE _____ ELLIPS. HT. _____
 LONGITUDE _____
 NAD83(91) _____ NETWORK ADJ. YR _____
 GPS (X) _____ TRAVERSE (X) _____
 BASED ON THE FOLLOWING CONTROL:

PLACE MONUMENT SYMBOL AT PROPER LOCATION ON ABOVE INDEX

CORNER MONUMENT WITNESS MONUMENT

BEARINGS ARE BASED ON: _____

FIELD BOOK _____ PAGE # _____ SHEET 1 OF 3
SHOW A PLAN VIEW DRAWING DEPICTING THE CORNER MONUMENT AND SURROUNDING PHYSICAL FEATURES, INCLUDING THE EXCAVATION AREA AND DEPTH.

PLANNING & ZONING COMMITTEE ADOPTED THIS FORM ON 12/2/1982

CORNER CODE J-9(2)

LA545

(B) Describe any record evidence, monument evidence, occupational evidence, testimonial evidence or any other material evidence you considered, and whether the monument was found or placed.

1939 SUNNY VOL 3 PG 448 FD 6X6 STONE MON. SET 1 1/2XB
PIPE ON TOP. REFERENCED TO TREES & UP.

1970 BATTERMAN VOL 4 PG 453 FD 2" PIPE OVER CUT STONE. SET
CONC. MON. UNDER MON. BOX. REFERENCED SAME

1985 BARNES J-9 & FB #2 PG 14 FD MON. BOX 0.3' DEEP. INSIDE
BOX FOUND DISK LAYING WITH PIECES OF CONCRETE. SET
12" ALUM. MON. ON TOP OF REMAINS OF CONC. MON. &
REFERENCED SAME.

1990 BARNES J-9(1) & FB# 3 PG 56 FD ALUM., REMOVED CAP, &
REFERENCED SAME. GTH "J" WILL BE REPAVED IN 1990.

PAVEMENT WAS GROUND IN JULY 2006 AND REPAVED IN
SEPTEMBER. PRIOR TO GRINDING, I FOUND A PK & REFERENCED
SAME.

AFTER REPAVING I SET STEEL SURVEY NAIL IN THE PVMT SURFACE.

MONUMENT BOX, CONCRETE MON/DISK, & LIMESTONE ARE STILL
BELOW THE PVMT SURFACE.

C) Was the corner restored through acceptance of (1) an obliterated evidence location, or, (2) a found perpetuated location?

THE STEEL SURVEY NAIL IS IN HARMONY WITH THE FD REFERENCE
PIPES & FD PK.

D) Describe any material discrepancy between the location of the corner as restored or reestablished and the location of that corner as previously restored or reestablished by distance and direction. Show the discrepancy on the plan view drawing under (a), above. Show the distances between the corner as previously restored or reestablished and (1) the corner as restored or reestablished, and (2) to at least 4 of the witness monuments shown on the drawing in (a), above.

NO

(E) Was the corner reestablished through lost corner proportionate methods? If so, show the method, including the directions and distances to other public land survey corners used as evidence or used for proportioning the corner location.

NO

I, **Donald Barnes**, hereby certify that the corner location as identified by the corner code index was determined by me under my direction and control and that this U.S. Public Land Survey Monument Record is correct and complete to the best of my knowledge and belief.

Seal


Emboss

OCT 3 2006

SHEET 1 OF 3


CORNER CODE

J-9(2)

A.E. 7.08 REQUIREMENT

DuraNail



Exclusively From Berntsen

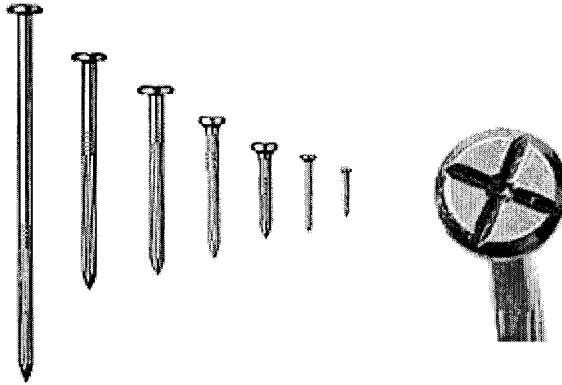

DuraNail

This steel nail will not bend or break and will drive into the asphalt with ease. Not like other nails, it has a deep cross on its larger head along with a center punch. This magnetic nail comes in a variety of lengths. You will receive The Magnetizer with each bag of nails, which will realign the magnetic field after installation to make your DuraNail more detectable

Steel Nail Markers

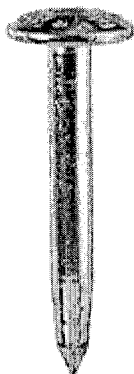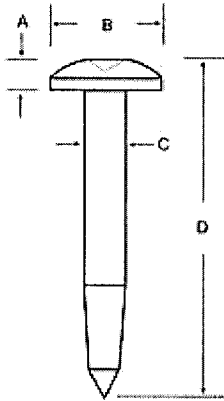


A = 3/16" (5 mm)
B = 1" (25 mm)
C = 11/32" (9 mm)
D = 3" (76 mm)

The Steel Nail Marker is super strong solid steel and drives easily into blacktop. "SURVEY MARK" is imprinted on top of nail for easy identification as a survey mark. The SNM1 has a 1" (25mm) convex top and conical recessed center chamfer for pinpoint accuracy.


Donald Barnes

OCT 3 2006

J-9(2)

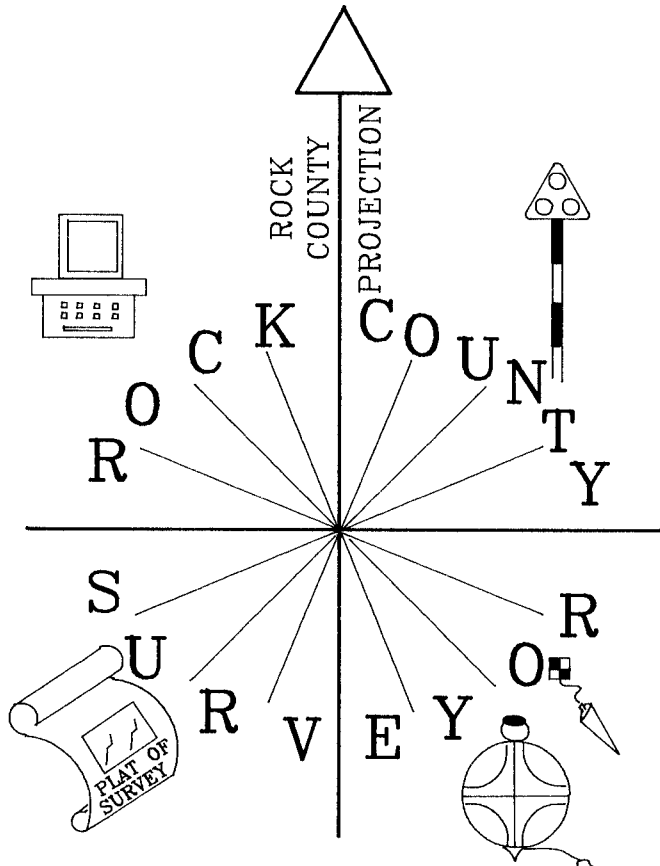

PVMT GROUND IN JULY 2006
& REPAVED IN SEP 2006

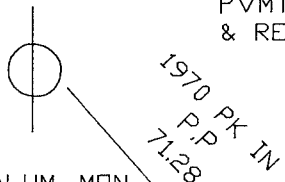

1990 FD ALUM. MON.
REMOVED CAP

1984 FD MON. BOX 0.3' DEEP &
INSIDE FD BRASS DOT DISK
LAYING IN PIECES OF CON.
SET 12" ALUM MON IN BOX

1970 FD 2" PIPE OVER
CUT STONE. SET CONC.
MON. UNDER MON. BOX

NOT TO SCALE

C.T.H. "J"

1984 SET PIPE
FD PIPE
ELEV 97.93

1990 S71-16-25E 57.58
PK N72-14-58W 57.58

1990 S35-54-16E 41.21
PK S34-54-19E 41.14
1984 S34-54-19E 41.16
1984 S34-54-19E 41.38

SPIKE S63-45-28E 34.54
PK N63-48-17E 34.54
1990 S62-38-23W 34.54
1984 S62-38-23W 34.54

1984 SET PIPE
FD PIPE

FD PIPE
ELEV 98.72
1984 SET PIPE

XXXXXXXXXXXXXXXXXXXXXXXXXXXXXXXXXXXX

1984 SET PIPE
FD PIPE
ELEV 98.28

1984	68.63
1990 S89-43-36W	68.71
PK S89-23-25E	68.70
SPIKE N89-21-25E	68.69

ASSUMED VERTICAL DATUM

FB #3 PG 56
FB#2 PG 14
VOL 4 PG 453

OBSERVATION SHEETS 545 & 1545

NE COR
SEC 17
LA PRAIRIE TWP
T2N R13E

1990 S73-54-10E
S71-33-04E
1984 S51-44-04E 38.16
PK S50-27-54E 38.16
1970 S50-31-41E 38.18
1970 PK IN
100.81 P.P.

1990 N1-00-18E 39.53
N2-11-13E 39.55

1984 SET PIPE
FD PIPE
ELEV 98.42

SHEET 3 OF 3

EMBOSSED SEAL

Donald Barnes
OCT 3 2006

J-9(2)