

# U.S. PUBLIC LAND SURVEY MONUMENT RECORD

For Public Land Survey Corners In:  
T. 2 N. R. 13 E. 4th P.M.  
CORNER CODE INDEX

WI ADMINISTRATIVE CODE A-E 7.08 REQUIREMENT  
REV 10/23/2004 USMONREC.DWG

LA PRAIRIE TWP

ROCK COUNTY WI

IF AVAILABLE  
ROCK COUNTY COORDINATES PREFERRED

A	1	2	3	4	5	6	7	8	9	10	11	12	13	14	15	16	17	18	19	20	21	22	23	24	25	A
B						6																				B
C							5																			C
D								4																		D
E									3																	E
F										2																F
G																										G
H																										H
J																										J
K																										K
L																										L
M																										M
N																										N
O																										O
P																										P
Q																										Q
R																										R
S																										S
T																										T
U																										U
V																										V
W																										W
X																										X
Y																										Y
Z																										Z

North \_\_\_\_\_ Elev. \_\_\_\_\_

East \_\_\_\_\_

Hor. Datum \_\_\_\_\_ Vert. Datum \_\_\_\_\_

LATITUDE \_\_\_\_\_ ELLIPS. HT. \_\_\_\_\_

LONGITUDE \_\_\_\_\_

NAD83(91) \_\_\_\_\_ NETWORK ADJ. YR \_\_\_\_\_

GPS (X) \_\_\_\_\_ TRAVERSE (X) \_\_\_\_\_

BASED ON THE FOLLOWING CONTROL:

PLACE MONUMENT SYMBOL  AT PROPER LOCATION ON ABOVE INDEX

CORNER MONUMENT

WITNESS MONUMENT

BEARINGS ARE BASED ON: \_\_\_\_\_

FIELD BOOK \_\_\_\_\_ PAGE # \_\_\_\_\_

SHEET 1 OF 3

SHOW A PLAN VIEW DRAWING DEPICTING THE CORNER MONUMENT AND SURROUNDING PHYSICAL FEATURES, INCLUDING THE EXCAVATION AREA AND DEPTH.

PLANNING & ZONING COMMITTEE ADOPTED THIS FORM ON 12/2/1982

CORNER CODE L-9(2)

LA556

(B) Describe any record evidence, monument evidence, occupational evidence, testimonial evidence or any other material evidence you considered, and whether the monument was found or placed.

1939 SUNNY VOL 3 PG 449 FD 6X6 STONE MON. SET 1 1/2X10  
GAPPED PIPE ON TOP. REFERENCED TO TREES & UP.

1963 BATTERMAN VOL 4 PG 162 REFERENCED CORNER BUT  
STATES NOTHING ABOUT MONUMENT.

1985 BARNES L-9 & FB #2 PG 14, & 64 FD MON. BOX WITH  
DOT CONCRETE MON WITH BRASS DISK WITH CUT "X" @  
CENTER OF PAVEMENT. REFERENCED SAME.

1990 BARNES L-9(1) & FB#3 PG 56 FD CONCRETE MON/BRASS CAP  
IN MON. BOX. REFERENCED SAME. CTH "J" WILL BE REPAVED  
IN 1990.

PAVEMENT WAS GROUND IN JULY 2006 AND REPAVED IN  
SEPTEMBER 2006. AFTER REPAVING I SET A DURA-NAIL IN THE  
PVMT SURFACE. I SEARCHED FOR ALL REFERENCE MONUMENTS OF  
RECORD.

MONUMENT BOX, CONCRETE MON/DISK, & LIMESTONE ARE STILL  
BELOW THE PVMT SURFACE.

C) Was the corner restored through acceptance of (1) an obliterated evidence location, or, (2) a found  
perpetuated location?

THE DURA-NAIL IS IN HARMONY WITH THE FD REFERENCE PIPES.

D) Describe any material discrepancy between the location of the corner as restored or reestablished  
and the location of that corner as previously restored or reestablished by distance and direction. Show  
the discrepancy on the plan view drawing under (a), above. Show the distances between the corner as  
previously restored or reestablished and (1) the corner as restored or reestablished, and (2) to at least 4  
of the witness monuments shown on the drawing in (a), above.


NO

(E) Was the corner reestablished through lost corner proportionate methods? If so, show the method,  
including the directions and distances to other public land survey corners used as evidence or used for  
proportioning the corner location.

NO

I, **Donald Barnes**, hereby certify that the corner location as identified by the corner code index  
was determined by me under my direction and control and that this U.S. Public Land Survey  
Monument Record is correct and complete to the best of my knowledge and belief.

Seal

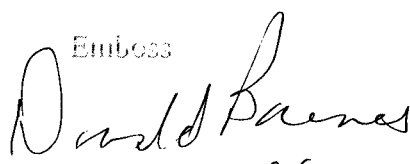Emboss  
  
OCT 3, 2006

SHEET 1 OF 3

CORNER CODE

**L-9(2)**

A.E. 7.08 REQUIREMENT

# U.S. PUBLIC LAND SURVEY MONUMENT RECORD

For Public Land Survey Corners In:  
T. 2N. R. 13E. 4th P.M.  
CORNER CODE INDEX

WI ADMINISTRATIVE CODE A-E 7.08 REQUIREMENT  
REV 10/23/2004 USMONREC.DWG

A	1	2	3	4	5	6	7	8	9	10	11	12	13	14	15	16	17	18	19	20	21	22	23	24	25	A
B																										B
C	6																									C
D		5																								D
E			4																							E
F				3																						F
G					2																					G
H						1																				H
I																										I
J	7																									J
K		8																								K
L			9																							L
M				10																						M
N					11																					N
O						12																				O
P							13																			P
Q								14																		Q
R									15																	R
S										16																S
T											17															T
U												18														U
V													19													V
W														20												W
X															21											X
Y																22										Y
Z																	23									Z
																		24								
																			25							

PLACE MONUMENT SYMBOL  AT PROPER LOCATION ON ABOVE INDEX

LA PRAIRIE TWP  
ROCK COUNTY WI

IF AVAILABLE  
ROCK COUNTY COORDINATES PERFERRED

North \_\_\_\_\_ Elev. \_\_\_\_\_

East \_\_\_\_\_

Hor. Datum \_\_\_\_\_ Vert. Datum \_\_\_\_\_

LATITUDE \_\_\_\_\_ ELLIPS. HT. \_\_\_\_\_

LONGITUDE \_\_\_\_\_

NAD83(91) \_\_\_\_\_ NETWORK ADJ. YR \_\_\_\_\_

GPS (X) \_\_\_\_\_ TRAVERSE (X) \_\_\_\_\_

BASED ON THE FOLLOWING CONTROL:

CORNER MONUMENT       WITNESS MONUMENT

BEARINGS ARE BASED ON:

IN 1990 CTH "J" WAS REPAVED. IN JULY 2006 THE ASPHALT SURFACE ON CTH "J" WAS REMOVED BY A GRINDING PROCESS AND IN SEPTEMBER IT WAS RESURFACED WITH ASPHALT. I PLACED EITHER A 3" STEEL SURVEY MARKER SPIKE OR A 3" DURANAIL. THE MONUMENTS OF RECORD ARE STILL BELOW THE PAVMENT.

FIELD BOOK \_\_\_\_\_ PAGE # \_\_\_\_\_ SHEET 2 OF 3


SHOW A PLAN VIEW DRAWING DEPICTING THE CORNER MONUMENT AND SURROUNDING PHYSICAL FEATURES, INCLUDING THE EXCAVATION AREA AND DEPTH.

PLANNING & ZONING COMMITTEE ADOPTED THIS FORM ON 12/2/1982

CORNER CODE L-9 (2)

# DuraNail



Exclusively From Berntsen

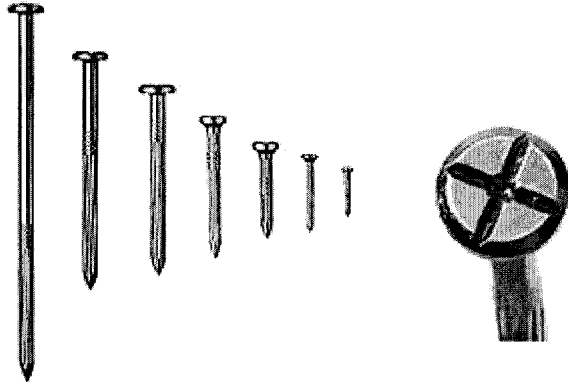

## DuraNail

This steel nail will not bend or break and will drive into the asphalt with ease. Not like other nails, it has a deep cross on its larger head along with a center punch. This magnetic nail comes in a variety of lengths. You will receive The Magnetizer with each bag of nails, which will realign the magnetic field after installation to make your DuraNail more detectable

## Steel Nail Markers

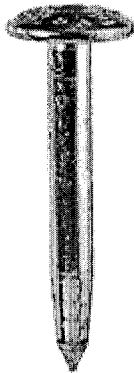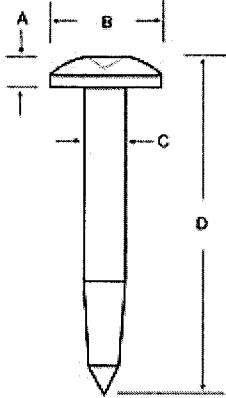

A = 3/16" (5 mm)  
B = 1" (25 mm)  
C = 11/32" (9 mm)  
D = 3" (76 mm)

The Steel Nail Marker is super strong solid steel and drives easily into blacktop. "SURVEY MARK" is imprinted on top of nail for easy identification as a survey mark. The SNM1 has a 1" (25mm) convex top and conical recessed center chamfer for pinpoint accuracy.

Oct 3, 2006  
Duro! Barnes

2 of 2  
L-9(2)

SEARCHED & FOUND NOTHING FOR THE FOLLOWING  
 BOLT 53.48 FROM SEC COR  
 PIPE 53.12 FROM SEC COR  
 PIPE 61.22 FROM SEC COR  
 BOLT 63.25 IS UNDER PVMT  
 PIPE 38.90 FD NOTHING BUT FD  
 GROUND PIN N38-07-22E  
 39.83 FROM SEC COR.


PROBABLY DESTROYED  
 1957 FED DISK  
 IN CONC.  
 R.M. #1

1990 SET 3/4X24  
 REROD /PLASTIC CAP


DID NOT FIND POSITION IN CULTIVATED FIELD  
 1957 FED DISK IN CONC.  
 RM #2

E 1/4 COR  
 SEC 17  
 LA PRAIRIE TWP  
 T2N R13E

AVALON RD

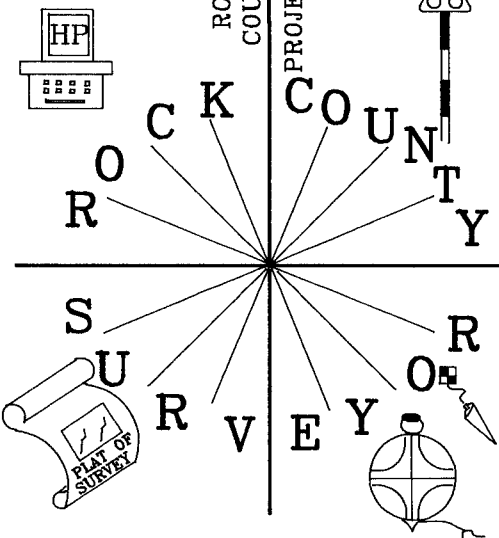

PVMT GROUND IN JULY 2006 & REPAVED IN SEP 2006

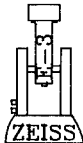

OBSERVATION SHEETS 556, 400, & 890

*Donald Barnes*  
 Oct 3, 2006

1990 FB #3 PG 56  
 1984 FB #2 PG 14  
 1978 VOL 5 PG 518 HURD COORDINATES  
 1963 VOL 4 PG 162 TIES, STATES NOTHING ABOUT MON

SHEET 3 OF 3

L-9(2)

1957 30'  
 FD FED DISK  
 IN CONC.  
 WITH CARSONITE POST

ELEV 100.75  
 FD FED DISK #4  
 IN CONC. 51.3

1984 FOUND BRASS DISK &  
 1990 FOUND BRASS DISK  
 IN CONCRETE MONUMENT INSIDE  
 MONUMENT BOX

1985 TWP PROJ.  
 FD BENT REROD  
 REPLACED WITH  
 3/4X24 REROD  
 ELEV 99.97  
 1990 SET 3/4X24  
 REROD/PLASTIC CAP  
 FD REROD/CAP  
 ELEV 100.9'

1990 SET 3/4X24  
 REROD/PLASTIC CAP  
 FD REROD/CAP ELEV 99.99

