

Paper weight-110# (minimum)

Black nonfading ink required

U.S. PUBLIC LAND SURVEY MONUMENT RECORD

For Public Land Survey Corners In:

WI ADMINISTRATIVE CODE A-E 7.08 REQUIREMENT

T. 4 N. R. 11 E. 4th P.M.

REV 10/23/2004

USMONREC.DWG

CORNER CODE INDEX

PORTER TWP

ROCK COUNTY WI

IF AVAILABLE

ROCK COUNTY COORDINATES PREFERRED

	2	3	4	5	6	7	8	9	10	11	12	13	14	15	16	17	18	19	20	21	22	23	24	25	
A																									
B																									
C	6																								
D																									
E																									
F																									
G	7																								
H																									
J																									
K	18																								
L																									
M																									
N																									
O																									
P	19																								
Q																									
R																									
S																									
T																									
U																									
V																									
W																									
X																									
Y																									
Z																									
	1	2	3	4	5	6	7	8	9	10	11	12	13	14	15	16	17	18	19	20	21	22	23	24	25

North _____ Elev. _____

East _____

Hor. Datum _____ Vert. Datum _____

LATITUDE _____ ELLIPS. HT. _____

LONGITUDE _____

NAD83(91) _____ NETWORK ADJ. YR _____

GPS (X) _____ TRAVERSE (X) _____

BASED ON THE FOLLOWING CONTROL:

PLACE MONUMENT SYMBOL AT PROPER LOCATION ON ABOVE INDEX

CORNER MONUMENT

WITNESS MONUMENT

BEARINGS ARE BASED ON: County 2007 ADJ

FIELD BOOK _____ PAGE # _____

SHEET 1 OF 2

SHOW A PLAN VIEW DRAWING DEPICTING THE CORNER MONUMENT AND SURROUNDING PHYSICAL FEATURES, INCLUDING THE EXCAVATION AREA AND DEPTH.

PLANNING & ZONING COMMITTEE ADOPTED THIS FORM ON 12/2/1982

CORNER CODE T-8

PO2595 S1/16THCOR-NE1/4SEC29

(B) Describe any record evidence, monument evidence, occupational evidence, testimonial evidence or any other material evidence you considered, and whether the monument was found or placed.

**1871 RUGER VOL 2 PG 68 SET STAKE DEEP SURROUNDED BY 4
HH & LIMESTONE ON TOP OF STAKE. VAR 7-28 1330.89 TO
E1/4 COR SEC 29 & GEN SEC 29.**

1973 LEE VOL 4 PG 596 DUG & FD 2 HH 2' DEEP & REF SAME

**1979 BARNES VOL 5 PG 567 FB #2 PG 1-3 FD PK 0.1' DEEP & 2'
NORTH OF CENTER OF PVMT. ALSO FD NE REFERENCE 7.99
(REC 8.00) PK 0.1' DEEP. FD NW & SE REFERENCE
PIPE. ACCEPTED FD PK & REFERENCE MONUMENTS. SET
BOLT.**

**FD BOLT 0.1 DEEP & SW, SW, & SE REFERENCE PIPES. BOLT IS
0.57' SOUTH OF LINE BETWEEN W & E 1/4 CORNERS. BOLT IS 2.7'
SOUTH OF NORTH PVMT EDGE.**

C) Was the corner restored through acceptance of (1) an obliterated evidence location, or, (2) a found perpetuated location?

ACCEPTED FD BOLT.

D) Describe any material discrepancy between the location of the corner as restored or reestablished and the location of that corner as previously restored or reestablished by distance and direction. Show the discrepancy on the plan view drawing under (a), above. Show the distances between the corner as previously restored or reestablished and (1) the corner as restored or reestablished, and (2) to at least 4 of the witness monuments shown on the drawing in (a), above.

(E) Was the corner reestablished through lost corner proportionate methods? If so, show the method, including the directions and distances to other public land survey corners used as evidence or used for proportioning the corner location.

I, DONALD BARNES, hereby certify that the corner location as identified by the corner code index was determined by me under my direction and control and that this U.S. Public Land Survey Monument Record is correct and complete to the best of my knowledge and belief.

Seal

Emboss

SHEET 1 OF 2

8-04-2009

CORNER CODE

T-8

A.E. 7.08 REQUIREMENT

1973 LEE VOL 4 PG 596
OBSERVATION SHEET #2595

S 1/16TH COR
NE 1/4
SEC 29
PORTER TWP
T4N R11E

29

XXXXXXXXXXXXXXXXXXXX

FIELD
ENT

PIPE WAS
DESTROYED

FD PIPE

LEE 32.57
S64-40-48E
32.45

S89-27-52W 3987.62

GIBBS LAKE RD

N89-25-53E 1332.05

FD BOLT
0.1 DEEP

M19-49-10E 57.54
LEE 57.54

N50-29-58E
LEE 63.30
63.41



S45-51-04E 57.22
LEE 57.83

LEE 67.67

FD PIPE

N89-44-29E 89.90
LEE 89.73

FD BENT
PIPE

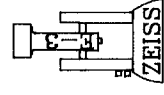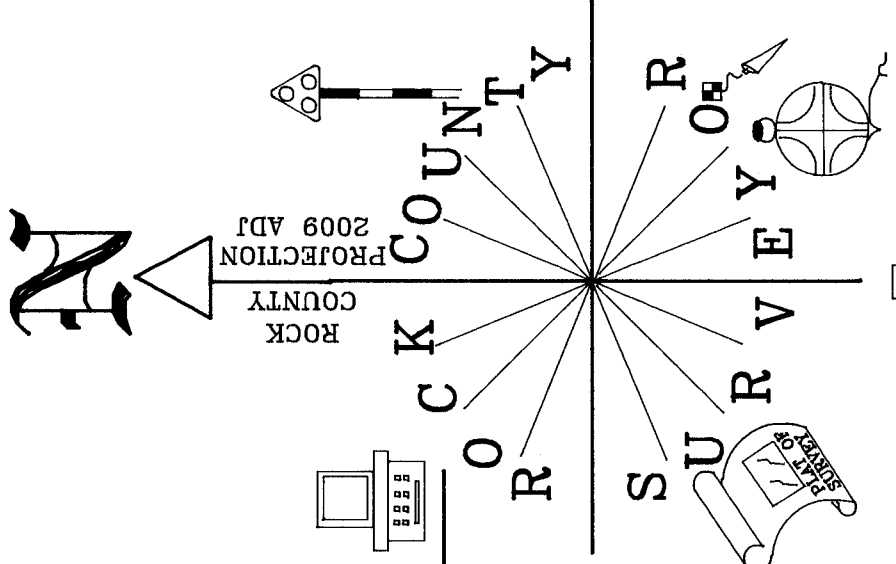

NOT TO SCALE

8-04-2009
EMBOSSED
SEAL
Rand Kause

SHEET 2 OF 2

T-8