Paper weight-110# (minimum)

Black nonfading ink required

U.S. PUBLIC LAND SURVEY MONUMENT RECORD


For Public Land Survey Corners In:

WI ADMINISTRATIVE CODE A-E 7.08 REQUIREMENT

REV 10/23/2004 USMONREC.DWG

T. 4 N. R. 11 E. 4th P.M.

CORNER CODE INDEX

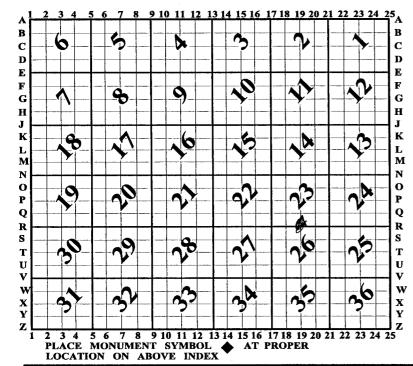

PORTER TWP

IF AVAILABLE
ROCK COUNTY COORDINATES PERFERRED

North	Elev.
East	
Hor. Datum	Vert. Datum
LATITUDE _	ELLIPS. HT.
LONGITUDE _	
NAD83(91)	NETWORK ADJ. YR
GPS (X)	TRAVERSE (X)
BASED ON THI	E FOLLOWING CONTROL:

♦ CORNER MONUMENT

WITNESS MONUMENT

BEARINGS ARE BASED ON: ______

(a)

FIELD BOOK _____ PAGE # ____ OF ___ SHEET ___ OF SHOW A PLAN VIEW DRAWING DEPICTING THE CORNER MONUMENT AND SURROUNDING PHYSICAL FEATURES, INCLUDING THE EXCAVATION AREA AND DEPTH.
PLANNING & ZONING COMMITTEE ADOPTED THIS FORM ON 12/2/1982

CORNER CODE

P0590

S1/4CORSEC23

(B) Describe any record evidence, monument evidence, occupational evidence, testimonial evidence or any other material evidence you considered, and whether the monument was found or placed.

1833 HARRISON (NOV 3RD) TAN R11E 4TH MER. EAST ON RAND. BET. 23 & 26

660.00 LEFT TIMBER & ENTER PRAIRIE

2640.0 TEMPY 1/4 SEC COR.

4224.0 TRAIL NORTH

5303.76 INT E BDY 7.92' SOUTH OF POST LAND ROLLING 1 $^{\rm ST}$ RATE PRAIRIE WITH GROWTH OF GRASS & WEEDS & SOME WIL INDIGO

WEST COR. WEST BET SEC 23 & 26

2651.88 SET A POST AND RAISED A MOUND OF EARTH & SOD FOR COR TO QUARTER SEC.

5297.16 SEC COR

- 1878 RUGER VOL 2 PG 242 FD REMAINS OF OLD STAKE SET LIMESTONE 36X10X4 VAR 6-30 1353.00 TO LIMESTONE 14X6X5 @ N 1/16TH COR OF NW 1/4 SEC 26, 2706.00 TO NW COR SEC 26, USED TO SUBDIVIDE SEC 26.
- 1961 BATTERMAN VOL 4 PG 94 DUG & FD REMAINS OF LIMESTONE 16X10X4. REFERENCED SAME. ON LINE WITH N/S FENCE LINE ON NORTH SIDE OF RD
- 1977 BARNES VOL 5 PG 249 FB # 1 PG 30 & 53 FD BROKEN R/R SPIKE & NE & SE REFERENCE MONUMENTS. NE REFERENCE PIPE WAS DISTURBED & I STRAIGHTENED SAME. ON LINE WITH N/S TREE ROW ON NORTH SIDE OF RD. REFERENCED SAME.
- 1977 BARNES VOL 5 PG 255 N1-05-21W 2664.51 TO CENTER OF SEC 23, N1-05-21E 5308.69 TO N 1/4 COR SEC 23, EAST 2713.64 TO SE COR SEC 23. VOL 6-398 STATES N1-05-21E 2664.51 TO CEN OF SEC 23 SHOULD BE N1-05-21E 2664.51
- 1977 BARNES VOL 5 PG 265 SET ALUM MON
- 1977 BARNES VOL 6 PG 398 N89-36-38E 2713.63 TO SE COR SEC 23, NO-42-08E 2664.62 TO CEN SEC 23. IN VOL 5 PG 255 THE BEARING FROM THE S 1/4 COR SEC 23 TO THE CENTER SHOULD BE N1-05-21E INSTEAD OF N1-05-21W. THE BEARINGS & DISTANCES SHOWN ARE BASED ON A NEW ASSUMED DATUM & THE ORIGINAL FIELD DATA WAS ADJUSTED BY LEAST SQUARES. S 1/4 COR SEC 23 TO SE COR SEC 23 IS N89-36-38E 2713.63, NO-42-08E 2664.62 TO CENTER OF SEC 23.
- 1979 BARNES VOL 5 PG 548 (KARNS) N89-33-59W 2704.31 (PRORATED)
- 1979 BARNES VOL 5 PG 553 @ N 1/16TH COR OF NW 1/4 OF SEC 26 DUG & FD NOTHING. SHOWS LIMITS OF EXCAVATION

FD ALUM. MON. DISTANCES TO THE REFERENCE MONUMENTS WERE SUCH THAT I THOUGHT THE CAP MAY HAVE BEEN BROKEN OFF AND I DUG ALONG THE SW SIDE OF THE MON. AND FOUND THE ALUM MON. WITH THE CAP STILL ATTACHED. ALUM MON WAS STRAIGHT AND NOT BROKEN. USING THE BEST FIT INTERSECTION FROM THE REFERENCE POINTS WOULD PLACE THE CORNER N19-36-40W 0.38' FROM THE ALUM. 4.5' SOUTH OF CENTER OF PVMT.

SHEET 1 OF 3

corner code R-19

Wrald Brees 3/19/2009

P 0590 S1/4CORSEC23

C) Was the corner restored through acceptance of (1) an obliterated evidence location, or, (2) a found perpetuated location?

ACCEPTED THE ALUM. MON. BECAUSE I PROBABLE FOUND THE FD THE REMAINS OF LIMESTONE 16X10X4 AND HELD THAT POSITION.

D) Describe any material discrepancy between the location of the corner as restored or reestablished and the location of that corner as previously restored or reestablished by distance and direction. Show the discrepancy on the plan view drawing under (a), above. Show the distances between the corner as previously restored or reestablished and (1) the corner as restored or reestablished, and (2) to at least 4 of the witness monuments shown on the drawing in (a), above.

NONE

(E) Was the corner reestablished through lost corner proportionate methods? If so, show the method, including the directions and distances to other public land survey corners used as evidence or used for proportioning the corner location.

ND

I, Donald Barnes, hereby certify that the corner location as identified by the corner code index was determined by me under my direction and control and that this U.S. Public Land Survey Monument Record is correct and complete to the best of my knowledge and belief.

SHEET LOF 3

CORNER CODE R-19

7.08 REQUIREMENT

