

U.S. PUBLIC LAND SURVEY MONUMENT RECORD

For Public Land Survey Corners in the


T. 4 N., R. 11 E.

CORNER CODE INDEX

	1	2	3	4	5	6	7	8	9	10	11	12	13	14	15	16	17	18	19	20	21	22	23	24	25
A																									
B																									
C	6																								
D																									
E	◆																								
F																									
G	7																								
H																									
I																									
J																									
K	8																								
L																									
M																									
N																									
O																									
P	9																								
Q																									
R																									
S																									
T	30																								
U																									
V																									
W																									
X																									
Y	31																								
Z																									

PLACE MONUMENT SYMBOL (◆) AT PROPER LOCATION ON ABOVE INDEX

EXAMPLE

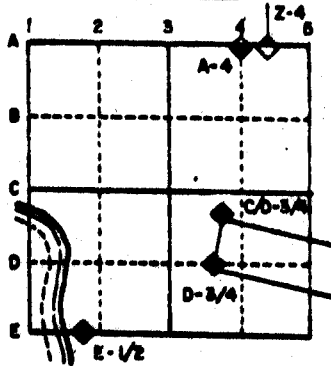

PORTER TWP
ROCK COUNTY WI


IF AVAILABLE STATE PLANE COORDINATES

North (Y) _____ Elev. (Z) _____
 East (X) _____ Zone _____
 Hor. Datum _____ Vert. Datum _____

a.)

◆ CORNER MONUMENT

○ WITNESS MONUMENT $\frac{1}{2}$ " X 2" ALUMINUM ROD

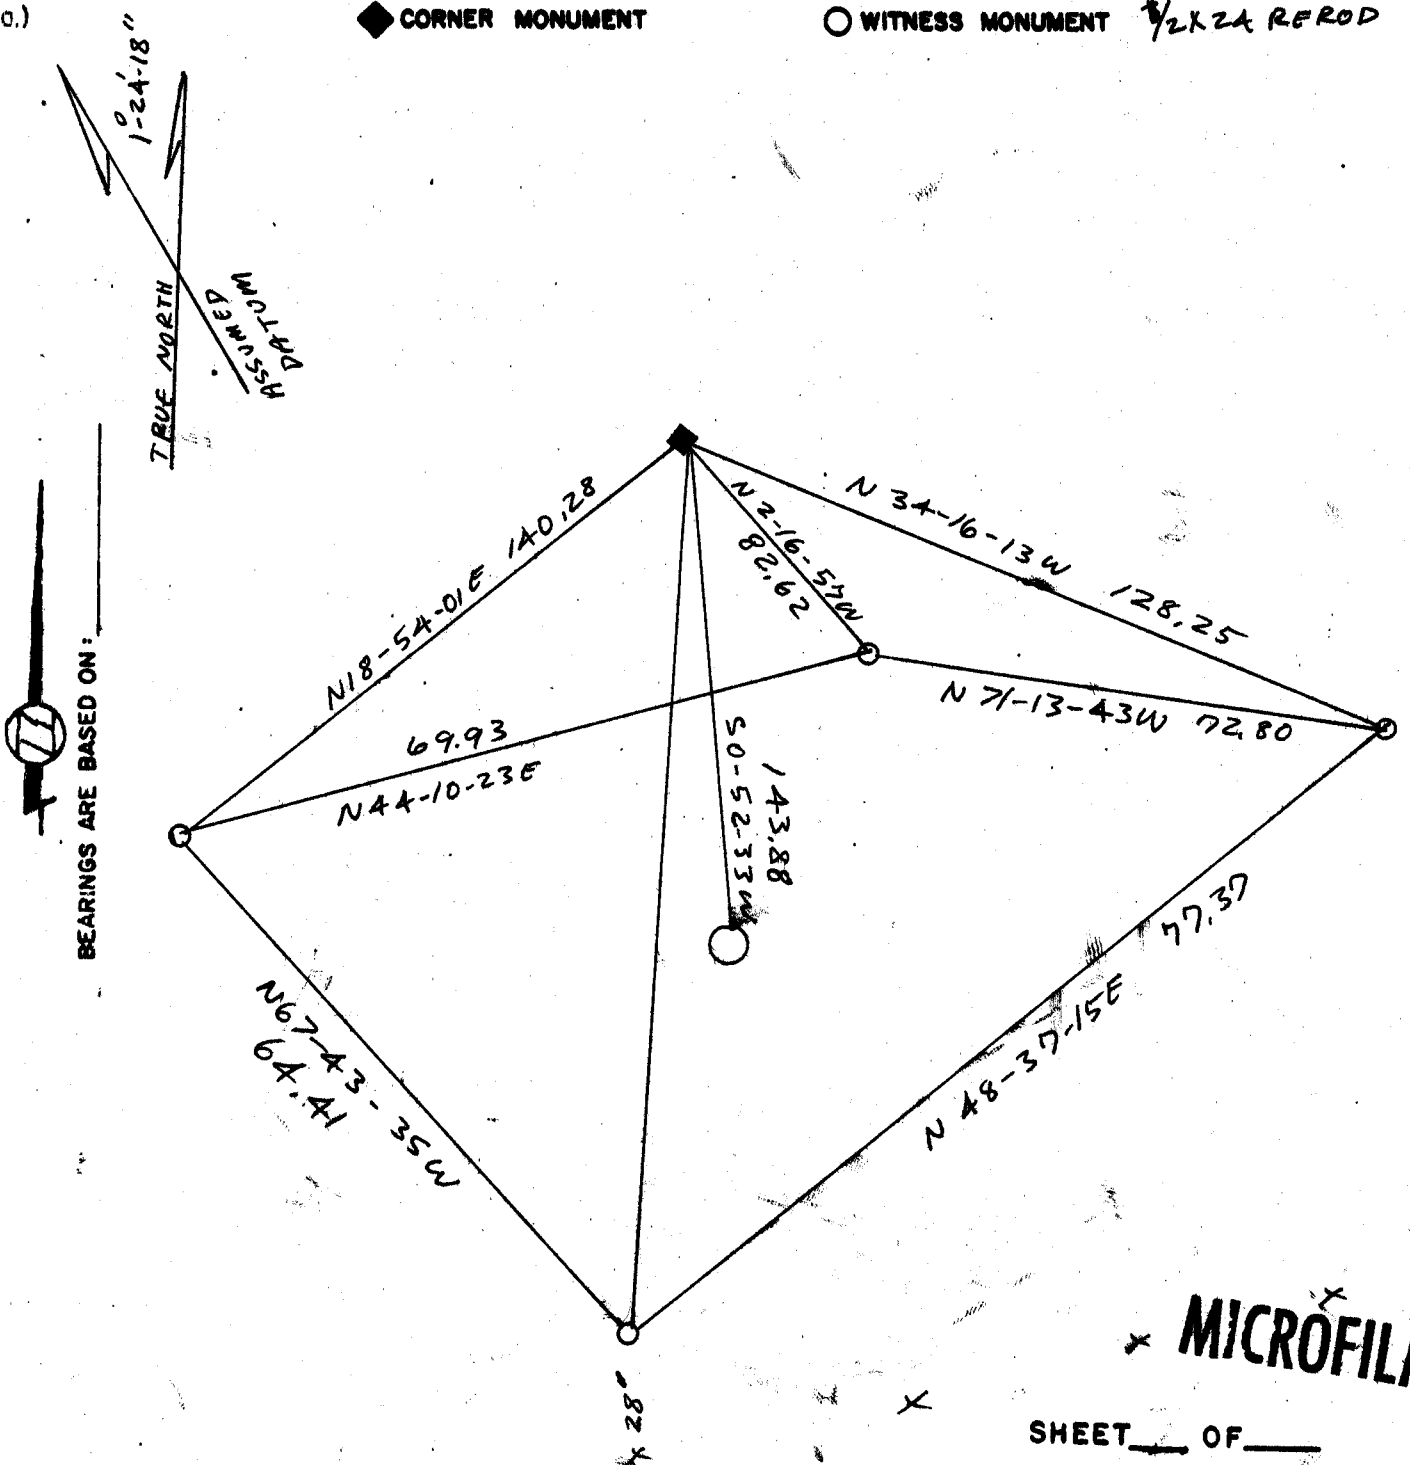

MICROFILMED

SHEET ___ OF ___

FIELD BK 3 PG 12

CORNER CODE: E 1

(B) Describe any record evidence, monument evidence, occupational evidence, testimonial evidence of any other material evidence you considered, and whether the monument was found or placed.

1833 ORIGINAL GOVERNMENT FIELD NOTES SHOWS A DISTANCE OF 143.88'.
1870 RUGER REMONUMENTATION FIELD NOTES. STATES THAT THE SE CORNER OF SECTION 1 IS LOST. HIS LINEN SHOWS A JOG DISTANCE OF 133.48 BETWEEN THAT CORNER AND THE SW CORNER OF SECTION 6.

1893 BLEEDORN VOL 2 PG 473 SHOWS THAT HE FOUND A MONUMENT AT THE SE CORNER OF SECTION 1, UNION TOWNSHIP AND HE ALSO FOUND A CORNER AT THE SW CORNER OF SECTION 6.

1933 SUNNY VOL 2 PG 473 HE FOUND A 6" X 6" CUT STONE AT THE SE CORNER OF SECTION 1, UNION TOWNSHIP. HE SHOWS A 143.88' JOG DISTANCE BETWEEN THE SE CORNER OF SECTION 1, UNION TOWNSHIP AND THE SW CORNER OF SECTION 6, PORTER TOWNSHIP BUT STATES NOTHING ABOUT THE SW CORNER. SHOWS A DISTANCE ALONG THE SOUTH LINE OF SECTION 6 PORTER TOWNSHIP.

DUG AND FOUND NOTHING. ESTABLISHED CORNER ON LINE WITH THE SE CORNER AND E 1/4 CORNER OF SECTION 1 UNION TOWNSHIP AT RECORD DISTANCE.

(c) Was the corner reestablished through acceptance of (1) an obliterated evidence location, or, (2) a found perpetuated location?

CORNER WAS ACCEPTED THROUGH ACCEPTANCE OF OBLITERATED EVIDENCE LOCATION. THE CORNER WAS PLACED AT RECORD DISTANCE ON LINE WITH THE SE CORNER OF SECTION 1 AND THE EAST QUARTER CORNER OF SECTION 1, UNION TOWNSHIP.

(d) Describe any material discrepancy between the location of the corner as restored or reestablished and the location of that corner as previously restored or reestablished by distance and direction. Show the discrepancy on the plan view drawing under (a) above.

NONE

(e) Was the corner reestablished through lost corner proportionate methods?

NO

