

Paper weight-110# (minimum)

Black nonfading ink required

U.S. PUBLIC LAND SURVEY MONUMENT RECORD

For Public Land Survey Corners In:
T. 4 N. R. 12 E. 4th P.M.

WI ADMINISTRATIVE CODE A-E 7.08 REQUIREMENT
REV 10/23/2004 USMONREC.DWG

CORNER CODE INDEX

A	1	2	3	4	5	6	7	8	9	10	11	12	13	14	15	16	17	18	19	20	21	22	23	24	25	A
B																										B
C																										C
D																										D
E																										E
F																										F
G																										G
H																										H
J																										J
K																										K
L																										L
M																										M
N																										N
O																										O
P																										P
Q																										Q
R																										R
S																										S
T																										T
U																										U
V																										V
W																										W
X																										X
Y																										Y
Z																										Z

PORTER TWP

ROCK COUNTY WI

IF AVAILABLE
ROCK COUNTY COORDINATES PREFERRED

North _____ Elev. _____

East _____

Hor. Datum _____ Vert. Datum _____

LATITUDE _____ ELLIPS. HT. _____

LONGITUDE _____

NAD83(91) _____ NETWORK ADJ. YR _____

GPS (X) _____ TRAVERSE (X) _____

BASED ON THE FOLLOWING CONTROL:

PLACE MONUMENT SYMBOL AT PROPER LOCATION ON ABOVE INDEX

CORNER MONUMENT

WITNESS MONUMENT

BEARINGS ARE BASED ON: _____

FIELD BOOK _____ PAGE # _____

SHEET 1 OF 3

SHOW A PLAN VIEW DRAWING DEPICTING THE CORNER MONUMENT AND SURROUNDING PHYSICAL FEATURES, INCLUDING THE EXCAVATION AREA AND DEPTH.

PLANNING & ZONING COMMITTEE ADOPTED THIS FORM ON 12/2/1982

CORNER CODE N-7

PO564

N1/4CORSEC20

(B) Describe any record evidence, monument evidence, occupational evidence, testimonial evidence or any other material evidence you considered, and whether the monument was found or placed.

- 1833 HARRISON (NOV 4RD) T4N R11E 4TH MER. EAST ON
RANDOM BET. 17 & 20
297.0 LEAVE TIMBER & ENTER PRAIRIE
2640.0 TEMPY 1/4 SEC COR
5289.90 INT. E BDY 33.00' NORTH OF POST LAND
MOSTLY ROLLING 1ST RATE PRAIRIE-GROWTH
GRASS & WEEDS
WEST COR. WEST BET 17 & 20
2644.95 QUARTER SEC COR {SET POST & RAISED A
MOUND OF EARTH & SOD
5289.90 SEC COR
- 1853 STEBBINS TWP RD BK1 PG 5 BEGINNING AT A POINT ON
THE HIGHWAY LEADING WESTERLY FROM JOHN BOYCES
ACROSS SECTIONS 22,21,20 & 29 WHERE THE NORTH &
SOUTH CENTER LINE OF SECTION 20 INTERSECTS THE
SAME; THENCE NORTH ON THE CENTER LINE OF SEC 20,
541.2' TO THE 1/4 POST ON THE NORTH LINE OF SEC 20;
THENCE NORTH ON THE CENTER LINES OF SECTIONS 17 &
8 & 5 TO THE 1/4 POST ON THE NORTH LINE OF SEC 5 T4N
R11E AND THE WHOLE LENGTH OF THE ROAD IS 3 MILES
541.2'. COURSES GIVEN ACCORDING TO THE TRUE
MERIDIAN. VARIATION OF NEEDLE 7 3/4 H. STEBBINS-
SURVEYOR
- 1895 BROWN VOL 2 PG 496 SET HH 16X10X9 1320.66 TO
SANDSTONE 24X7X4 SURROUNDED 4 HH @ W 1/16TH COR
OF SE 1/4 SEC 17, 2641.32 TO HH 16X12X24
SURROUNDED BY 4 HH @ CENTER OF SEC 17. CORNER
USED TO SUBDIVIDE SEC 17.
- 1970 WIDOT GTH M #13069 STATES NOTHING ABOUT MON. USED
COR.
- 1977 BARNES VOL 5 PG 273 DUG & FD STONE OF RECORD HH
15X12X10 2' DEEP. SET ALUM. & REFERENCED SAME.
SHORT PK TIES. 10.00 TO THE NW & NE. @ CENTER OF SEC
20 DUG & FD NOTHING
- 1978 THOM CSM VOL 8 PG 212 FD ALUM. N00-08-30E 2633.38
TO SET IP @ CENTER OF SEC 17, FROM CENTER TO ALUM @
N 1/4 COR SEC 17 IT IS N00-09-30E 2665.61
- 1994 KARNs CSM VOL 17-215 FD ROCK COUNTY ALUM. MON
- 1994 KARNs CSM VOL 18 PG 28 ROCK COUNTY MON.
- 2003 COMBS CSM VOL 26 PG 221 ALUM. N89-33-44E 2705.28
TO PK @ NE COR SEC 20
- 2003 KARNs #14565 FD ROCK COUNTY SEC COR. N00-09-08E
TO CENTER OF SEC 17
- 2005 LATHROP CSM VOL 28 PG 260 ALUM S89-33-44E 2705.28
TO PK @ NE COR SEC 20, S00-25-05E TO FD RR SPIKE @
CENTER OF SEC 20
- 2005 LATHROP CSM VOL 28 PG 263 FD ALUM
- 2005 COMBS #15163 FD ALUM MON S89-21-09E 1344.08 TO FD
HARD HEAD STONE, FROM HARD HEAD S89-46-09E
1361.22 TO FD PK @ THE NE COR SEC 20

FD ALUM. MON. 0.1 DEEP. ALL 1977 REF. MONUMENTS ARE
DESTROYED. THERE IS NO E/W FENCE LINE OR TREE LINE ON THE
EAST SIDE OF THE RD. MON IS 4.5' EAST OF THE CENTER OF THE
PVMT.

SHEET 1 OF 3
CORNER CODE N-7

Donald Barnes
6-09-2009

PO564 N1/4CORSEC20

C) Was the corner restored through acceptance of (1) an obliterated evidence location, or, (2) a found perpetuated location?

ACCEPTED FD ALUM.

D) Describe any material discrepancy between the location of the corner as restored or reestablished and the location of that corner as previously restored or reestablished by distance and direction. Show the discrepancy on the plan view drawing under (a), above. Show the distances between the corner as previously restored or reestablished and (1) the corner as restored or reestablished, and (2) to at least 4 of the witness monuments shown on the drawing in (a), above.

(E) Was the corner reestablished through lost corner proportionate methods? If so, show the method, including the directions and distances to other public land survey corners used as evidence or used for proportioning the corner location.



I, **Donald Barnes**, hereby certify that the corner location as identified by the corner code index was determined by me under my direction and control and that this U.S. Public Land Survey Monument Record is correct and complete to the best of my knowledge and belief.

Seal
Donald
Barnes
6-09-09

SHEET 2 OF 3

CORNER CODE N-7

A.E. 7.08 REQUIREMENT

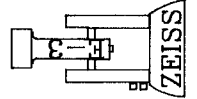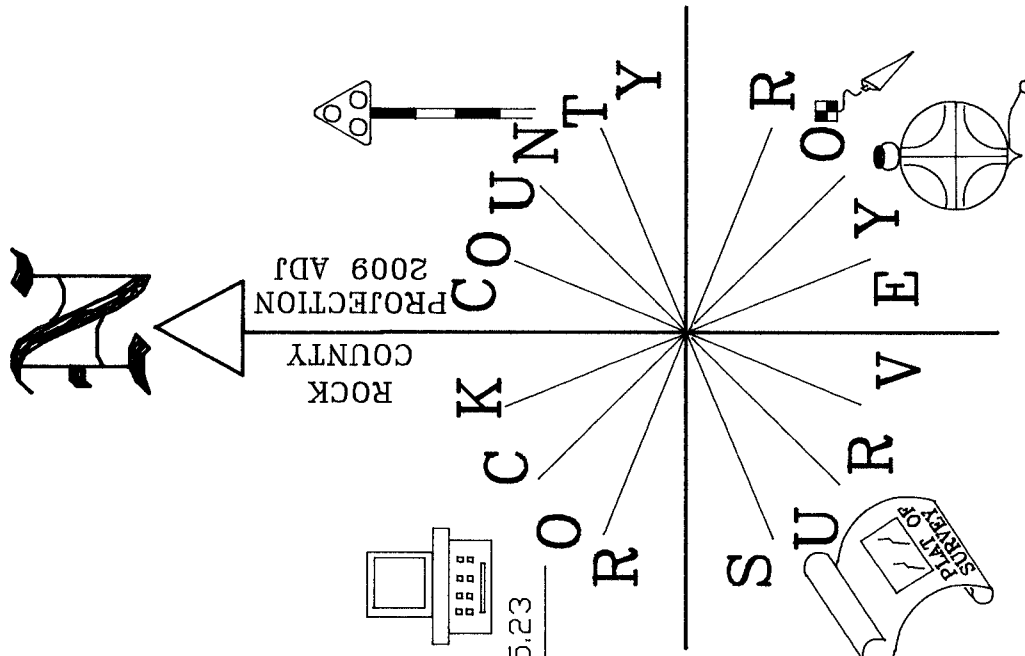

OBSERVATION SHEET #564

NOT TO SCALE

1977 BARNES VOL 5 PG 273
 SET 3/4X24 REROD
 ALL REC MONUMENTS
 ARE GONE.
 ◇ FD ALUM MON 0.1' DEEP
 2005 LATHROP CSM VOL 28 PG 260

WILDER
 RD

S70-26-08E 71.54
 S55-45-48E 41.72

S 1/4 CDR
 SEC 17
 PORTER TWP
 T4N R11E

CSM S89-33-44E 295.23

S0-53-09E 63.45

S89-09-16E 32.92
 CSM S89-33-44E 33.00

CSM S00-25-05W TO CEN R/R
 FD R/R S0-19-12E 2702.84

CSM S0-25-05E 465.38 TO PRDP CDR

NS-11-12E 155.91

S6-53-28E 156.90

S24-19-12E 127.07

3/4 PIN

EMBOSSED
 SEAL
Barnes
 6-09-09

SHEET 3 OF 3

N-7